

ADDENDA
ADDENDUM No. 1

Date: July 12, 2017
Project: OCHC Satellite Pharmacy
Project Number: 16-013
Owner: Oneida Nation
Architect: Oneida Engineering Department
N7332 Water Circle Place
Oneida, WI 54155
To: Invited Bidders

This Addendum forms a part of the Contract Documents and modifies the Request For Proposals dated June 29, 2017, with amendments and additions noted below.

Acknowledge receipt of this Addendum on the completed Proposal Form.

This Addendum consists of 1 typed pages including this sheet and the following attachments:

Pre-Proposal Conference sign-in sheet 1 page

CHANGES TO PROJECT SCOPE Document:

| | Specification Section | Page No. | Paragraph No. | Description of Revision |
|----|-----------------------|----------|---------------|---|
| 1. | Division 9 - Finishes | 6 | 11.1.1 | Replace with: "Floors: existing epoxy to remain, patch as required by demolition and new work." |
| 2. | Division 9 - Finishes | 6 | 11.1.2 | Replace with: "Base: 4" Vinyl on new wall. Existing epoxy base to remain on existing walls." |
| | | | | |

ONEIDA TRIBE OF INDIANS OF WISCONSIN
ENGINEERING DEPARTMENT
N7332 Water Circle Place
Oneida, WI 54155
(920) 869-1600
(920) 869-1610 FAX

DATE 7/11/17
CLIENT _____
PROJECT OCHC - SATELLITE RX
PROJECT NO. 16-013
BY _____ PAGE ____ OF ____

SIGN-IN SHEET

NAME

GARY KRUGER

Don Roarty

Jeff Krambach

Barry Christenson

Dave LeMay

Paul Rose

Sara Busko

Mike Baul

JED VANDENLAUBERGER

CHAD GRUNWALD

PHIL STEINHOFFER

RICK GEURTS

PAUL WITEK

DAVID LARSON

JIM POELS

KATHY DANFORTH

JEREMY VANDEHEI

PRE PROPOSAL WALK-THRU

COMPANY

JIM CORNELL PLUMBING

Dimension IV

CLS

HJ Martin

TGHS clare.lemay@twetgrot.com

G-BAB

DTIE

Commercial Interiors

COMMERCIAL INTERIORS

CURRENT ELECTRICAL SERVICES

HURCKMAN MECH

RE GENERAL CONT

ONEIDA ENGINEERING

OCHC

OCHC - PHARMACY

OCHC - PHARMACY

AJRCC MAINTENANCE

**REQUEST FOR PROPOSALS
For**

OCHC Satellite Pharmacy

Project Number: 16-013

June 29, 2017



See paragraph 5.2 for required submittal deadline.

**ONEIDA NATION
Engineering Department
P.O. Box 365
Oneida, Wisconsin 54155**

TABLE OF CONTENTS

| | |
|---|----------|
| 1. INTRODUCTION..... | 3 |
| 2. BACKGROUND INFORMATION..... | 3 |
| 3. DESCRIPTION OF PROJECT | 3 |
| 4. SCOPE OF SERVICES..... | 4 |
| 5. SUBMITTAL REQUIREMENTS..... | 4 |
| 6. SELECTION PROCEDURE..... | 4 |
| 7. CONTRACT REQUIREMENTS | 5 |
| 8. SCHEDULE | 6 |
| 9. APPENDIX..... | 7 |
| 9.1 Oneida Nation Modifications to AIA Document A141-2014 | |
| 9.2 #16-013 Project Scope document | |
| 9.3 Proposal Form | |

1. INTRODUCTION

- 1.1. The ONEIDA NATION, Selection Committee hereby requests Proposals from qualified firms to provide Design/Build services for the proposed *OCHC Satellite Pharmacy*. Upon receipt of the Proposals the Selection Committee will review statements and select a firm based upon the selection procedure identified in section six of this RFP.
- 1.2. The Selection Committee consists of the following individuals: Senior Tribal Architect, the project manager, DPW - Facilities Representatives, and representatives of the ultimate occupants of the project.
- 1.3. Questions regarding this RFP should be directed to the appropriate individual listed below, prior to the submittal date.
 - 1.3.1. Paul J. Witek, AIA - Senior Tribal Architect at 920-869-4543 or pwitek@oneidanation.org.

2. BACKGROUND INFORMATION

- 2.1. TENANT DESCRIPTION: The Oneida Community Health Center (OCHC) provides the highest quality, holistic health care to improve the health and wellness of the Oneida Community. All services are continually monitored and evaluated to permit the organization to meet the demands of the community's growth. New services, technology, equipment, and customer demand are continually being considered to support advanced and continuous quality health service for the Oneida Community. The Pharmacy provides services under the management of the OCHC. A full team of Registered Pharmacists, Pharmacy Technicians and Pharmacy Registration & Clerk personnel are utilized to service the pharmacy needs.
- 2.2. The Pharmacy is expanding existing services to the Anna John Resident Centered Care Community (AJRCCC) and providing different options for fulfilling current needs at the pharmacy.

3. DESCRIPTION OF PROJECT

- 3.1. GENERAL DESCRIPTION: The project will construct a satellite pharmacy space within the AJRCCC in what is now storage area. The new space will be a fully functional pharmacy with specific tasks that support the main pharmacy at OCHC. Modifications to the existing building systems will be needed to accommodate the new use of the remodeled space.
- 3.2. BUILDING DESIGN REQUIREMENTS: denoted in the Project Scope document included in Appendix.

3.3. SITE LOCATION: The project is located within the Anna John Resident Centered Care Community (AJRCCC) at 2901 S. Overland Road, Oneida, WI.

4. SCOPE OF SERVICES

4.1. Denoted in the Project Scope document included in Appendix.

5. SUBMITTAL REQUIREMENTS

5.1. Complete the Proposal Form included in the Appendix.

5.2. Your electronic submittal (PDF format) shall be e-mailed no later than (3:30 pm, CDT) on July 21, 2017. Submittals shall be e-mailed to:

Fawn Cottrell, Contract Processor
fcottrel@oneidanation.org

And

Paul J. Witek, Senior Tribal Architect
pwitek@oneidanation.org

6. SELECTION PROCEDURE

6.1. The completed Proposal Forms will be reviewed for completeness to determine if all submission requirements were met. Failure to submit complete documents may result in the Proposal being rejected. In the event that all Proposals are judged incomplete, the ONEIDA NATION reserves the right to select the Proposal which in its opinion most nearly meets all the requirements of this Request for Proposals.

6.2. The completed Proposal Forms will be reviewed and scored by each Selection Committee member. The criteria for scoring are based upon the submittal requirements identified in paragraph 6.3. The highest scoring firm will be invited to begin the contract award process.

6.2.1. In the event the Selection Committee does not have consensus that the high scoring firm is the appropriate choice, then the Oneida Nation reserves the right to invite the two or three highest scoring firms to be interviewed by the Selection Committee.

6.3. The criteria for scoring are based upon the submittal requirements identified on the Proposal Form with the following relative importance of the criteria:

| Criteria | Weighted Maximum Score |
|--|-------------------------------|
| Proposal Form properly completed | 15 |
| Proposed Project Team | 15 |
| Experience with Oneida Nation | 10 |
| Related experience of Design-Build firm | 25 |
| Indian Preference <ul style="list-style-type: none"> - Percentage of employees who are enrolled members - Percentage of work by certified Indian-Owned companies - Lead Firm certified Indian-Owned - Past Performance on compliance with law of Lead Firm | 25 |
| Design-Builder GMP | 50 |
| Total Possible Score: | 140 |

6.4. All firms submitting Proposals will receive a summary of the scoring results.

7. CONTRACT REQUIREMENTS

7.1. The selected firm will execute a modified AIA Document A141-2014 Standard Form of Agreement Between Owner and Design-Builder with a Guaranteed Maximum Price (GMP). The modifications to the standard document are included in the Appendix.

7.2. The firm selected for this contract will be required to obtain an Oneida Vendor's License, prior to being given notice to proceed with the work. The annual fee for the license is due upon application, contact the Oneida Licensing Department at 920-496-5311.

7.2.1. An Oneida Vendor's License is not required for submission.

7.3. Oneida Indian Preference Law; basically this law requires contracts entered into by the Oneida Nation must apply Indian Preference for goods and services. Preference is intended to give an advantage to Indian-owned companies and Native American employees in contracting. It is our practice to include Indian Preference as one of the scored selection criteria. Firms utilizing Indian-owned consultants, employing tribal members, and/or Indian-owned firms will receive scores in the Indian Preference category.

7.3.1. The firm selected for this contract and all Contractors, regardless of tier, are subject to the Oneida Code of Laws, Chapter 502 - Indian Preference in Contracting Law. Law is available for download on the Oneida Nation website (<https://oneida-nsn.gov/government/register/laws/>).

8. SCHEDULE

8.1. The following schedule shall be used for this solicitation (subject to change due to required approvals):

| | |
|---------------|---|
| June 29, 2017 | Request for Proposals (RFP) issued. |
| July 21, 2017 | Proposals due at Oneida Engineering Department. |
| July 28, 2017 | Notification to firms of selection. |
| Aug. 25, 2017 | Selected firm to receive signed contract and can begin design work. |

9. APPENDIX

Oneida Nation – Modifications to:

AIA Document A141 – 2014

Standard Form of Agreement Between Owner and Design-Builder

Revised: March 15, 2017

- D.1 In the event of any inconsistency between this Exhibit and any other provision of this Agreement, this Exhibit shall control.
- D.2 Retyping the entire standard document will not be allowed. The standard form may be modified by striking out language and adding underlined new language directly on the pre-printed form or in an exhibit listed under Section 16.1.6.
- D.3 Change Section 1.1.11 by adding the word “significant” prior to the word “change”.
- D.4 Add Section 3.1.3.1.1 to read: “The Project shall be developed using reasonable care and competence in complying with applicable laws, statutes, ordinances, codes, rules and regulations in force as of the date of the agreement, consistent with Wisconsin Rules of Professional Conduct, chapter A-E 8, reference A-E 8.09(1).”
- D.5 Add Section 3.1.3.1.2 to read: “The Project shall be designed and constructed to comply with the Oneida Code of Laws, Chapter 66 - Building Code. As such, the Design-Builder shall use professional standard of care to ensure compliance with said code.”
- D.6 Add Section 3.1.7.1 to read: “The Design-Builder shall schedule, complete application, and submit required documents to the State of Wisconsin for plan approval. Cost of plan review fee shall be a Reimbursable Expense.”
- D.7 Change Section 3.1.10 by deleting the words “Upon the Owner’s written request,” at the beginning of the paragraph and by adding the following to the end of the paragraph “Said certificates shall be submitted to Owner with the final construction document set.”
- D.8 In Section 3.1.14.1 add: “Further, such obligation shall exceed/survive all of the insurance available to the Owner and its agents and employees.” to the end of the paragraph.
- D.9 Add Section 5.4.1 to read as follows:
 - D.9.1 Section IV subparagraph F.3.b of the State of Wisconsin Department of Revenue Publication 207 (10/00), titled Sales and Use Tax Information for Contractors (www.dor.state.wi.us/pubs/00pb207), indicates non-native American contractors may be exempt from Wisconsin State sales tax on certain construction materials delivered to the reservation for use in Tribal projects if Federal Preemption applies. Federal Preemption applies to the Oneida Reservation.
 - D.9.2 It is the Design-Builder’s responsibility to ascertain the applicability of this State publication to this Tribal project. Contractors who are uncertain as to what items are subject to tax, or who require further explanation or clarification, are requested to contact the Wisconsin Department of Revenue.
- D.10 Add Section 5.6.3.1 to read: “Design-Builder shall notify Owner of time frames necessary for selection of materials and equipment under allowance in order not to cause a delay in the Work.”

- D.11 Add Section 5.7.4 to read as follows: "The Design-Builder shall have a qualified superintendent on the project site at all times during the Project while work is being performed. The Owner shall have the right to review the qualifications of Design-Builder's superintendent, including by personal interview, and reject the superintendent at Owner's discretion. Design-Builder will not be entitled to additional compensation for replacing superintendent. Changes to the superintendent during the course of the Project are subject to Owner review per Section 5.7."
- D.12 Delete Section 6.3.9 in its entirety.
- D.13 Add Section 9.2.1 to read as follows: "The schedule of values submitted shall identify the company name of each subcontractor and the subcontract value; this will replace the general description of the individual item of work. Where an item of work is self-performed by the Design-Builder, denote such and organize by CSI Master Format section. Where an item of work has not had a Contractor determined at the time, denote as TBD and organize by CSI Master Format section.
- D.14 Delete Section 9.3.1.1 in its entirety.
- D.15 In Section 9.3.3 delete the words "other than Instruments of Service" in the first sentence.
- D.16 Delete Section 9.4 in its entirety.
- D.17 Delete Section 9.6.1 in its entirety and replace with the following: "The Owner shall make payment of the approved amount, in the manner and within the time provided in the Design-Build Documents."
- D.18 Add Section 9.6.4.1 to read: "With each Application for Payment submit a signed waiver of lien from the Design-Builder and every entity who may be legally entitled to file a mechanic's or other lien against the Work, covering the Work performed during the period covered by the previous Application for Payment."
- D.19 Add Section 9.10.4.4 to read: "Latent defects".
- D.20 Add Section 9.10.6 to read: "Owner will require final waivers of liens from the Design-Builder and every entity who may be legally entitled to file a mechanic's or other lien against the Work, before Final Payment will be made."
- D.21 Add Section 10.1.2 to read: "The Contractor will provide plans for FALLS over six feet, TRENCHING five feet deep or more, protection while in CONFINED SPACES and electrical LOCK AND TAG OUT systems. Plans will include safety equipment and retrieval plan for falls and injuries. All minimum standards for safety compliance can be referenced in 29 CFR 1926 Regulations. Questions related to safety requirements can be directed to the *Oneida Nation Environmental Safety Department*."
- D.22 In Section 10.3.3 delete the words ",including but not limited to attorneys' fees," in the third line.
- D.23 Delete Sections 12.1, 12.2, 12.3, 12.3.1, 12.3.2 in their entirety and replace with the following:

- D.23.1 It is agreed that reproducible Design-Build Documents including Drawings and Specifications, reviewed copies of shop drawings, record drawings and other documents created pursuant to this Agreement by the Design-Builder and the Design-Builder's consultants/subcontractors, including all copyright and other intellectual property, in original form and on electronic media, will be prepared for a specific project and are the property of the Owner on completion and acceptance of the project, or upon termination.
- D.23.2 These documents must be delivered to the Owner as follows: upon project completion, as defined in the description of Record Drawings included in this exhibit; upon termination, 14 days from the date of the notice of termination.
- D.23.3 The Design-Builder shall be permitted to retain original sketches and copies, including reproducible copies of Drawings and Specifications and electronic media for: information, reference, and submittal for design awards programs, publication in books and architectural journals and archiving in museum collections.
- D.23.4 The Owner grants Design-Builder a non-expiring license to use standard details and designs that are incorporated in the Design-Build Documents that the Design-Builder normally uses in its course of business, designing and constructing non-related projects. However, said license does not include use of Oneida cultural iconography or symbols on other projects, without the express written permission of the Owner.
- D.23.5 In the event the Design-Builder's services are terminated prior to completion of construction, the Owner shall indemnify and hold the Design-Builder and Design-Builder's consultants/subcontractors harmless from any costs or claims for damages arising out of use of incomplete documents, any interpretation, revision, alteration or omission to the documents which are not made by the Design-Builder and his consultants. Further, should the Owner reuse the Drawings, Specifications, or other documents, or any part thereof, the seals and certifications of the Design-Builder and Design-Builder's consultants/subcontractors shall be invalid, shall not be used and shall be deleted.
- D.23.6 The Design-Builder shall incorporate the requirements of this Section into all agreements with its design professionals.
- D.24 In Section 13.2.1.1 delete the words "court or other".
- D.25 In Section 13.2.1.3 delete the words "and damages".
- D.26 In Section 13.2.4.3 delete the words "along with reasonable overhead and profit on the Work not executed".
- D.27 In Section 14.1.2 delete the word "binding".
- D.28 Delete Section 14.1.7 in its entirety.
- D.29 In Section 14.2.5 delete the words "and, if the parties fail to resolve their dispute through mediation, to binding dispute resolution".
- D.30 In Section 14.2.6.1 delete the word "binding".

D.31 Delete Section 14.3 in its entirety and replace with the following:

- D.31.1 Any claim, disputes or controversies arising out of, or in relation to the interpretation, application or enforcement of this Agreement shall be initially negotiated between the designated project representatives of both parties.
- D.31.2 If negotiation between designated project representatives does not result in a settlement of the matter, it shall be referred to the president of the design/build firm and the Development Division Director for the Owner, for joint discussion and attempted resolution of the matter.
- D.31.3 Both parties agree that if the matter cannot be resolved by mutual agreement of the principals, the matter will be referred to an alternate dispute resolution process which shall be mediation. Both parties agree that any claim, dispute or other matter in question arising out of or related to this agreement shall not be subject to arbitration. The parties shall endeavor to settle disputes by mediation in accordance with the Construction Industry Mediation Rules of the American Arbitration Association currently in effect. Demand for mediation shall be filed in writing with the other party to this Agreement and with the American Arbitration Association. A demand for mediation shall be made within a reasonable time after the claim, dispute or other matter in question has arisen. In no event shall the demand for mediation be made after the date when institution of legal or equitable proceedings based on such claim, dispute or other matter in question would be barred by the applicable statute of limitations.
- D.31.4 Mediator shall be selected by and mutually agreed to by both parties. The parties shall share the mediator's fee and any filing fees equally.
- D.31.5 The mediation shall be held in the place where the Project is located, unless another location is mutually agreed upon. Mediator shall hear the matter and provide an informal opinion and advice, none of which shall be binding on the parties, but is expected by the parties to help resolve the dispute. Said informal opinion and advice shall be submitted to the parties within twenty (20) days following written demand for mediation.
- D.31.6 Nothing in this contract will be interpreted as a waiver of Owner's sovereign immunity.

D.32 Delete Section 14.4 in its entirety.

D.33 Change Section 15.1 by deleting all the words after "located".

D.34 The Owner and Design-Builder shall jointly reach decisions as to matters relating to desired aesthetic effect. If a decision cannot be made jointly the Owner's decision shall be final.

D.35 There will be no additional services or fees under this Agreement unless authorized in writing by the Owner prior to the commencement of said additional services. All consultants/subcontractors under this Agreement must be authorized in writing by the Owner.

- D.36 The failure of one party to insist upon or enforce, in any instance, strict performance by the other party of any of the terms of this Agreement, shall not be construed as a waiver or relinquishment to any extent of the right to assert or rely upon such terms or right on any future occasion.
- D.37 Design-Builder is required to obtain an Oneida Vendors License from the Owner's Licensing Department. Failure to obtain and maintain said license for the duration of this Agreement shall prohibit Design-Builder from receiving payment for services rendered, until such time as the license is obtained.
- D.38 The Design-Builder and Design-Builder's consultants/subcontractors will comply with the requirements of *Design Standards & Criteria for Sovereign Oneida Nation of Wisconsin, Engineering Department* as supplied by the Owner.
- D.39 The Design-Builder is obligated by the requirements of the Oneida Nation's *Indian Preference in Contracting Law*, understands its provisions and its bearing on the Design-Builder's rights and responsibilities, and agrees that such provisions shall govern the Design-Builder's performance of the contract.
- D.39.1 Design-Builder shall require all consultants/Subcontractors to comply with the provisions of this article by insertion of the requirements hereof in a written contract agreement between Design-Builder and consultant/Subcontractor.
- D.40 In addition to the services denoted within the Design-Build Documents, the Design-Builder shall provide the following services:
- D.40.1 Storm Water Management: The Design-Builder shall provide erosion control plan, and storm water management plan. Design-Builder shall also prepare a storm water Operations and Maintenance Plan as described in SPS 382.36(13).
- D.40.2 GSA Pricing: The Design-Builder will investigate if selected materials and products are available under the U.S. General Services Administration (GSA) Schedules. Materials and products available with this pricing structure will be identified and the Owner notified. The Design-Builder will compare the GSA pricing to the Design-Builder's pricing and provide the Owner with a report listing the materials and products; and their respective pricing.
- D.40.3 Record Drawings, the Design-Builder shall prepare Record Drawings which incorporate all changes to the Work after issuance of the Construction Documents, including, but not limited to: addendum, change orders, field orders, sketches and clarifications. Incorporation of these changes shall be made part of Record Drawings and not by referencing other documents. The Record Drawings shall be recorded on electronic media in the format of AutoCAD to be delivered to the Owner as part of the project closeout. Delivery shall be within sixty (60) days of the date of Substantial Completion. Deliverables shall be: two sets of Record Drawings (paper) and one set of electronic media. The Owner will own all copyright and other intellectual property rights of the Record Documents and electronic media. The fee for this service will be billed on an hourly basis for which the fee will not exceed: \$_____."
- D.40.4 Eleven Month Walk-thru: The Design-Builder shall schedule with the Owner, a walk-thru of the project at eleven months after Substantial Completion to identify

items requiring correction prior to the warranty expiration. Items identified shall be denoted in a punch list document to be delivered to the Owner and promptly addressed by the Design-Builder.

D.41 Modifications to AIA Document A141 – 2014 Exhibit A Design-Build Agreement, are as noted below:

D.41.1 Add Section A.1.4.3.2.1 to read: "For Changes in the Work under Article 6, Change Orders that include an adjustment to the Contract Sum, the markup for overhead and profit included in the total cost shall not exceed one of the following:

D.41.1.1 For Work performed by the Design-Builder's own forces, maximum _____ percent of the cost.

D.41.1.2 For Work performed by the Design-Builder's Subcontractor, maximum _____ percent of the cost."

D.41.2 Add Section A.5.1.4.2.1 to read: "Rental charges on tools and equipment shall stop when the market value of the tool or equipment have been paid by the Owner. No further rental charges will be paid by the Owner after the market value threshold is reached."

D.41.3 Delete Section A.5.1.5.8 in its entirety."

D.41.4 In Section A.5.1.6.3 delete the words "or nonconforming" in two places, and the words "or correction".

D.41.5 Add Section A.5.5.1 to read as follows:

D.41.5.1 "RIGHT OF AUDIT PROVISIONS: The following elements of this provision apply only to work under and in compliance with this agreement.

D.41.5.2 Design-Builder's records which shall include but not be limited to accounting records (hard copy, as well as computer readable data if it can be made available), written policies and procedures; subcontract files (including proposals of successful and unsuccessful bidders, bid recaps, etc.); original documentation covering negotiated settlements); back charge logs and supporting documentation; general ledger entries detailing cash and trade discounts earned, insurance rebates and dividends; and any other supporting evidence deemed necessary by the Owner to substantiate charges related to this contract (all foregoing hereinafter referred to as "records") shall be open to inspection and subject to audit and/or reproduction by Owner's agent or its authorized representative to the extent necessary to adequately permit evaluation and verification of (1) compliance with contract requirements, (2) proper pricing of time and materials and change orders, (3) compliance with Owner's Business Ethics policies, and (4) claims submitted by the Design-Builder or any of his payees pursuant to the execution of the contract.

- D.41.5.3 Such audits may require inspection and copying from time to time and at reasonable times and places of any and all information, materials and data of every kind and character, including without limitation, records, books, papers, documents, subscriptions, recordings, agreements, purchase orders, bids, leases, contracts, commitments, arrangements, notes, daily diaries, superintendent reports, drawings, receipts, vouchers and memoranda, and any and all other agreements, sources of information and matters that may in Owner's judgment have any bearing on or pertain to any matters, rights, duties or obligations under or covered by any Contract Document. Such records subject to audit shall also include, but not be limited to, those records necessary to evaluate and verify direct and indirect costs, (including overhead allocations) as they may apply to costs associated with this contract.
- D.41.5.4 The Owner or its designee shall be afforded access to all of the Design-Builder's records, and shall be allowed to interview any of the Design-Builder's employees, pursuant to the provisions of this article throughout the term of this contract and for a period of three years after final payment or longer if required by law.
- D.41.5.5 Design-Builder shall require all subcontractors to comply with the provisions of this article by insertion of the requirements hereof in a written contract agreement between Design-Builder and payee. Such requirements will also apply to Subcontractors and Sub-Subcontractors (including those entering into lump sum subcontracts) to cooperate fully in furnishing or in making available to Owner from time to time whenever requested in an expeditious manner any and all such information, materials and data.
- D.41.5.6 Owner's agent or its authorized representative shall have access to the Design-Builder's facilities, shall be allowed to interview all current or former employees to discuss matters pertinent to the performance of this contract, shall have access to all necessary records, and shall be provided adequate and appropriate work space, in order to conduct audits in compliance with this article.

D.42 Modifications to AIA Document A141 – 2004 Exhibit B Insurance and Bonds, are as noted below:

- D.42.1 Add Section B.4.1 to read: "Design-Builder and all subcontractors shall indemnify and hold harmless the Owner, its affiliates, officers, directors, employees, and agents of each, from and against any and all losses, payments, claims, damages, liabilities, obligations, penalties, judgments, awards, costs, expenses, interest or damages (including settlement), including court costs and reasonable attorney's fees, of whatever nature, for injuries, losses, or damages arising out of Design-Builder, subcontractors, officers, directors, employees, or agents performance of services under this Agreement."
- D.42.2 Add Section B.4.2 to read: "Per Exhibit E - Oneida Nation – Insurance Requirements, Design-Builder Insurance."

OCHC Satellite Pharmacy
Oneida Project No. 16-013

June 29, 2017



Project Scope

ONEIDA NATION
Engineering Department
P.O. Box 365
Oneida, Wisconsin 54155

Table of Contents

| | | |
|-----|--|---|
| 1. | Project Description..... | 3 |
| 2. | Design..... | 3 |
| 3. | Division 0 & 1 – General Requirements | 3 |
| 4. | Division 2 – Existing Conditions..... | 5 |
| 5. | Division 3 – Concrete..... | 5 |
| 6. | Division 4 – Masonry | 5 |
| 7. | Division 5 – Metals | 5 |
| 8. | Division 6 – Wood, Plastics, and Composites..... | 5 |
| 9. | Division 7 – Thermal and Moisture Protection | 5 |
| 10. | Division 8 – Openings | 5 |
| 11. | Division 9 - Finishes | 6 |
| 12. | Division 10 – Specialties | 6 |
| 13. | Division 11 – Equipment | 6 |
| 14. | Division 12 – Furnishings..... | 6 |
| 15. | Division 21 – Fire Suppression | 6 |
| 16. | Division 22 – Plumbing | 6 |
| 17. | Division 23 – HVAC | 6 |
| 18. | Division 26 – Electrical..... | 7 |
| 19. | Division 27 – Communications..... | 7 |
| 20. | Division 28 – Electronic Safety and Security | 7 |
| 21. | Division 31 – Earthwork | 7 |
| 22. | Division 32 – Exterior Improvements..... | 7 |
| 23. | Appendices..... | 7 |

Scope of Work

1. Project Description

- 1.1. The project will construct a satellite pharmacy space within the Anna John Resident Centered Care Community (AJRCCC) facility in what is now storage area. The new space will be a fully functional pharmacy with specific tasks that support the main pharmacy at the Oneida Community Health Center (OCHC). Modifications to the existing building systems will be needed to accommodate the new use of the remodeled space.
- 1.2. Detailed scope items are noted in the remainder of this document.

2. Design

- 2.1. All work shall conform to the *Design Standards & Criteria for Oneida Nation*, included in the Appendix.
- 2.2. Contractor shall review the concept documents provided by Owner for compliance to building code and review any required changes with the Owner.
- 2.3. Contractor shall prepare Construction Documents for the project to the extent necessary to define the scope of work to allow review by permitting agencies. Construction Documents shall be reviewed with Owner prior to submittal for permits. Design shall be provided for:
 - 2.3.1. Architectural & Structural
 - 2.3.2. Plumbing
 - 2.3.3. HVAC
 - 2.3.3.1. DDC Controls
 - 2.3.4. Electrical
 - 2.3.4.1. Fire Alarm
 - 2.3.4.2. Access Control
- 2.4. Record Drawings will be required for completed project. Documents of all disciplines will be required.
- 2.5. Original design documents of project area are available to Contractor (in AutoCAD formats). Some of the drawings are included in the Appendix.

3. Division 0 & 1 – General Requirements

- 3.1. All work shall conform to the Oneida Code of Laws, Chapter 603 – Building Code and Chapter 605 - Zoning and Shoreland Protection, NFPA, DHS and other codes pertinent to the facility.

- 3.1.1. The Oneida Building Code incorporates by reference the State of Wisconsin Commercial Building Codes and the Uniform Dwelling Code.
- 3.1.2. Codes are available for download on the Oneida Nation website (<https://oneida-nsn.gov/government/register/laws/>).
- 3.2. Contractor shall obtain all required permits from the Oneida Zoning Department.
- 3.3. All Contractors, regardless of tier, are subject to the Oneida Code of Laws, Chapter 502 - Indian Preference in Contracting.
 - 3.3.1. Codes are available for download on the Oneida Nation website (<https://oneida-nsn.gov/government/register/laws/>).
- 3.4. The awarded contractor is required to obtain an Oneida Vendor's License, prior to finalizing the contract for the work (if they do not currently hold a vendor's license). The annual fee for the license is due upon application; contact the Oneida Licensing Department at 920-496-5311.
 - 3.4.1. An Oneida Vendor's License is not required for submission of a bid.
- 3.5. Performance and Payment Bonds are NOT required for this project.
- 3.6. Wage Rates – Davis-Bacon wage rates do NOT apply to this project. Wage rates apply to workers hired from the Oneida Skills Bank workers (as required by the Chapter 502 - Indian Preference in Contracting) shall be paid according to the Wage Rate Determination established by the Indian Preference Office. Wage rates for workers not from the Oneida Skills Bank shall be determined by the normal salary practices of the Contractor.
- 3.7. Contractor shall provide a Gant chart schedule for the project and keep it current throughout the duration of the project.
- 3.8. Contractor shall provide a Schedule of Values identifying, at a minimum, the following items (all requests for payments shall identify these items and their percentage complete at the time of the request for payment):
 - 3.8.1. General Conditions
 - 3.8.2. Concrete
 - 3.8.3. Masonry
 - 3.8.4. Framing
 - 3.8.5. Doors & Windows
 - 3.8.6. Finishes
 - 3.8.7. Equipment
 - 3.8.8. Fire Protection
 - 3.8.9. Plumbing

- 3.8.10. HVAC Systems
- 3.8.11. Electrical Systems

4. Division 2 – Existing Conditions

- 4.1. Bulk demolition, no work anticipated.
- 4.2. Contractor will be responsible for selective demolition including, but not limited to demolition of:
 - 4.2.1. Items noted on Preliminary Sketches
 - 4.2.2. Electrical – removal of existing light fixtures
- 4.3. All material removed by Contractor shall be properly dispose of off-site.

5. Division 3 – Concrete

- 5.1. Remove and patch existing concrete floor slab as required by installation of new plumbing at new sink

6. Division 4 – Masonry

- 6.1. Patch existing as required by any new penetrations. Maintain one hour fire and smoke partition.

7. Division 5 – Metals

- 7.1. No work anticipated.

8. Division 6 – Wood, Plastics, and Composites

- 8.1. Items noted on Preliminary Sketches.
- 8.2. Patch existing walls as required in all areas impacted by demolition.
- 8.3. Provide required rough and finish carpentry.
- 8.4. Provide plastic laminate casework.

9. Division 7 – Thermal and Moisture Protection

- 9.1. Provide sealant as required.

10. Division 8 – Openings

- 10.1. Contractor responsible for door and hardware as noted on Preliminary Sketches.

11. Division 9 - Finishes

11.1. Contractor responsible for all new construction finishes as noted below:

11.1.1. Floors: sealed concrete.

11.1.2. Base: 4" Vinyl.

11.1.3. Walls: Painted full height around perimeter of room 2012 and new wall on room 2008 side.

11.1.4. Ceiling: paint existing gypsum board.

11.1.5. Paint any new exposed MEP items.

11.2. New wall shown on floor plan are constructed as Wall Type 8 as denoted on the existing Drawings. Top of walls terminate at underside of existing roof structure above (existing structure is approximately 11'-9" above floor).

12. Division 10 – Specialties

12.1. Install toilet accessories (paper towel dispenser) supplied by Owner.

13. Division 11 – Equipment

13.1. No work anticipated.

14. Division 12 – Furnishings

14.1. No work anticipated.

15. Division 21 – Fire Suppression

15.1. Modify existing fire suppression system as required by new room configuration.

16. Division 22 – Plumbing

16.1. Contractor shall design and install modifications to the existing Plumbing system as required by the new faucet and sink in room 2012. See existing drawings for location of existing sanitary sewer pipe to west of sink location.

16.2. Faucet: goose neck. Sink: 25"x22"x8" min. stainless steel drop-in.

17. Division 23 – HVAC

17.1. Contractor shall design and install modifications to the existing HVAC system as required by the new room configuration.

17.2. Provide VAV serving new room with proper air flow for occupied space.

17.3. Modify existing DDC controls as required by modifications to system.

18. Division 26 – Electrical

18.1. Contractor shall design and install modifications to the existing Electrical system as required by the new room configuration.

18.2. Items noted on Preliminary Sketches.

19. Division 27 – Communications

19.1. Contractor shall supply and install conduit, wall boxes and voice & data cabling. Termination of cabling into existing system. See existing drawings for location of existing data headend equipment.

20. Division 28 – Electronic Safety and Security

20.1. Access control connection (palm reader) at Dutch door by Owner. Contractor to provide electric strike, power and data wiring to reader location.

20.2. Video surveillance and security system installation by Owner.

20.3. Contractor shall design and install modifications to the existing Fire Alarm system as required by the reconfiguration of room.

21. Division 31 – Earthwork

21.1. No work anticipated.

22. Division 32 – Exterior Improvements

22.1. No work anticipated.

23. Appendices

23.1. *Design Standards & Criteria for Oneida Nation*

23.2. Preliminary Sketches

23.3. Existing building construction documents



DESIGN STANDARDS & CRITERIA

For

ONEIDA NATION

Engineering Department

(Revised: 05/05/17)

TABLE OF CONTENTS

| | | |
|---|--------------------------|-----------|
| 1. PREFACE | REVISED: 02/20/12 | 4 |
| 2. GENERAL ISSUES (NON-TECHNICAL) | | 4 |
| 2.1. CONTRACT DOCUMENTS | REVISED: 09/07/12 | 4 |
| 2.2. DESIGN PROCEDURES | REVISED: 12/17/15 | 5 |
| 3. FACILITY & TECHNOLOGY FEATURES | | 6 |
| 3.1. DESIGN ELEMENTS | REVISED: 12/17/15 | 6 |
| 3.2. SPECIFICATION ELEMENTS | REVISED: 02/20/12 | 7 |
| DIVISION 00 - PROCUREMENT AND CONTRACTING REQUIREMENTS | | 8 |
| 00 11 00 INVITATION TO BID | REVISED: 11/18/13 | 8 |
| 00 21 00 INSTRUCTIONS TO BIDDERS | REVISED: 12/17/15 | 8 |
| 00 22 00 SUPPLEMENTARY INSTRUCTIONS | REVISED: 10/06/06 | 9 |
| 00 31 00 AVAILABLE PROJECT INFORMATION | REVISED: 10/06/06 | 9 |
| 00 41 00 BID FORM | REVISED: 02/20/12 | 9 |
| 00 52 00 AGREEMENT | REVISED: 05/05/17 | 9 |
| 00 71 00 GENERAL CONDITIONS | REVISED: 05/05/17 | 10 |
| 00 73 00 SUPPLEMENTARY CONDITIONS | REVISED: 05/05/17 | 10 |
| DIVISION 01 - GENERAL REQUIREMENTS | | 10 |
| 01 11 00 SUMMARY OF WORK | REVISED: 10/18/95 | 10 |
| 01 20 10 SPECIAL PRODUCT PURCHASING PROCEDURES | REVISED: 10/06/06 | 11 |
| 01 23 00 ALTERNATIVES | REVISED: 10/06/06 | 11 |
| 01 31 19 PROJECT MEETINGS | REVISED: 10/18/95 | 11 |
| 01 35 63 SUSTAINABILITY CERTIFICATION PROJECT REQUIREMENTS | REVISED: 01/17/14 | 11 |
| 01 58 00 PROJECT IDENTIFICATION | REVISED: 02/20/12 | 11 |
| 01 74 19 CONSTRUCTION WASTE MANAGEMENT AND DISPOSAL | REVISED: 10/06/06 | 11 |
| 01 78 00 CLOSEOUT SUBMITTALS | REVISED: 12/17/15 | 11 |
| DIVISION 02 – EXISTING CONDITIONS | | 12 |
| DIVISION 03 - CONCRETE | | 12 |
| DIVISION 04 - MASONRY | | 12 |
| 04 05 00 COMMON WORK RESULTS FOR MASONRY | REVISED: 10/06/06 | 12 |
| 04 27 00 MULTIPLE-WYTHE UNIT MASONRY | REVISED: 10/06/06 | 13 |
| DIVISION 05 - METALS | | 13 |
| DIVISION 06 - WOOD AND PLASTIC | | 13 |
| DIVISION 07 - THERMAL & MOISTURE PROTECTION | | 13 |
| 07 27 00 AIR BARRIERS | REVISED: 02/20/12 | 13 |
| 07 50 00 MEMBRANE ROOFING | REVISED: 10/06/06 | 13 |
| DIVISION 08 - OPENINGS | | 13 |
| 08 70 00 HARDWARE | REVISED: 03/21/14 | 13 |
| 08 80 00 GLAZING | REVISED: 02/20/12 | 14 |
| DIVISION 09 – FINISHES | | 14 |
| 09 06 00 SCHEDULES FOR FINISHES | REVISED: 02/20/12 | 14 |
| DIVISION 10 - SPECIALTIES | | 14 |
| 10 28 00 TOILET, BATH, AND LAUNDRY ACCESSORIES | REVISED: 03/23/05 | 14 |
| 10 44 00 FIRE PROTECTION SPECIALTIES | REVISED: 10/18/95 | 14 |
| DIVISION 11 - EQUIPMENT | | 14 |

| | |
|--|-----------|
| DIVISION 12 - FURNISHINGS | 14 |
| DIVISION 13 - SPECIAL CONSTRUCTION | 14 |
| DIVISION 14 - CONVEYING EQUIPMENT..... | 14 |
| 14 20 00 ELEVATORS REVISED: 02/20/12 | 14 |
| DIVISION 21 - FIRE SUPPRESSION | 16 |
| 21 00 00 FIRE SUPPRESSION REVISED: 01/17/14 | 16 |
| DIVISION 22 - PLUMBING | 16 |
| 22 00 00 PLUMBING REVISED: 1/22/16 | 16 |
| DIVISION 23 - HEATING, VENTILATING, AND AIR-CONDITIONING (HVAC)..... | 18 |
| 23 00 00 HVAC REVISED: 12/17/15..... | 18 |
| DIVISION 25 - INTEGRATED AUTOMATION | 20 |
| 25 00 00 INTEGRATED AUTOMATION REVISED: 11/18/13 | 20 |
| DIVISION 26 - ELECTRICAL..... | 21 |
| 26 05 00 COMMON WORK RESULTS FOR ELECTRICAL SYSTEMS REVISED: 12/17/15..... | 21 |
| 26 05 26 GROUNDING AND BONDING FOR ELECTRICAL SYSTEMS REVISED: 12/17/15..... | 22 |
| 26 05 33 RACEWAY AND BOXES FOR ELECTRICAL SYSTEMS REVISED: 12/17/15 | 22 |
| 26 05 53 IDENTIFICATION FOR ELECTRICAL SYSTEMS REVISED: 12/17/15..... | 23 |
| 26 05 73 OVERCURRENT PROTECTIVE DEVICE COORDINATION STUDY REVISED: 12/17/15..... | 23 |
| 26 06 20 SCHEDULES FOR ELECTRICAL DISTRIBUTION REVISED: 12/17/15 | 23 |
| 26 24 00 SWITCHBOARDS AND PANELBOARDS REVISED: 12/17/15 | 23 |
| 26 43 00 TRANSIENT VOLTAGE SUPPRESSION REVISED: 12/17/15 | 24 |
| 26 51 00 INTERIOR LIGHTING REVISED: 12/17/15 | 24 |
| 26 52 00 EMERGENCY LIGHTING REVISED: 12/17/15 | 24 |
| 26 53 00 EXIT SIGNS REVISED: 12/17/15 | 24 |
| 26 56 00 EXTERIOR LIGHTING REVISED: 12/17/15 | 24 |
| DIVISION 27 - COMMUNICATIONS | 26 |
| 27 00 00 COMMUNICATIONS REVISED: 12/17/15..... | 26 |
| DIVISION 28 - ELECTRONIC SAFETY AND SECURITY..... | 26 |
| 28 13 00 ACCESS CONTROL REVISED: 11/18/13..... | 26 |
| 28 16 00 INTRUSION DETECTION REVISED: 10/12/06..... | 26 |
| 28 31 00 FIRE DETECTION AND ALARM REVISED: 11/18/13..... | 26 |
| DIVISION 31 - EARTHWORK..... | 27 |
| 31 09 00 GEOTECHNICAL INSTRUMENTATION AND MONITORING OF EARTHWORK REVISED: 10/06/06 | 27 |
| 31 10 00 SITE CLEARING REVISED: 05/05/17 | 27 |
| 31 20 00 EARTH MOVING REVISED: 12/17/15 | 27 |
| DIVISION 32 - EXTERIOR IMPROVEMENTS..... | 28 |
| 32 10 00 BASES, BALLASTS, AND PAVING REVISED: 02/20/12 | 28 |
| 32 80 00 IRRIGATION REVISED: 10/06/06 | 28 |
| 32 90 00 PLANTING REVISED: 10/06/06 | 28 |
| DIVISION 33 - UTILITIES..... | 28 |
| DIVISION 34 - TRANSPORTATION..... | 28 |
| DIVISION 35 - WATERWAY AND MARINE CONSTRUCTION..... | 28 |
| APPENDIX A | 29 |
| REFERENCED DOCUMENTS LISTING: REVISED: 05/05/17 | 29 |

1. PREFACE *Revised: 02/20/12*

- 1.1. The purpose of this document is to provide criteria for the ongoing planning and design of the ONEIDA NATION's facilities. It contains both generalized issues and specific requirements to be used in the design and construction of new and remodeled facilities.
- 1.2. The information provided in this document will be the basis upon which the ENGINEERING DEPARTMENT will review design documents to insure that the program requirements are being met and that the ONEIDA NATION's design criteria are being followed.
- 1.3. The ENGINEERING DEPARTMENT wants to work with outside consulting firms to ensure that valid engineering criteria are applied while developing solutions to the ONEIDA NATION's building requirements.
- 1.4. The ENGINEERING DEPARTMENT is responsible for and has authority to update/revise these standards and promulgate them to appropriate parties. In addition, the Department has authority to waive any requirement if it deems the waiver beneficial to the Oneida Nation.
- 1.5. Certain portions of these criteria may not apply to your specific project. Any deviations from these criteria shall be approved in writing by the ENGINEERING DEPARTMENT, prior to their incorporation into the design documents.
- 1.6. Consultants having any questions relating to these criteria or requiring additional information should contact their project's PROJECT MANAGER at 920-869-1600.

2. GENERAL ISSUES (non-technical)

2.1. CONTRACT DOCUMENTS *Revised: 09/07/12*

- 2.1.1. PROJECT MANUAL: The manual (specifications) shall be organized utilizing the Construction Specifications Institute MasterFormat 2004 or 2010 edition.
- 2.1.2. PROPRIETARY SPECIFICATIONS: Proprietary specifications sections will NOT be allowed, unless otherwise approved by the Owner. All sections shall list a minimum of two (2) and a maximum of six (6) separate manufacturers/suppliers. In lieu of the multiple manufacturer listing, the section may be written so as to provide a performance specification.
 - 2.1.2.1. An exception to this requirement is that if the product is covered under the GSA Pricing Schedule it may be proprietary specified. Identification that the Owner is eligible for GSA pricing shall be denoted at the individual specification section for the product.
- 2.1.3. DOCUMENTS SUPPLIED TO OWNER:
 - 2.1.3.1. To comply with the Oneida Paper Reduction Policy, all documents (except drawings) submitted to Owner shall be printed two-sided.
 - 2.1.3.2. When the final Project Manual is issued, one copy shall be bound in a 3 ring binder.
 - 2.1.3.3. When final CD drawings are issued, two (2) sets of drawings on half size sheets shall be provided.

- 2.1.4. **PROJECT NUMBER:** The Engineering Department's Project Number shall be noted on all documents prepared, including: letters, memos, estimates, schedules, specifications, construction documents, invoices, etc.
- 2.1.5. **CONSTRUCTION DOCUMENTS:** All documents shall minimize or eliminate the reference to "General Contractor" in notes or specification sections. This GC reference shall be eliminated from the documents if a Construction Manager is involved in the project.
- 2.1.6. **DOCUMENT ISSUE LOG:** All sheets in the set of construction documents shall identify the history of the sheet's issuance. For example, if sheet was issued by Owner DD review, Owner Final review, and Issued for Bidding, all of these issues shall be identified on each sheet with a date. This information can be in the revision portion of the title block.
- 2.1.7. **CODE COMPLIANCE DRAWINGS:** The set of construction documents shall include:
- 2.1.7.1. A Code Compliance Plan which delineates: fire rated walls, smoke partitions, and floor & attic smoke compartments, occupant load of rooms, egress path.
 - 2.1.7.2. Code Compliance Data and Schedules which denote: applicable codes used for design, occupancy classification, construction type, sprinklered or non-sprinklered, smoke/fire detection /alarm systems, number of stories, number of streets, allowable area, occupant load, exit width, plumbing fixture calculations, off-street parking, etc.

2.2. DESIGN PROCEDURES

Revised: 12/17/15

- 2.2.1. **MEETING MINUTES:** The A/E shall take minutes of all meetings at which they are present, and distribute to all attendees and other appropriate individuals.
- 2.2.2. **DESIGN REVIEWS:** At the END of the following phases all departments listed shall review the documents prepared by the Architect. The Owner's Project Manager shall be responsible to coordinate distributing documents to identified departments. The Engineering Department will review all phases and give instructions to the architect to proceed into the next phase after all approvals are received.
- 2.2.2.1. Schematic Design Phase (SD)
 - DPW – Custodial (Space needs)
 - DPW – Facilities (Space needs, DDC Controls, HVAC, electrical)
 - DPW – Groundskeeping (Site Maintenance)
 - DPW – Plumbing (Plumbing)
 - EH&S Division - Conservation (mitigation concerns)
 - EH&S Division – Environmental Quality (storm water management, NEPA coord.)
 - EH&S Division – Health & Industrial Services (Recycling Space, Safety)
 - MIS Department (Space Needs)
 - Planning Department (Site Planning issues)
 - Utilities Department (fire hydrant, water and sewer main materials and connections)
 - Zoning Department (Preliminary Site Plan Review)
 - 2.2.2.2. Design Development Phase (DD)
 - DPW – Custodial (Space needs & finish material selections)
 - DPW – Facilities (Space needs, DDC Controls, HVAC, electrical)
 - DPW – Groundskeeping (Site Maintenance)

- DPW – Plumbing (Plumbing)
- EH&S Division - Conservation (landscape plant materials)
- EH&S Division – Environmental Quality (storm water management, NEPA coord.)
- EH&S Division – Health & Industrial Services (Recycling Space, Safety)
- MIS Department (Space Needs, Kronos, voice & data)
- Planning Department (Site Planning issues)
- Utilities Department (fire hydrant, water and sewer main materials and connections)
- Wells & Septic Department (Preliminary review of systems)
- Zoning Department (Preliminary Site Plan Review)

2.2.2.3. Construction Document Phase (CD)

- Division of Land Management – Real Estate Services (initiate process for easements approval)
- DPW – Custodial (finish material selections)
- DPW – Facilities (DDC Controls, HVAC, electrical)
- DPW – Groundskeeping (Site Maintenance)
- DPW – Plumbing (Plumbing)
- EH&S Division - Conservation (landscape plant materials and planting spec.)
- EH&S Division – Environmental Quality (storm water management, NEPA coord.)
- EH&S Division – Health & Industrial Services (Recycling Space, Safety)
- MIS Department (Kronos, voice & data)
- Planning Department (Site Planning issues)
- Risk Management (Fire Sprinkler System review, Insurance Requirements review)
- Utilities Department (fire hydrant, water and sewer main materials and connections)
- Wells & Septic Department (Review of systems)
- Zoning Department (Preliminary Site Plan Review)

2.2.2.4. Construction Administration (CA)

- 2.2.2.4.1. Pre-Bid conference:
 - Indian Preference Department
- 2.2.2.4.2. Pre-Construction conference:
 - Indian Preference Department
 - EH&S Safety Department

2.2.3. CODE ISSUES: All building designs must comply with the Oneida Code of Laws – Chapter 66 – Building Code (*this code adopts the International Building Code and Wisconsin amendments by reference*) and documents shall be submitted for review, following standard Wisconsin procedures.

3. FACILITY & TECHNOLOGY FEATURES

3.1. DESIGN ELEMENTS

Revised: 12/17/15

3.1.1. Data Rooms: All buildings shall have separate MIS (Management Information Systems) rooms. These functions are not to be combined with mechanical or electrical into one room. MIS room is to contain all telephone and computer network equipment.

3.1.1.1. Walls surrounding these rooms shall extend to underside of structure above and shall be a minimum of one-hour fire rated.

- 3.1.1.2. Provide 3'-0" clear floor area in front of and behind data rack for access and maintenance. Room dimensions shall comply with Owner's *Data Room Configuration Standard*.
- 3.1.1.3. See MEP and Division 27 sections of this document for additional requirements.
- 3.1.2. Entrance Canopies: Design all canopies over doors to ensure there are no drip lines onto walkways leading to door. Preference is to pitch roof to either side of door.
- 3.1.3. Kitchens: where project includes a commercial kitchen, the Construction Documents shall denote the requirement that locations of equipment are to be permanently marked on floor per *NFPA 1 – Chapter 50 Commercial Cooking Equipment*.
- 3.1.4. Knox-Box: Construction Documents shall denote the requirement to provide a Knox-Box key box for the building. Contractor shall coordinate with local fire department to insure compliance with local standards.
- 3.1.5. Mechanical/Electrical Rooms: All buildings shall have separate mechanical, electrical, and Data rooms. These functions are not to be combined into one room.
 - 3.1.5.1. Walls surrounding these rooms shall extend to underside of structure above and shall be a minimum of one-hour fire rated.
 - 3.1.5.2. See MEP sections of this document for additional requirements.
- 3.1.6. Parapet Walls: Do not use on Oneida projects, unless approved by Senior Tribal Architect.
- 3.1.7. Site/Civil: Storm water management systems designed for project shall address water quality concerns in addition to water quantity management.
- 3.1.8. Toilet Rooms:
 - 3.1.8.1. All multi-fixture toilet doors shall be designed to have the entrance doors swinging out of the room not into room. The out swinging doors limit the spread of bacteria by patrons who do not wash their hands after using the facilities. A patron can exit the facilities without touching the door hardware.
 - 3.1.8.2. All restroom accessories (not in toilet stalls) shall comply with ADA requirements for protruding objects. Accessories protruding more than 4 inches shall be located in corners, alcoves, between other structural elements, or recessed in walls.
- 3.1.9. Tornado Shelter: All building shall have an area designated as a tornado shelter. The structure in the area of the shelter shall be reinforced to provide a higher level of protection. The shelter does not need to be an additional room not already in the program, using one of the programmed spaces is sufficient.

3.2. SPECIFICATION ELEMENTS

Revised: 02/20/12

Equipment: where multiple pieces of the same equipment are provided, all pieces must be manufactured within one year of each other. Example: if two boilers are installed on project, manufacture date of each boiler must be within one year of each other.

DIVISION 00 - PROCUREMENT AND CONTRACTING REQUIREMENTS**00 11 00 Invitation to Bid***Revised: 11/18/13*

1. The Oneida Engineering Department shall make a determination of the bid process to be used for each project. The process can be invited bids or public bidding.
2. On projects where an invited bid process will be used, the list of invited bidders shall be derived from the *Oneida Engineering Department Master List of Contractors*.
3. On projects where a public bid process will be used, the Bid Advertisement shall be published in a minimum of the following publications:
 - a. Kalihwisaks (Tribal newspaper) – Oneida Project Manager will coordinate submittal.
 - b. Green Bay Press-Gazette – Consultant responsible for submittal. Consultant shall ensure the Tribe receives a proof of publication from the Green Bay Press-Gazette.

00 21 00 Instructions to Bidders*Revised: 12/17/15***2.0 BID INVITATION/ADVERTISEMENT:**

- A. Bids received by owner at:
Engineering Department
N7332 Water Circle Place
Oneida, WI 54155
- B. Bids will be opened privately if invited bid process used, and opened publicly for advertised bid process or if required by funding source.

3.0 BID DOCUMENTS

- A. Bid Documents are **NOT** available at the office of the owner.
- B. Bid Documents shall be sent to local plan rooms as follows (additional exchanges are at the Architect/Engineer's discretion):

| | | |
|---|--|--|
| American Indian Chamber of Commerce of Wisconsin – Plan Room 10809 W. Lincoln Ave. West Allis, WI 53227 414-604-2044 414-604-2070 Fax | Builders Exchange of Wisconsin, Inc. - Fox Valley Plan Room W2518 County Road JJ Appleton, WI 54913-9288 920-687-8782 920-687-8705 Fax http://bxwi.com/ | |
|---|--|--|

- C. Bid Documents may also be made available at on-line websites.

4.0 SITE ASSESSMENT

- A. A Prebid Conference shall be scheduled.

5.0 QUALIFICATIONS

- A. Contractor shall submit an *AIA A305 Contractor's Qualification Statement* if specifically requested by Owner.

6.0 BID SUBMISSION

- A. Submit three copies of bid.
- B. Abstract summary of submitted bids will be made available to all bidders following bid opening.

7.0 BID ENCLOSURES / REQUIREMENTS

- A. Bid Bond required.
- B. Performance & Payment Bonds at owner's discretion, include cost on bid form.
- C. See Supplementary Conditions for information regarding taxes.

00 22 00 Supplementary Instructions *Revised: 10/06/06*

- 1. Include a copy of the Oneida Engineering Department's *Document 00 22 01 - Indian Preference Vendors* in the Project Manual under this section and include listing of Certified Indian Owned Businesses following document.

00 31 00 Available Project Information *Revised: 10/06/06*

- 1. Include a copy of the Oneida Engineering Department's *Document 00 31 43 - Permit Fee Schedule* in the Project Manual under this section and include Oneida Zoning Department Permit Fee Schedule following document.

00 41 00 Bid Form *Revised: 02/20/12*

- 1. Performance & Payment Bonds at owner's discretion, include cost on bid form.
- 2. A subcontractors listing shall be included with bid.
- 3. Form shall list Contractor's name, address and telephone number, E-Mail address.
- 4. Within 24 hours of notification, apparent low-bidder will be required to submit the unit costs of products covered by GSA Schedule. Include Oneida Engineering Department's *Document 00 43 10 - Documentation of Special Pricing* in the Project Manual under this section. Architect shall complete the first two columns of form based upon materials selected for project.

00 52 00 Agreement *Revised: 05/05/17*

- 1. For Building Projects: The form of Agreement shall be *AIA Document A101, Standard Form of Agreement Between Owner and Contractor* and shall include the current *Oneida Nation's AIA Document A101, Modifications* amending the standard document.
- 2. For Civil Projects: The form of Agreement shall be *EJCDC C-520 Suggested Form of Agreement Between Owner and Contractor for Construction Contract (Stipulated Price)* and shall include the current *Oneida Nation's - Appendix A to: EJCDC C-520 Suggested Form of Agreement Between*

Owner and Contractor for Construction Contract (Stipulated Price) amending the standard document.

3. Other contract formats may be more appropriate for a particular project, confirm contract format with the Senior Tribal Architect.

00 71 00 General Conditions

Revised: 05/05/17

1. For Building Projects: *AIA Document A201 General Conditions of the Contract for Construction* shall be the General Conditions between the Owner and Contractor.
2. For Civil Projects: *EJCDC Standard General Conditions of the Construction Contract* shall be the General Conditions between Owner and Contractor.
3. Other general conditions may be more appropriate for a particular project, confirm general condition format with the Senior Tribal Architect.

00 73 00 Supplementary Conditions

Revised: 05/05/17

1. For Building Projects: Use the *Oneida Nation - AIA Supplementary Conditions* modifying AIA Document A201.
2. For Civil Projects: Use the *Oneida Nation - EJCDC Supplementary Conditions* modifying EJCDC C-700.
3. Include a copy of the Oneida Nation's *Indian Preference in Contracting Law (a.k.a Indian Preference Law)* in the Project Manual under this section.
4. Include the appropriate copy of the Oneida Engineering Department's *Document 00 73 43 Wage Rate Determination* in the Project Manual and include the appropriate wage rate determination. The county for Oneida projects will be Brown or Outagamie, verify project location. Wage rates will vary dependent upon specific project requirements:
 - A. All projects with federal funding: use Davis-Bacon Wage determination and denote that rates apply to all workers.
 - B. All other projects, Wage rates apply to workers hired from the Oneida Skills Bank, workers shall be paid according to the Wage Rate Determination established by the Indian Preference Office.
5. Security Requirements: Denote that Oneida Nation prohibits weapons on its property. Contractor will need to inform their employees and subcontractors. Contractor will also have to post signage prohibiting weapons on Oneida construction sites.

DIVISION 01 - GENERAL REQUIREMENTS

01 11 00 Summary of Work

Revised: 10/18/95

1. Identify work by Owner, if any.

01 20 10 Special Product Purchasing Procedures*Revised: 10/06/06*

1. Include a copy of the Oneida Engineering Department's *Document 01 20 10 - Special Product Purchasing Procedures* in the Project Manual under this section.

01 23 00 Alternatives*Revised: 10/06/06*

1. Include alternates to allow flexibility in scope adjustments necessary to bring project into budget. There will be no requirement as to the order of the alternate listing or priority of their acceptance.

01 31 19 Project Meetings*Revised: 10/18/95*

1. Identify requirements for having construction meetings and meeting minutes.

01 35 63 Sustainability Certification Project Requirements*Revised: 01/17/14*

1. Include this Section and note the following: "It is a goal of the Oneida Nation to minimize the environmental impact of its building projects consistent with our cultural beliefs to respect nature and conserve natural resources. While we do not intend to pursue a LEED Certification Rating, LEED will be used as a benchmark for evaluating sustainable design features."
 - A. Identify any specific requirements or documents that the contractor(s) will need to submit to verify sustainable design features.

01 58 00 Project Identification*Revised: 02/20/12*

1. Provide a temporary project sign with a layout complying with the Owner's *Temporary Project Sign Standard Layout*.
2. Project Identification - the project sign shall identify an after-hours emergency telephone number for both the general contractor and the owner.

01 74 19 Construction Waste Management and Disposal*Revised: 10/06/06*

1. Include requirements for waste management and recycling of project materials under this section. Identify forms required to verify quantities of materials.
 - A. WasteCap Wisconsin has sample specifications and forms available for download on their website www.wastecapwi.org

01 78 00 Closeout Submittals*Revised: 12/17/15*

1. Operations and Maintenance manuals shall be provided to Owner.
 - A. Owner preference is for manuals to be provided on a CD as a Portable Document File (PDF).
 - B. If paper copies are provided:

1. Owner will require three (3) copies.
 2. Binder edge must be labeled with:
 - a. Project Title
 - b. Oneida Project number
 - c. Volume number (if multiple volumes)
2. Operations and Maintenance manuals shall include (at a minimum):
- A. Subcontractor / Material Supplier Listing. Identify the company name, address, phone, contact name, e-mail address, and identification of scope of work provided by Section number.
 - B. Warranty Letter from General Contractor identifying the date of Substantial Completion.
 - C. Specification Sections, identify each specification section in which work was provided, identify the name of subcontractor, included relevant data of materials used and their maintenance requirements.

DIVISION 02 – EXISTING CONDITIONS

DIVISION 03 - CONCRETE

DIVISION 04 - MASONRY

04 05 00 Common Work Results for Masonry

Revised: 10/06/06

1. Sills:
 - A. Brick sills are not acceptable (row-lock or other). Sill must be either stone material or metal. Material should not have a joint across width of opening, unless it is a wide opening.
2. Masonry Embedded Flashings:
 - A. The following flashing materials are NOT ACCEPTABLE and cannot be specified:
 1. PVC Flashing.
 2. Aluminum Flashing.
 - B. The following flashing materials are acceptable:
 1. Rubberized asphalt.
 2. Copper, stainless steel, etc.
 - C. Flashings shall be specified and detailed as:
 1. Continuous at corners.
 2. Having end dams at ends of flashing at all openings. End dams shall be detailed on Construction Documents.
 3. Extending flashing as follows:
 - a. Multi-Wythe Walls: Extend through back-up wythe to 1 inch from inside face of wall. Turn flashing back over itself a minimum of 1/4 inch to form a water dam.
 - b. Single-Wythe Walls: Extend flashing to 1 inch from inside face of wall. Turn flashing back over itself a minimum of 1/4 inch to form a water dam.

- c. Masonry walls where covered on interior with another finish material:
Extend flashing entirely through masonry. Turn flashing up a minimum of ½ inch on inside face of masonry to form a water dam.
- 4. Flashing shall have a drip edge where exiting the exterior face of wall. If rubberized asphalt flashing is used, stop flashing short of exterior face of wall and provide a stainless steel drip and adhere flashing to drip.
- 5. Flashing shall extend a minimum of 6 inches above the “Mortar Net”.

3. Masonry Cavity Drainage, Weepholes, and Vents:

- A. The following methods for creating weepholes are NOT ACCEPTABLE and cannot be specified:
 - 1. Rope wick (rope eventually fills with sand and water and turns to cement, preventing the wicking of moisture and does not allow air into cavity).
 - 2. Oiled rod (hole created by removed rod eventually fills with debris, preventing the wicking of moisture and does not allow air into cavity).
 - 3. Plastic tubes (tube eventually fills with debris, preventing the wicking of moisture and does not allow air into cavity).
- B. The following method is acceptable for creating weepholes:
 - 1. UV resistant recycled polyester mesh inserted into open head joint.
 - 2. “Weep Vent” by Mortar Net or equal.

04 27 00 Multiple-Wythe Unit Masonry

Revised: 10/06/06

1. Cavity Walls:

- A. Wall shall have a 2 inch clear drainage cavity.
- B. Walls shall contain a “Mortar Net” or other similar product at all thru-wall flashing locations: wall base, lintel, etc.
 - 1. Full height of cavity with “Cav-A-Clear” or other similar product is acceptable in lieu of “Mortar Net” at wall base and lintels.

DIVISION 05 - METALS

DIVISION 06 - WOOD AND PLASTIC

DIVISION 07 - THERMAL & MOISTURE PROTECTION

07 27 00 Air Barriers

Revised: 02/20/12

- 1. Provide air barrier as required by Building Code.

07 50 00 Membrane Roofing

Revised: 10/06/06

- 1. Preferred roofing material for Oneida projects is Built-Up Bituminous Roofing. Verify roofing material with Senior Tribal Architect on each project.

DIVISION 08 - OPENINGS

08 70 00 Hardware

Revised: 03/21/14

1. Doors to receive an access control device (proximity card reader) shall have an electric strike and associated conduit, supplied and installed by the Contractor.
 - A. The electric strike shall be 24 volt DC.
 - B. Access control system will be by owner under a separate contract (see 28 13 00).
2. On projects for the Tribe's Gaming Division, all locksets shall be specified with a Best Access Systems interchangeable core to match Owner's keying standards.

08 80 00 Glazing*Revised: 02/20/12*

1. Exterior glazing shall have a shading coefficient of 0.45 or lower.

DIVISION 09 – FINISHES**09 06 00 Schedules for Finishes***Revised: 02/20/12*

1. Wood base is not permitted where ceramic tile floors are used.

DIVISION 10 - SPECIALTIES**10 28 00 Toilet, Bath, and Laundry Accessories***Revised: 03/23/05*

2. All of the following items are supplied by Owner, installed by Contractor:
 - A. Toilet Tissue Holders
 - B. Paper Towel Dispensers
 - C. Soap Dispensers (mounting on mirrors is not permitted by our Custodial Dept.)
3. All of the following items are supplied by Owner (no installation required):
 - A. Waste Receptacles

10 44 00 Fire Protection Specialties*Revised: 10/18/95*

1. Fire extinguishers are by Owner. Cabinets supplied and installed by Contractor.

DIVISION 11 - EQUIPMENT**DIVISION 12 - FURNISHINGS****DIVISION 13 - SPECIAL CONSTRUCTION****DIVISION 14 - CONVEYING EQUIPMENT****14 20 00 Elevators***Revised: 02/20/12*

1. The following equipment is NOT allowed and cannot be specified on Oneida Nation projects:
 - A. Kone Elevators.

DIVISION 21 - FIRE SUPPRESSION**21 00 00 Fire Suppression***Revised: 01/17/14*

1. All newly constructed Oneida Nation building shall have full fire sprinkler system installed.
2. Construction Documents for this system shall identify code, industry, and/or manufacturers required/recommended maintenance clearances as hatched areas around units/equipment.
3. A Clean-Agent Fire-Extinguishing System shall be utilized for fire suppression in the following room types:
 - A. Data Centers, Data Rooms (of any size)
 - B. Large file/record rooms
 - C. Electrical rooms in Gaming facilities
4. "Omega" brand, manufactured by Central Sprinkler Co., Fire Sprinkler Heads by are not allowed and cannot be specified on Oneida Nation projects.
5. Flexible piping used in system:
 - A. Braided is acceptable
 - B. Corrugated is NOT acceptable
6. System plans and specifications shall comply with the Owner's insurance carrier (FM Global) requirements.
7. Awarded Fire Suppression Contractor shall submit systems plans and specifications to the Owner (at same time as submitted for state plan review), for review by the Owner's Risk Management Department and insurance carrier (FM Global).

DIVISION 22 - PLUMBING**22 00 00 Plumbing***Revised: 1/22/16*

1. Construction Documents for this system shall identify code, industry, and/or manufacturers required/recommended maintenance clearances as hatched areas around units/equipment.
2. The following equipment is NOT allowed and cannot be specified on Oneida Nation projects:
 - A. Aerco Water Heaters
 - B. A.O. Smith Water Heaters
 - C. ProFlo fixtures
3. Plumbing, On large toilet rooms, (greater than three water closets), provide a keyed hose bibb connection located under the vanity counter.
4. All toilet room fixtures shall be sensor operated. Sensors shall be electrically powered. If this requirement seems excessive for scope of building verify owner requirements with Owner's Project Manager.

5. Interior clean-outs on sanitary sewers shall be spaced a maximum of 75 feet on center. Clean-out shall be sized to pipe downstream. Prefer wall to floor clean-outs.
6. Cross connection control shall be provided at or near all mop basins.
7. Cross Connection devices shall comply with the Oneida Plumbing Department standard.
8. If project includes coolers and freezers, coordinate providing heat recovery water heater to use condenser wasted heat with HVAC design. Example manufacturer is “Therma-Stor”.
9. Provide floor drains in all toilet rooms. Verify if self-priming traps are required on project.
10. All water closets shall be installed with a seat height between 17 to 19 inches above floor. This requirement applies to all water closets, not just accessible water closets (exception allowed for fixtures serving child care areas).
11. Pipe size standards:
 - A. Serving each water closet – 4” minimum diameter.
 - B. Serving each urinal – 3” minimum diameter.
 - C. Serving beverage (soda) dispenser – 4” minimum diameter receptor.

DIVISION 23 - HEATING, VENTILATING, AND AIR-CONDITIONING (HVAC)**23 00 00 HVAC***Revised: 12/17/15*

1. Construction Documents for this system shall identify code, industry, and/or manufacturers required/recommended maintenance clearances as hatched areas around units/equipment.
2. The following equipment is NOT allowed and cannot be specified on Oneida Nation projects:
 - A. Fulton Pulse Boilers
3. HVAC system shall have a two year warranty.
4. HVAC system redundancy – system shall achieve heating and cooling loads by multiple units (i.e. boiler, chiller, compressor, etc.). Unit size shall provide approximately 50% capability to meet load requirements. Verify with Project Manager if any areas require 100% redundancy.
5. HVAC design shall not allow zoning of ventilation systems to permit service by a single unit for a majority of a given space or facility. If necessary or desired to use large, multi-zone systems, then system shall have multiple fan configurations.
6. HVAC Air Handling Units - Adjustable sheaves are NOT allowed on equipment as part of final installation. Adjustable sheaves may be used temporarily until system is balanced, but shall be replaced with fixed sheaves thereafter.
7. Electric Heaters are not acceptable on Oneida projects and shall not be designed into a heating system. The Engineering Department may approve use of electric heaters under certain circumstances, contact the Project Manager if electric heaters seem to be a viable option on a particular project.
8. Fin tube baseboard heating shall be installed with a shut-off valve at each end of fin pipe in each room to allow removal of section. Each section shall be installed with a drain valve.
9. The following Design Temperatures shall be used on Oneida projects:

| | | Code: | Preferred / Design: |
|-------------------|---------|------------------------|----------------------------|
| Heating (min.) | Outside | -15 degrees F dry bulb | - 15 Degrees F Dry Bulb |
| | Inside | 67 degrees F | 70 degrees F |
| Cooling (max.) | Outside | 87 degrees F | 90 degrees F |
| | Inside | 78 degrees F | 75 degrees F |

10. Refrigerants, HCFC (R-22) are not allowed on Oneida projects because of future EPA phase out and environmental reasons. Alternative refrigerants must be used in lieu of R-22.
11. Design shall not place air intakes near areas where idling vehicles will be parked. Need to avoid drawing vehicle exhaust into building HVAC system.
12. Condensers serving coolers and freezer shall be remotely located, verify maximum run with manufacturer.
 - A. Option: provide heat recovery water heater to use condenser wasted heat. Example manufacturer is “Therma-Stor”.

13. Data Rooms shall be provided with an independent HVAC system to maintain an ambient temperature range of 68° to 75°F and an ambient relative humidity level between 45% and 55%.
14. All HVAC equipment shall be permanently labeled to match the HVAC plans.
15. Construction Documents for HVAC system shall identify responsible discipline for providing electrical disconnect switches on HVAC equipment, HVAC or Electrical contractor. Responsible party shall be noted on both HVAC and Electrical Construction Documents.

DIVISION 25 - INTEGRATED AUTOMATION**25 00 00 Integrated Automation***Revised: 11/18/13*

1. Oneida standard manufacturer for Direct Digital Controls is Schneider Electric – SmartStruxure Solution. Controls will be by Owner’s standard vendor under a separate contract, unless noted otherwise in project requirements or contract. This section shall denote that HVAC contractor will coordinate with standard vendor.
2. HVAC Designer shall identify a Sequence of Operation so that Owner’s control contractor can create a control point listing. HVAC Designer shall coordinate with Oneida DPW – Facilities to coordinate system control issues.
3. Sensor/Thermostats will be supplied and installed by Owner under a separate contract, unless noted otherwise in project requirements or contract. Wall box and conduit for sensor is to be supplied and installed by Electrical Contractor.

DIVISION 26 - ELECTRICAL**26 05 00 Common Work Results for Electrical Systems***Revised: 12/17/15*

1. Construction Documents for this system shall identify code, industry, and/or manufacturers required/recommended maintenance clearances as hatched areas around units/equipment.
2. HVAC Sensor/Thermostats will be supplied and installed by Owner under a separate contract. Wall box and conduit for sensor is to be supplied and installed by Electrical Contractor, note this requirement on electrical drawings.
3. Door Access Controls will be supplied and installed by Owner under a separate contract. Wall box and conduit for electric strike is to be supplied and installed by Electrical Contractor, note this requirement on electrical drawings.
4. Electrical panels/equipment shall not be installed on walls behind doors. Installation at these locations poses a safety hazard for maintenance personnel. No panels/equipment shall be installed within the area defined by ADA for Maneuvering Clearances at doors.
5. Aluminum is not allowed for wire, conductors, bus bars, etc. and cannot be specified on Oneida Nation projects.
6. 10 AWG conductors and smaller are to be stranded not solid.
7. On projects for the Tribe's Gaming Division, provide power receptacles in the toilet rooms to allow drying fans to be used. Coordinate locations with Gaming Facilities Director.
8. Construction Documents for Electrical shall identify responsible discipline for providing electrical disconnect switches for HVAC equipment, HVAC or Electrical contractor. Responsible party shall be noted on both HVAC and Electrical Construction Documents.
9. Conductors for branch circuits shall be sized to prevent a voltage drop exceeding 3% at the farthest outlet of power, heating, lighting and motor loads or combination of such loads.
10. The maximum total voltage drop on both feeds and branch circuits to the farthest outlet shall not exceed 5%.
11. The ground fault protection system shall be performance tested when first installed on site. A written record of the test shall be available to the Authority Having Jurisdiction (AHJ).
12. The ungrounded and grounded circuit conductors of each multi wire branch circuit shall be grouped with cable ties, tape, or similar means within the panel board or other point of origination.
13. A grounding conductor shall be pulled in each raceway. The raceway shall not be used as the grounding means.
14. Direct buried cables or conduits shall have a warning ribbon buried 12 inches above the cables or conduits.
15. Emergency circuits and normal circuits shall not share the same raceways.

16. All service conductors, motor conductors, and feeder conductors larger than # 4 shall have the insulation tested and documented with the date, time, and results and signed by the electrician conducting the test.
17. Raceways, boxes, and conduit bodies shall be of sufficient size to provide free space for the conductors.

26 05 26 Grounding and Bonding for Electrical Systems

Revised: 12/17/15

1. Building and structures supplied by feeder(s) or branch circuit(s) shall comply with article 250.32 of the NEC.
2. All grounding electrodes as described in the NEC article 250.52(A)(1) through (A)(7) that are present at each building or structure served shall be bonded together to form the grounding electrode system. Where none of these grounding electrodes exist one or more of the grounding electrodes specified in NEC article 250.52(A)(4) through (A)(8) shall be used.
3. A metal underground water pipe shall be supplemented by an additional electrode of the types specified in the NEC article 250.52(A)(2) through (A)(8).
4. An intersystem bonding termination for connecting intersystem bonding conductors required for other systems shall be provided externally to enclosures at the service equipment or the metering equipment enclosure and at the disconnecting means for any additional buildings or structures.
5. Bonding of the piping system and the exposed structural steel shall comply with the NEC article 250.104.
6. Metal raceways shall not be used as equipment grounding conductors.

26 05 33 Raceway and Boxes for Electrical Systems

Revised: 12/17/15

1. Junction boxes are to be a minimum of 2 1/8" deep, unless limited by stud cavity depth.
2. Boxes shall be independently supported.
3. EMT, IMC, AND RMC conduits shall be supported at intervals not exceeding seven (7) feet.
4. Couplings and connectors shall be steel set screw type (exception where the NEC prohibits this type of raceway fitting).
5. EMT, IMC, and RMC supporting straps shall be of the steel type.
6. MC cable shall not be used for service entrance, feeders or branch circuit wiring (exception when fished between access points through concealed spaces).
7. Where all conduits penetrate fire rated walls and ceilings the openings shall be fire stopped to maintain the rating of the walls and ceilings.
8. Emergency system box covers, fitting covers and enclosures shall be identified as emergency system components.
9. Conduit originating at panels, switch gear and load centers shall not be sized less than ¾ in.

26 05 53 Identification for Electrical Systems*Revised: 12/17/15*

1. Wiring colors shall be per standard NEC Code.
2. The ungrounded conductors of a 1 phase 120/240v and 3 phase 120/208v systems shall be colored coded black, red, and blue.
3. The ungrounded conductors of a 3 phase 277/480v system shall be color coded brown, orange, yellow.
4. Switch gear, motor control centers, and panels shall have name tag information labels on the equipment such as the voltage, amperage, phase, and location of source.
5. Disconnects shall have name tag information labels on them such as voltage, amperage of the overcurrent protection, phase and location of the source, and purpose of the disconnect if not evident.
6. Emergency system equipment such as switch gear, panels, generators and transfer switches shall be permanently marked so they will be identified as emergency equipment.

26 05 73 Overcurrent Protective Device Coordination Study*Revised: 12/17/15*

1. Electrical system coordination is required for short circuit protection where an orderly shut- down is needed to minimize the hazards to personnel and equipment.

26 06 20 Schedules for Electrical Distribution*Revised: 12/17/15*

1. Switch gear and panels shall have a circuit directory or circuit identification.
2. Feeders and branch circuits shall be identified with the panel label and circuit number at the source and the outlet(s) or equipment.
3. All conductors at termination and splice points shall be labeled with the panel and circuit number. Labels shall not be hand written.

26 24 00 Switchboards and Panelboards*Revised: 12/17/15*

1. Commercial grade equipment shall be used. Preferred manufacturer is Square D.
2. Aluminum is not allowed for bus bars and cannot be specified on Oneida Nation projects.
3. On projects for the Tribe's Gaming Division, provide dedicated service panel(s) within observation and/or security areas.
4. Ground- fault protection of equipment shall be provided for solidly grounded wye electrical services of more than 150 volts to ground but not exceeding 600 volts phase to phase for each service disconnect rated 1000 amps or more.
5. Available fault-current for the service equipment other than dwelling units shall be legibly marked in the field with the maximum available fault current. The field markings shall include the date the fault current calculation was performed and be sufficient durability to with stand the environment involved.

6. All working space for electrical equipment per NEC article 110.26 shall be maintained.
7. Service equipment rated 1200 amps or more shall have disconnecting means remote from the service equipment. This shall be discussed and determined if feasible per project.

26 43 00 Transient Voltage Suppression*Revised: 12/17/15*

1. TVSS protection shall be installed remote from the electrical equipment it is protecting.

26 51 00 Interior Lighting*Revised: 12/17/15*

1. All lighting fixtures requiring ballast, shall have electronic ballasts specified.
 - A. Owner's preferred ballast manufacturers are: Advance and Osram Sylvania.
2. 2 x 4 lay-in fixtures shall have split ballast to allow multiple lighting levels.
3. Dimmable ballasts are not allowed.
4. Suggested light fixtures shall be reviewed by Oneida DPW – Electrical Department.
5. Halogen lamps are not allowed in light fixtures.
6. 2 x 2 lay-in fluorescent fixtures are not allowed.
7. Light Switching:
 - A. Provide wall or ceiling mount occupancy sensors at the following rooms (review specific locations with project team):
 1. Offices
 2. Small storage rooms
 3. Conference rooms
 4. Toilet rooms
 - B. Occupancy sensors are NOT to be installed in Mechanical and electrical rooms.

26 52 00 Emergency Lighting*Revised: 12/17/15*

1. Mechanical rooms and electrical rooms shall have at least one battery backup emergency fixture. The emergency fixture shall share the same circuit as the normal lighting in these rooms.
2. Commercial building exits shall have emergency outdoor egress lights. Exception : where emergency outdoor egress lights at exits are not required by SPS 316 and NFPA 70.

26 53 00 Exit Signs*Revised: 12/17/15*

1. Exit lights shall be L.E.D.

26 56 00 Exterior Lighting*Revised: 12/17/15*

1. Lamps - reviewed options with Oneida DPW – Electrical Department.
2. Photo cell control in groups is acceptable.

3. Review requirements for receptacles at poles with project team.
4. Commercial building outdoor lighting shall be controlled by the Building Automation Direct Digital Control System (BAS DDC System).

DIVISION 27 - COMMUNICATIONS**27 00 00 Communications***Revised: 12/17/15*

1. Construction Documents shall require the Electrical Contractor to provide conduit and box roughed out to above ceiling for Owner voice and data outlets. Provide at all offices and other rooms as designated by Owner during design phases.
2. All rooms to receive voice and data outlets, shall have a minimum of two (2) voice and data outlets located so as to provide the most flexible arrangement of furniture in each room.
3. System design shall be compliant with the current edition of the *Oneida Casino Network Standards*.

DIVISION 28 - ELECTRONIC SAFETY AND SECURITY**28 13 00 Access Control***Revised: 11/18/13*

1. Oneida standard manufacturer for door access controls is Schneider Electric – SmartStruxure Solution. Controls will be by Owner’s standard vendor under a separate contract, unless noted otherwise in project requirements or contract. This section shall denote that Electrical contractor will coordinate with standard vendor.
2. Construction Documents shall require the Electrical Contractor to provide conduit and box roughed out to above ceiling for Owner Access Control system.

28 16 00 Intrusion Detection*Revised: 10/12/06*

1. Owner will be incorporating a security system into project. System and monitoring will be by Owner’s standard vendor under a separate contract. Coordinate equipment utility requirements with standard vendor.

28 31 00 Fire Detection and Alarm*Revised: 11/18/13*

1. Owner requires complete fire alarm system installation. Manufacturer: UTC Fire and Security.
 - A. If this requirement seems excessive for scope of building verify owner requirements with Owner’s Project Manager.
2. System plans and specifications shall comply with the Owner’s insurance carrier (FM Global) requirements.
3. Awarded Fire Alarm Contractor shall submit systems plans and specifications to the Owner (at same time as submitted for state plan review), for review by the Owner’s Risk Management Department and insurance carrier (FM Global).
4. Fire alarm system monitoring will be by Owner’s standard vendor, unless noted otherwise in project requirements or contract. Coordinate equipment installation with standard vendor.

DIVISION 31 - EARTHWORK**31 09 00 Geotechnical Instrumentation and Monitoring of Earthwork***Revised: 10/06/06*

1. The following wording shall be added to all appropriate site preparation and earthwork sections:
 - A. “An Oneida Archaeological Site Monitor is required to be on the project site during all ground breaking and earth moving activities. The Contractor is to give the Oneida Project Manager adequate notification as to when these activities are scheduled and the Oneida Project Manager will make arrangements to have a monitor available during these activities. Particular care is to be given when ground breaking begins and at any time during the earth moving process. If at any time during the process artifacts or human remains are uncovered/discovered, construction is to cease immediately and the Oneida Project Manager is to be contacted. The Oneida Project Manager will in turn contact the Oneida Tribal Historic Preservation Office for proper handling and care of these finds -- BEFORE REMOVAL FROM THE EARTH!”

31 10 00 Site Clearing*Revised: 05/05/17*

1. Clearing and Grubbing Construction Documents shall denote:
 - A. Contractor will be required to obtain a Tree Cutting Permit from the Oneida Conservation Department.
 - B. Removed trees (5” caliper and larger) are the property of the Oneida Nation and shall be returned to the Tribe.
 - C. Limb and cut trees into 8’4” lengths and deliver to Oneida Conservation Department.
 - D. Properly dispose of stumps, brush, branches and other debris off site.
 - E. Oneida Conservation Department – Compost Yard
N8085 County Road U
Oneida, WI 54155
920-869-1450
2. Earthwork sections shall denote that excess top soil and sub-soil is the property of the Owner and shall be delivered to a site determined by Owner.
 - A. Identify the address of the owner’s property where material will be stock piled with Owner’s Project Manager, and include in Construction Documents.

31 20 00 Earth Moving*Revised: 12/17/15*

1. Civil Engineer shall determine if Oneida has stock piled soils available to meet the fill requirements of the project. Coordinate with the Oneida Material Team to confirm available soil types and quantities. If stockpiled material meets the project needs, earthwork sections shall denote location and use of material. No imported material will be allowed if sufficient stockpile material is available. Identify the address of the owner’s property where material will be loaded for delivery to project site.
 - A. Material Team contact: Mary Jo Nash, 920-869-1690 ext. 6612, mnash@oneidanation.org
2. Construction Documents must denote the requirements for truck routes to and from the stock pile location. Routes shall maximize utilization of use state highway, followed by county highways, then municipal roads. Routes over municipal roads shall be minimized to the greatest extent possible.

DIVISION 32 - EXTERIOR IMPROVEMENTS

32 10 00 Bases, Ballasts, and Paving *Revised: 02/20/12*

1. Parking, in addition to the required amount of handicap parking spaces provide “Elder Parking” spaces in a quantity to match 50% of the quantity of handicap spaces, but no less than two.
 - A. Size of spaces shall be standard parking stall.

32 80 00 Irrigation *Revised: 10/06/06*

1. Irrigation systems are not allowed on Oneida projects. Landscaping is NOT to be irrigated.

32 90 00 Planting *Revised: 10/06/06*

1. To the maximum extent possible, plant materials should be indigenous to Wisconsin, and drought tolerant.
2. At sloped roof drip lines, provide ground cover to protect exterior building wall from splash stains.

DIVISION 33 - UTILITIES

DIVISION 34 - TRANSPORTATION

DIVISION 35 - WATERWAY AND MARINE CONSTRUCTION

APPENDIX A**REFERENCED DOCUMENTS LISTING:***Revised: 05/05/17*

- A.1 *Oneida Engineering Department Master List of Contractors*
- A.2 *Oneida Nation's AIA Document A101, Modifications*
- A.3 *Oneida Nation's - Appendix A to: EJCDC C-520 Suggested Form of Agreement Between Owner and Contractor for Construction Contract (Stipulated Price)*
- A.4 *Oneida Nation's Indian Preference in Contracting Law (a.k.a Indian Preference Law)*
- A.5 *Oneida Nation - AIA Supplementary Conditions*
- A.6 *Oneida Nation - EJCDC Supplementary Conditions*
- A.7 *Oneida Engineering Department's Document 00 22 01 - Indian Preference Vendors*
- A.8 *Oneida Engineering Department's Document 00 31 43 - Permit Fee Schedule*
- A.9 *Oneida Engineering Department's Document 00 43 10 - Documentation of Special Pricing*
- A.10 *Oneida Engineering Department's Document 00 73 43 Wage Rate Determination*
- A.11 *Oneida Engineering Department's Document 01 20 10 - Special Product Purchasing Procedures*
- A.12 *Oneida Nation - Temporary Project Sign Standard Layout*
- A.13 *Oneida Nation – Data Room Configuration Standard*
- A.14 *Oneida Casino Network Standards*

PARTITION LEGEND

—

EXISTING CONSTRUCTION TO REMAIN.

EXISTING CONSTRUCTION TO BE DEMOLISHED.

—

NEW ONE HOUR FIRE AND SMOKE PARTITION WALL, FULL HEIGHT.

SHEET A1 - PLAN NOTES:

- 1

EQUIPMENT/ SHELVING BY OWNER - N.I.C.
- 2

SEE DETAIL 5/A2 FOR Rx RACK DETAIL.
- 3

REMOVE EXISTING CAGE ENCLOSURE AND RETURN TO OWNER.
- 4

SITE CLEAR EXISTING WOOD SHELVING WITHIN PROJECT AREA. MODIFY SHELVING TO TERMINATE AGAINST WEST SIDE OF NEW WALL.
- 5

SITE CLEAR EXISTING H.M. DOOR, MODIFY OR REPLACE H.M. FRAME AS REQUIRED, PROVIDE NEW 4'-0" x 7'-0" H.M. DUTCH DOOR WITH SHELF FOR INSTALLATION IN A ONE-HOUR FIRE AND SMOKE PARTITION. MAGNETIC HOLD-OPEN FOR UPPER LEAF TIED TO FIRE ALARM SYSTEM. PROVIDE ALL REQUIRED HARDWARE TO BE CODE COMPLIANT. ELECTRIC 24V DC STRIKE FOR PALM READER. KICKPLATES ON BOTH SIDES.

GENERAL NOTES:


1. ALL WORK SHALL COMPLY WITH APPLICABLE BUILDING CODES.
2. DESIGN-BUILDER SHALL COORDINATE ALL TRADES, TO ENSURE TIMELY COMPLETION OF THE SCOPE OF WORK.
3. SCOPE OF WORK INCLUDES:

3.1. ALL FIRE PROTECTION SYSTEM MODIFICATIONS AS REQUIRED BY ROOM CONFIGURATION.

3.2. ALL PLUMBING REQUIRED TO SERVICE NEW SINK.


3.3. ALL HVAC SYSTEM MODIFICATIONS AS REQUIRED BY ROOM CONFIGURATION.

SCALE ACCURATE ONLY
WHEN PRINTED ON 11" X 17" SHEET

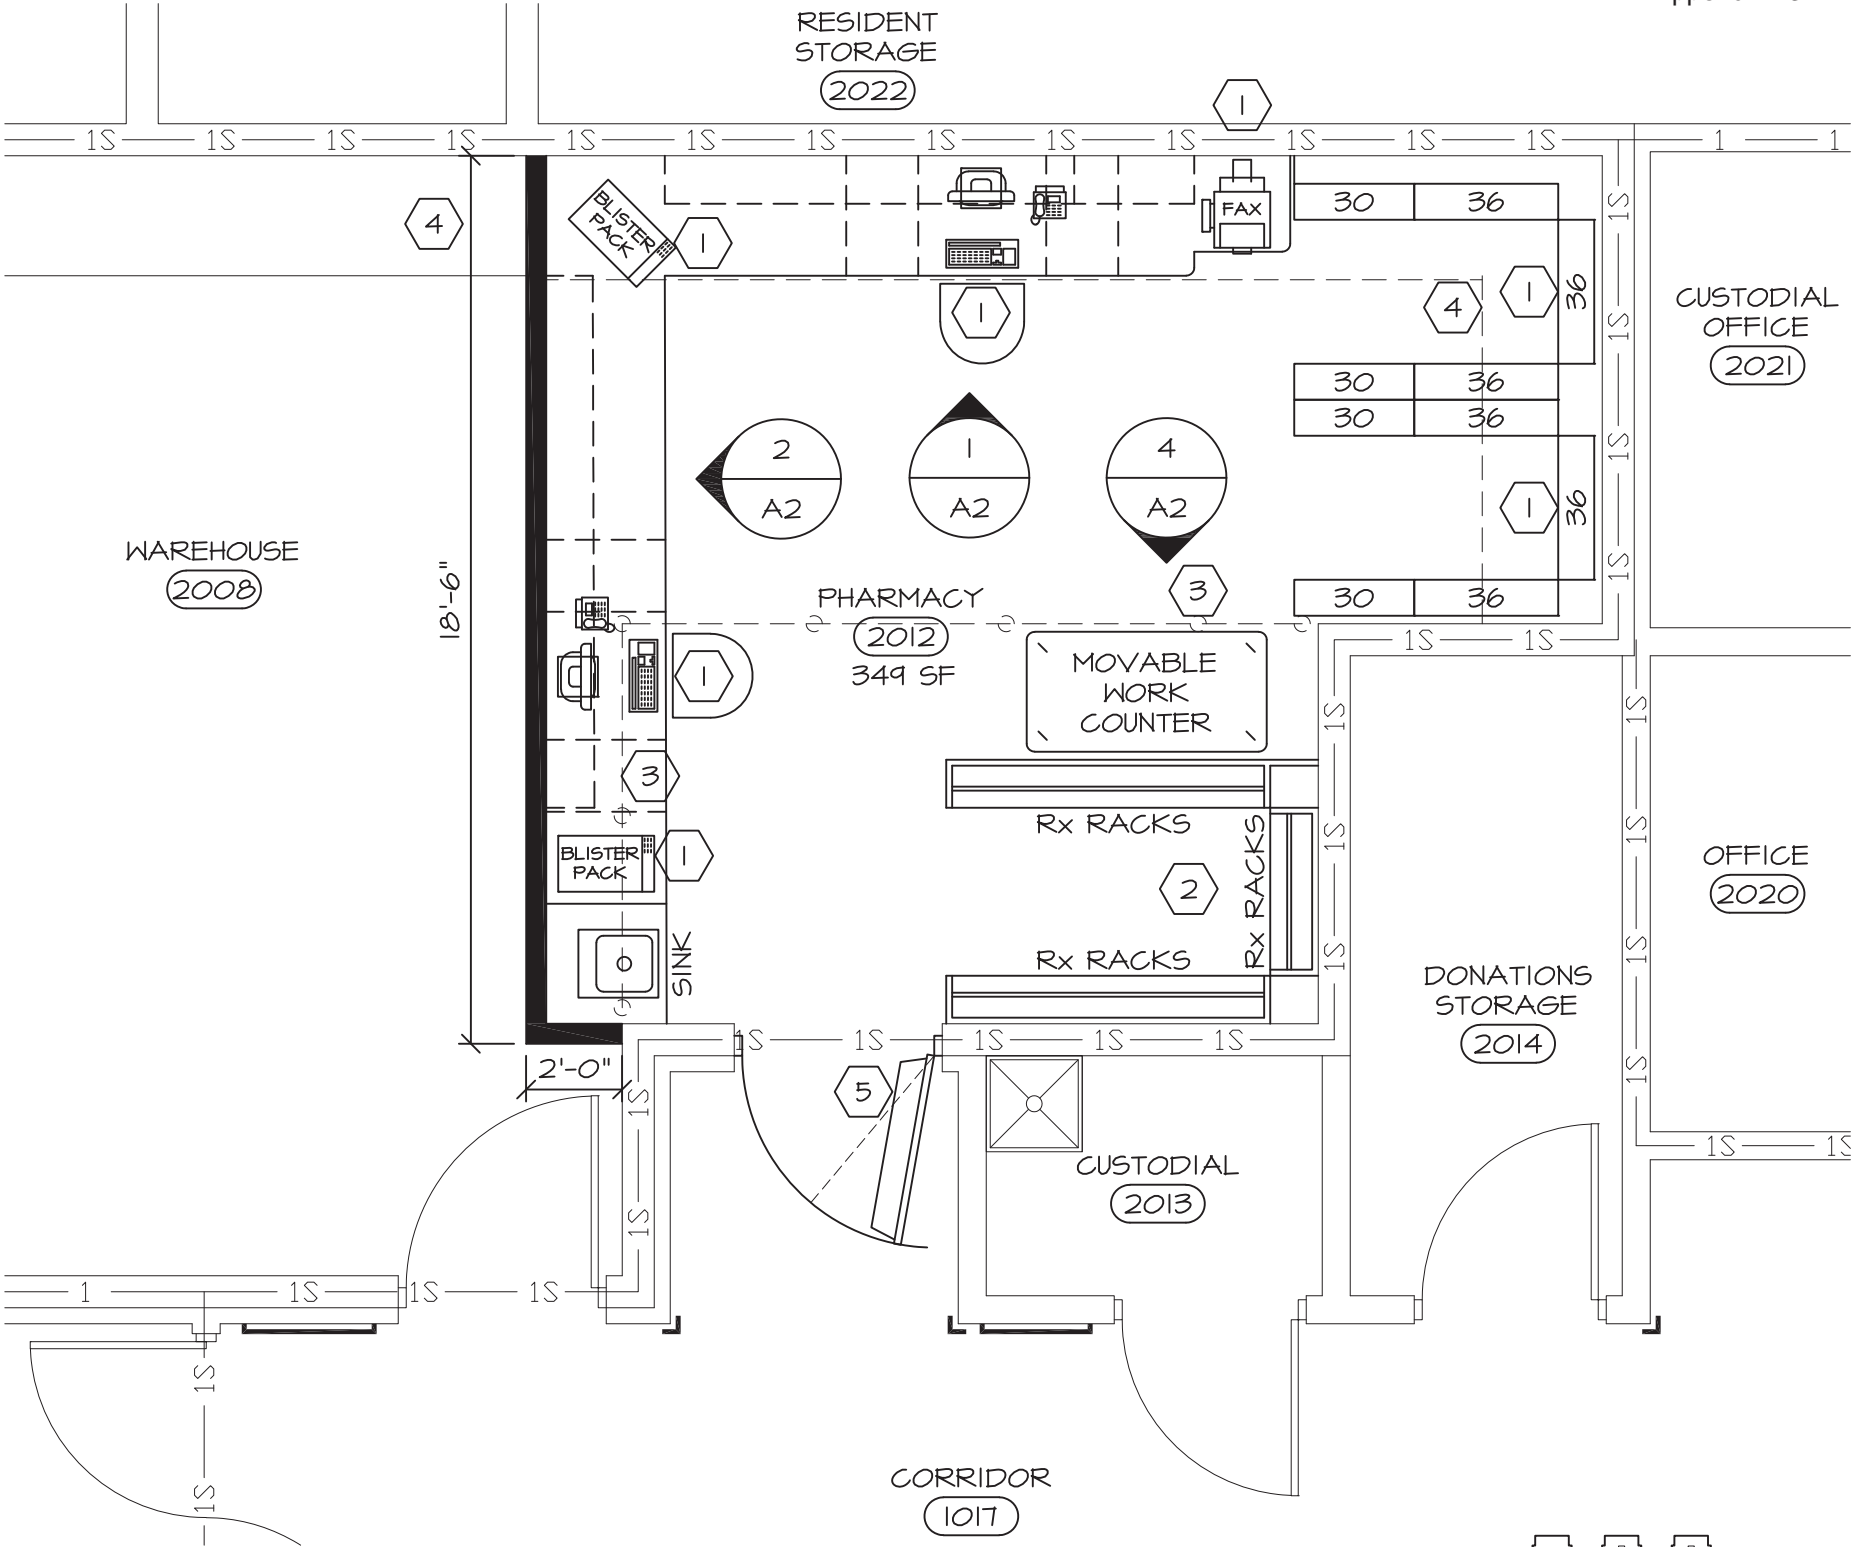

SHEET INDEX:

- A1 FLOOR PLAN
- A2 INTERIOR ELEVATIONS
- E1 ELECTRICAL PLAN

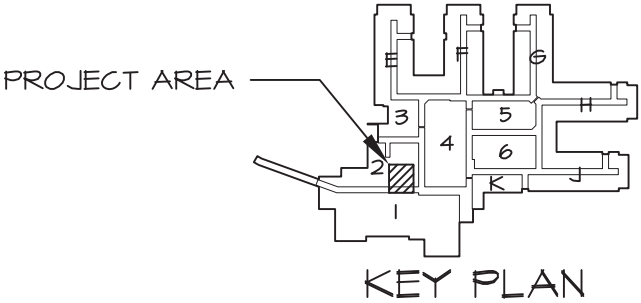

PRELIMINARY
NOT FOR CONSTRUCTION

ONEIDA

DEVELOPMENT DIVISION
ENGINEERING DEPT.
ONEIDA, WISCONSIN

OCHC SATELLITE PHARMACY AT:
ANNA JOHN RESIDENT CENTERED CARE COMMUNITY
ONEIDA, WISCONSIN

DATE
6/29/17

PROJECT NO.
16-013

SHEET
A1



DEVELOPMENT DIVISION
ENGINEERING DEPT.
ONEIDA, WISCONSIN


OCHC SATELLITE PHARMACY AT:
ANNA JOHN RESIDENT CENTERED CARE COMMUNITY
ONEIDA, WISCONSIN

DATE
6/29/17


PROJECT NO.
16-013

SHEET



A2

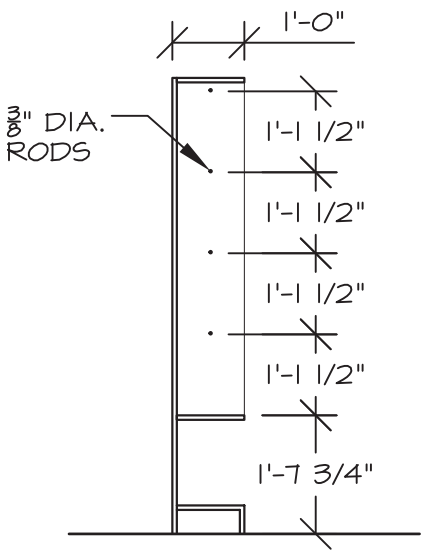


PHARMACY 2012
SCALE: 3/8" = 1'-0"
5
A2

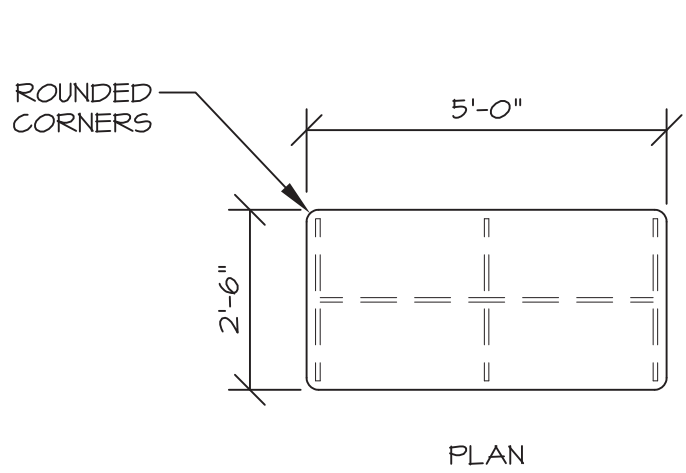


PHARMACY 2012
SCALE: 3/8" = 1'-0"
4
A2

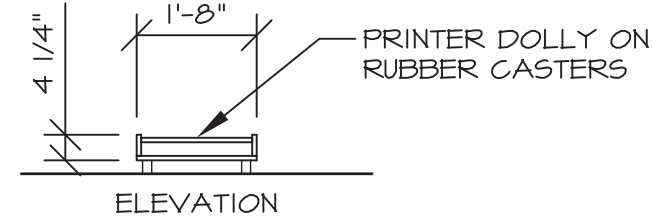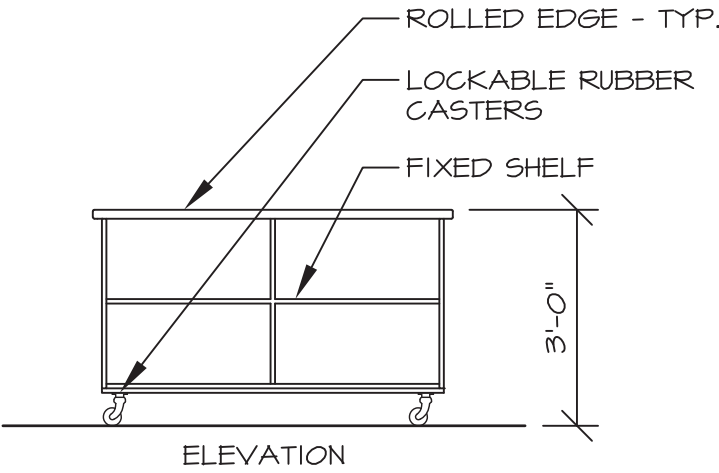

PHARMACY 2012
SCALE: 3/8" = 1'-0"
3
A2

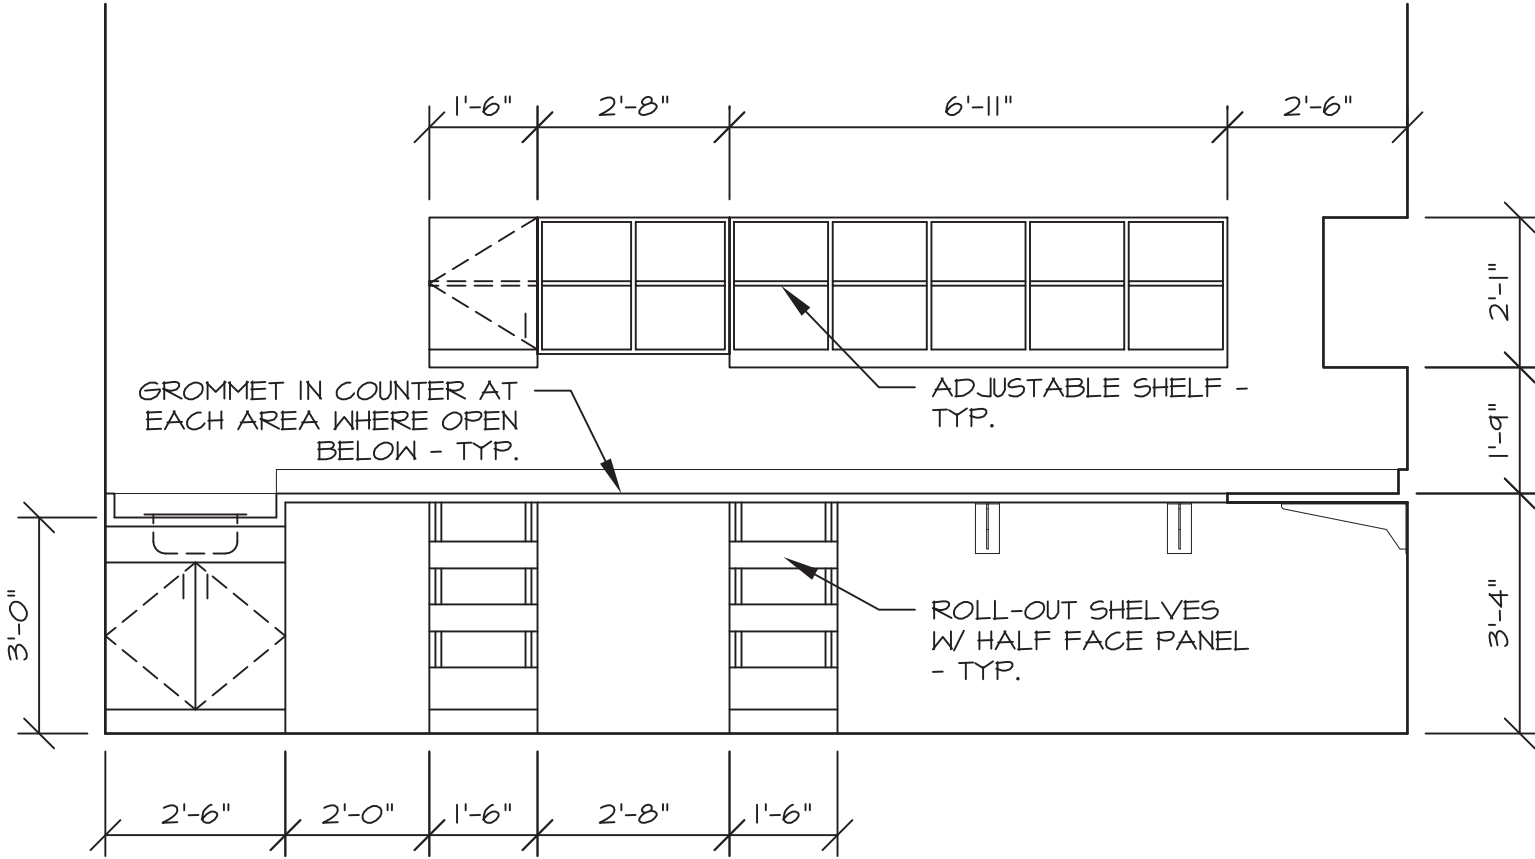

PHARMACY 2012
SCALE: 3/8" = 1'-0"
2
A2

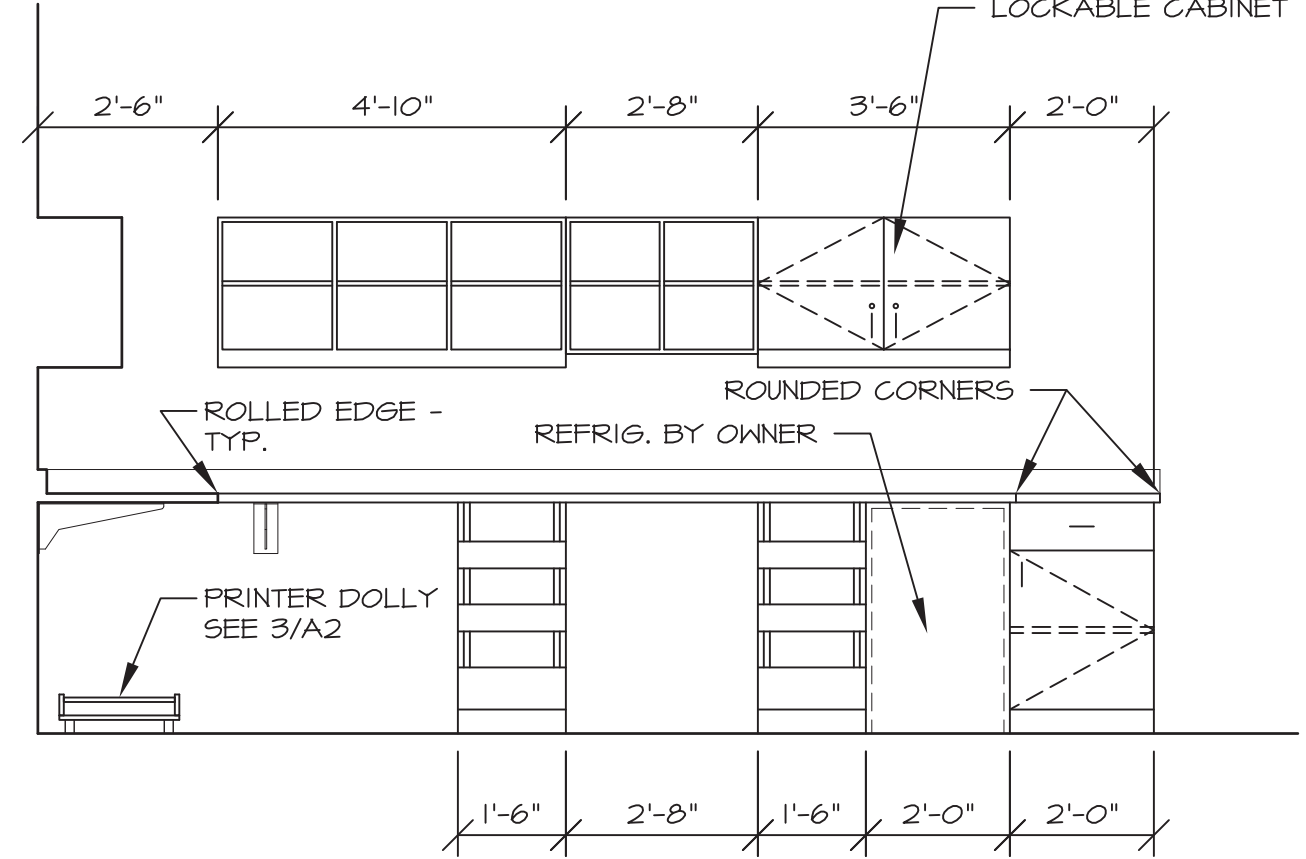

PHARMACY 2012
SCALE: 3/8" = 1'-0"
1
A2

SCALE ACCURATE ONLY
WHEN PRINTED ON 11" X 17" SHEET

PRELIMINARY
NOT FOR CONSTRUCTION

SYMBOL KEY

ELECTRICAL RECEPTACLE - EXISTING.

ELECTRICAL RECEPTACLE - NEW.

VOICE/DATA OUTLET - EXISTING.

VOICE/DATA OUTLET - NEW.

PALM READER.

SECURITY CAMERA.

SHEET EI - PLAN NOTES:

- 1

PROVIDE POWER AND DATA OUTLETS ABOVE AND BELOW COUNTER AT THIS LOCATION. OTHER OUTLETS ABOVE COUNTER UNLESS NOTED WITH U.C. (UNDER-COUNTER).
- 2


RECEPTACLE MOUNTED AT HEIGHT FOR MAGNETIC HOLD-OPEN DEVICE FOR UPPER DOOR LEAF.
- 3

MOVE EXISTING LIGHTING AS REQUIRED BY NEW WALL INSTALLATION.
- 4

PROVIDE NEW LIGHTING AS REQUIRED TO PROPERLY ILLUMINATE ROOM. 2x4 SURFACE MOUNT FIXTURES.
- 5

PROVIDE UNDER-CABINET LED LIGHTING.
- 6

RECEPTACLE ON EMERGENCY CIRCUIT.

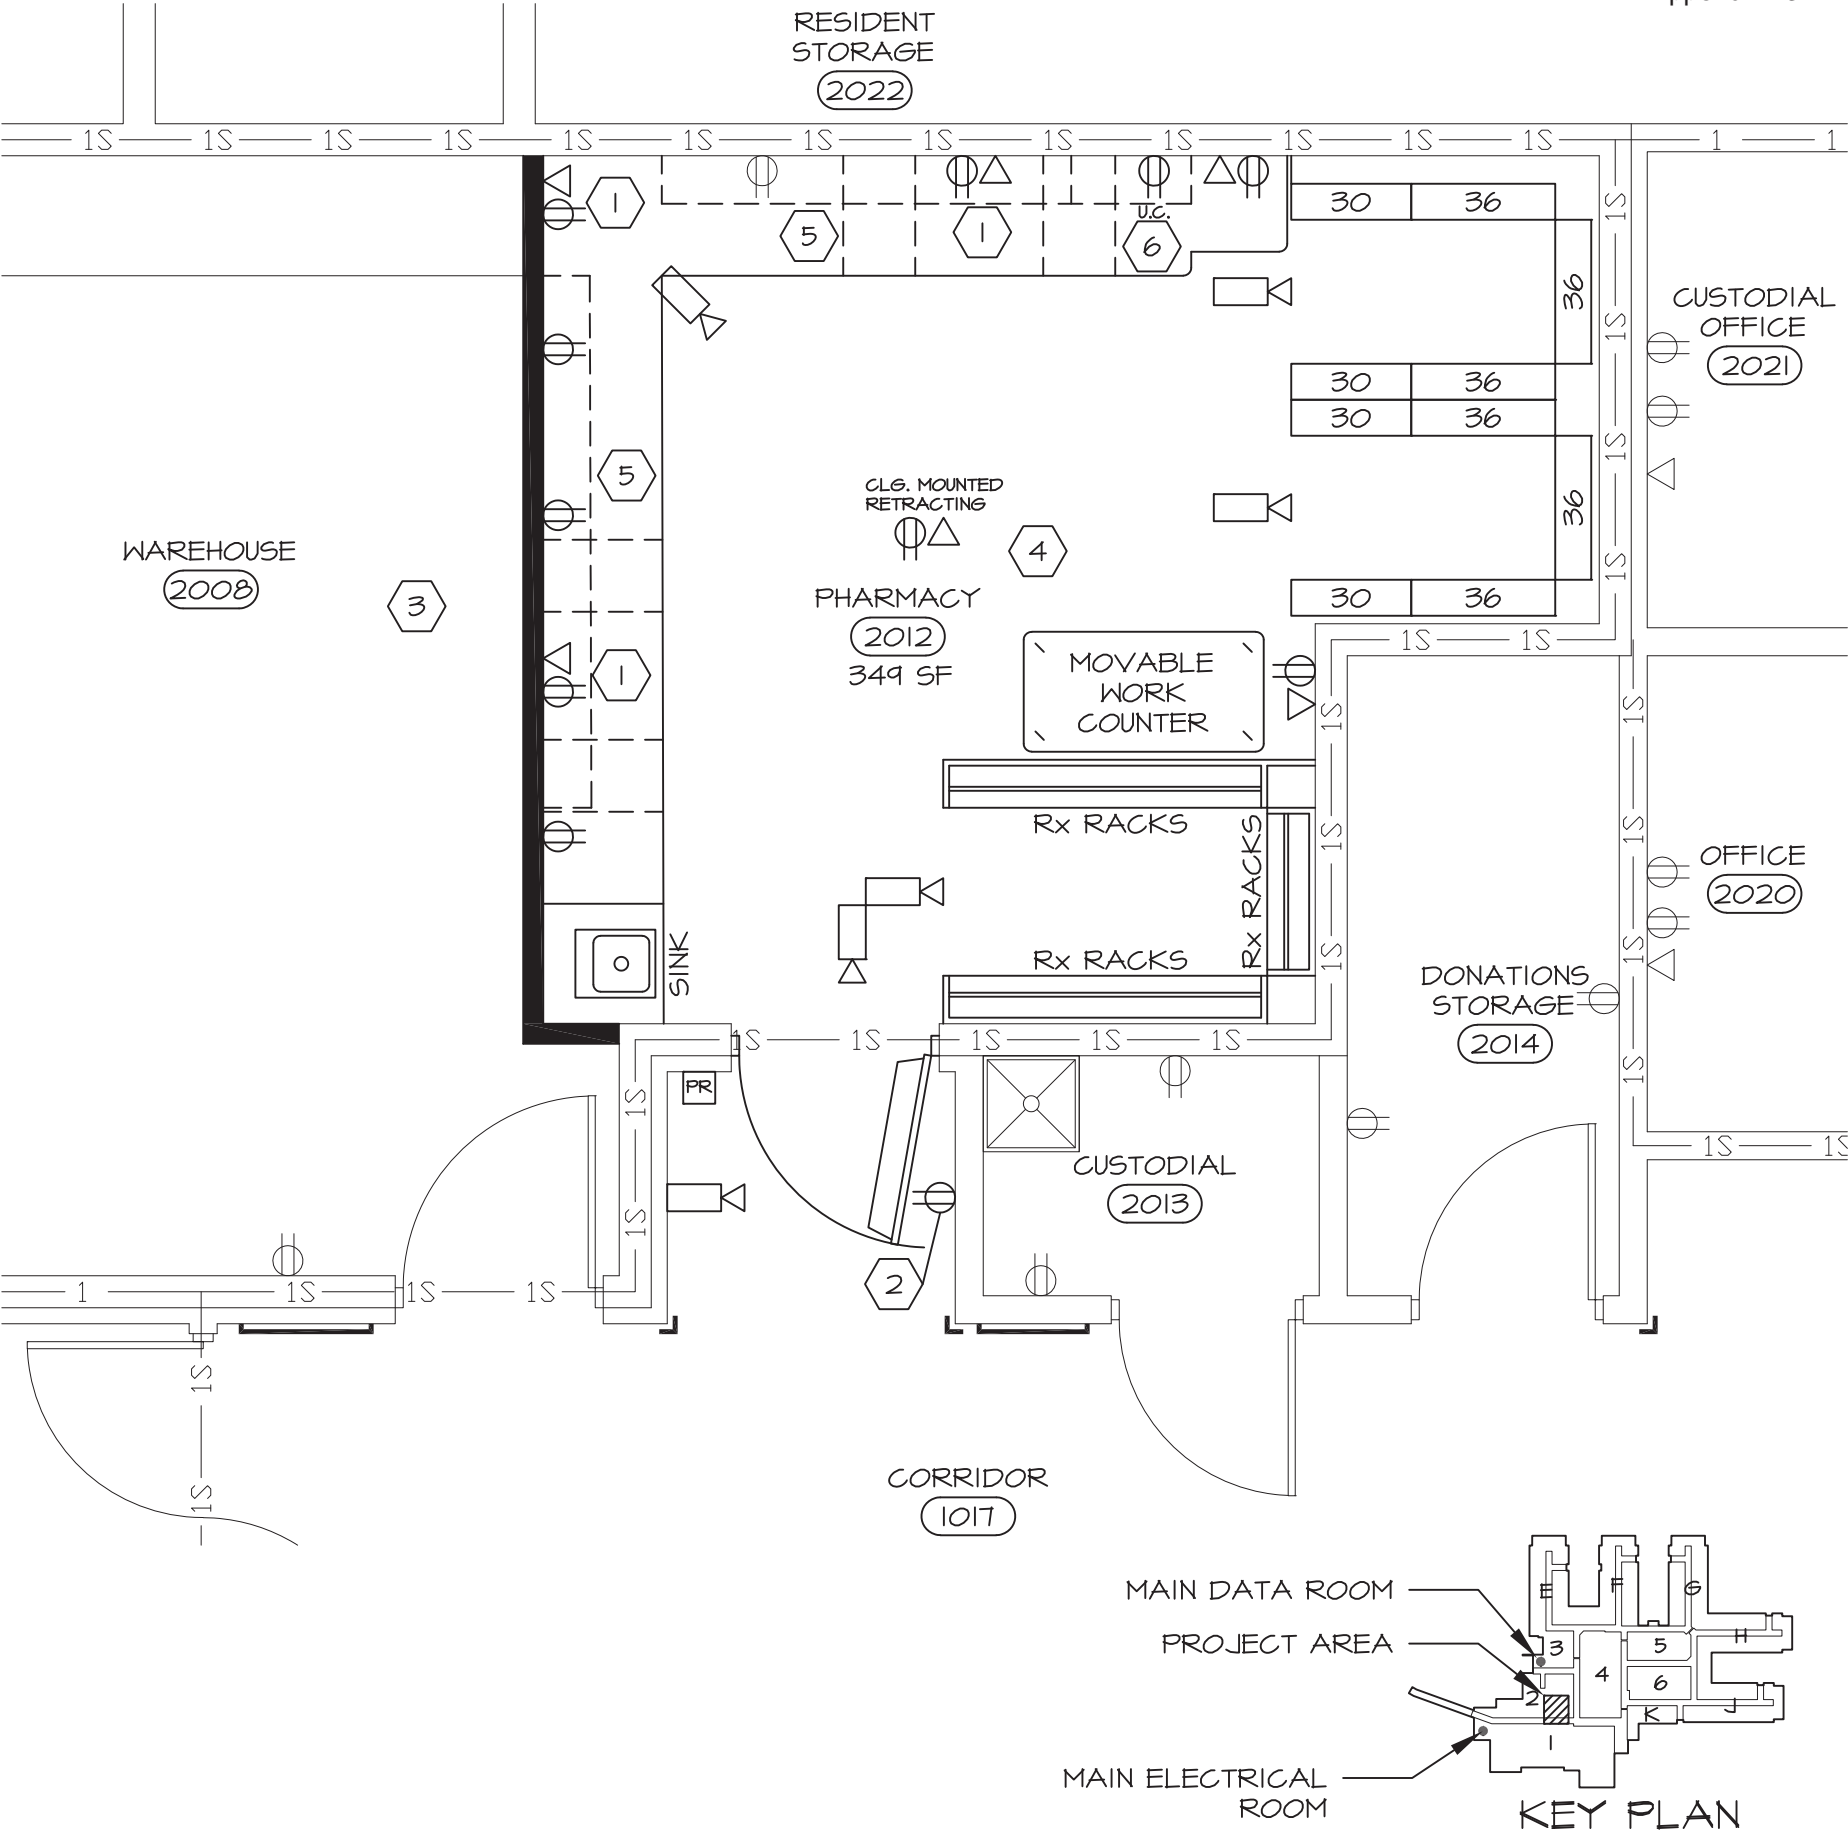

SCALE ACCURATE ONLY
WHEN PRINTED ON 11" X 17" SHEET

ELECTRICAL
FLOOR PLAN

SCALE: 1/4" = 1'-0"

N

PRELIMINARY
NOT FOR CONSTRUCTION

ONEIDA

DEVELOPMENT DIVISION
ENGINEERING DEPT.
ONEIDA, WISCONSIN

OCHC SATELLITE PHARMACY AT:
ANNA JOHN RESIDENT CENTERED CARE COMMUNITY
ONEIDA, WISCONSIN

DATE
6/29/17


PROJECT NO.
16-013

SHEET
III

ONEIDA RESIDENT-CENTERED CARE COMMUNITY

Oneida, Wisconsin | RECORD DOCUMENTS

| | | | | | | | | | | |
|--|---|---|--|---|---|---|--|---|--|--|
| PROJECT | ONEIDA, WISCONSIN RECORD DOCUMENTS | | | | | | | ONEIDA RESIDENT-CENTERED CARE COMMUNITY CIP #98-005 ONEIDA, WISCONSIN Owner ONEIDA TRIBE OF INDIANS OF WISCONSIN P.O. Box 365 Oneida, WI 54155 Project No 051514 | | |
| SEAL | Associate Architectural Design | | | | | | | | | |
| CONSULTANTS | Survey | Civil | Architectural | Structural | Food Service | Landscape | Associate Architectural Design | | | |
| DRAWINGS | McMahon Associates, Inc. P.O. Box 1025 Neenah, WI 54957 Ph 920-751-4200 Fx 920-751-4284 | RL Melchert, LLC 921 St. Croix Street Hudson, Wisconsin 54016 Ph 715-386-7736 Fx 715-386-7889 | Engberg Anderson, Inc. 320 East Buffalo Street Suite 500 Milwaukee, Wisconsin 53202 Ph 414-944-9000 Fx 414-944-9100 | Pierce Engineers, Inc. 241 North Broadway Suite 500 Milwaukee, Wisconsin 53202 Ph 414-278-6060 Fx 414-278-6061 | PAK Design Group 2836 Mount Carol Drive Green Bay, Wisconsin 54311 Ph 920-468-4117 | RL Melchert, LLC 921 St. Croix Street Hudson, Wisconsin 54016 Ph 715-386-7736 Fx 715-386-7889 | Standing Stone Design, Inc. 15150 West Kingsway Drive New Berlin, Wisconsin 53151 Ph 414 526-4905 | Issued For: | | |
| | T001 Title Sheet; Drawing Index (formerly Sheet #T101 for Bid Package #1 and Sheet #T201 for Bid Package #2) | - Lease Boundary Survey (For Reference Only) | ¹ C201 Site Demolition Plan ¹ C301 Site Plan ² C302 Patio Details ¹ C303 Site Details ² C304 Signage Plan ² C305 Entry Paving Plan ¹ C401 Grading Plan ¹ C403 Erosion Control Plan ¹ C501 Utility Plan ¹ C502 Utility Details ¹ C601 Profiles | ² A001 Graphic Symbols; Abbreviations; Job Sign ² A002 First Floor Overall Plan / Key Plan ² A003 First Floor Code Compliance Plan ² A004 Code Compliance Data & Schedules ² A101-1 First Floor Plan - Area 1 ² A101-2 First Floor Plan - Area 2 ² A101-3 First Floor Plan - Area 3 ² A102 Roof Plan - Overall ² A201-1 First Floor Reflected Ceiling Plan - Area 1 ² A201-2 First Floor Reflected Ceiling Plan - Area 2 ² A201-3 First Floor Reflected Ceiling Plan - Area 3 ² A301 Typical Resident Units - Enlarged Floor Plans; Door and Room Finish Schedules ² A302 Typical Resident Units - Enlarged Reflected Ceiling Plans ² A303 Enlarged Floor Plans ² A401 Exterior Elevations & Window Types ² A402 Exterior Elevations ² A403 Exterior Elevations ² A404 Building Sections ² A405 Building Sections ² A406 Canopy Plans, Elevations, & Sections ² A407 Canopy Details ² A501 Wall Sections & Details ² A502 Roof Types; Wall Sections & Details ² A503 Wall Sections & Details ² A504 Exterior Envelope Details ² A505 Exterior Envelope Details ² A506 Exterior Envelope Details ² A601 Door Schedule ² A602 Door and Frame Types; Details ² A603 Interior Wall Types ² A604 Interior Assemblies Details ² A701-1 First Floor Finish Plan - Area 1 ² A701-2 First Floor Finish Plan - Area 2 ² A701-3 First Floor Finish Plan - Area 3 ² A702 Room Finish Schedule ² A801 Interior Elevations ² A802 Interior Elevations ² A803 Interior Elevations ² A804 Interior Elevations ² A805 Interior Elevations ² A806 Interior Elevations ² A807 Interior Elevations ² A901 Interior Details ² A902 Interior Details | ¹ S001 Structural Notes & Schedules ¹ S002 Snow Drift Diagram & Roof Design Notes ¹ S101 Overall Foundation Plan ¹ S101-1 Partial Foundation Plan - Area 1 ¹ S101-2 Partial Foundation Plan - Area 2 ¹ S101-3 Partial Foundation Plan - Area 3 ² S102-1 Partial Roof Framing Plan - Area 1 ² S102-2 Partial Roof Framing Plan - Area 2 ² S102-3 Partial Roof Framing Plan - Area 3 ¹ S300 Foundation Details ² S400 Framing Details ² S401 Framing Details ² S500 Framing Details ² S501 Framing Details | ² FS102 Main Kitchen Plan ² FS103 Satellite Kitchen Plans ² FS201 Kitchen Equipment Schedule ² FS202 Kitchen Mechanical Reference Plan ² FS203 Kitchen Electrical Reference Plan | ² L101 Landscape Plan ² L103 Landscape Details | T101 01 Plan Review 02 Bid 03 Record Documents | 08-08-2011 08-17-2011 02-11-2013 | |
| | | | | | | | | T201 01 Plan Review 02 Bid 03 Record Documents | 09-27-2011 10-11-2011 02-11-2013 | |
| Reference Set for Project #16-013. | | | | | | | | | | |
| Highlighted sheets are included. Other sheets available upon request. | | | | | | | | | | |
| Full set will be provided to awarded Design-Builder. | | | | | | | | | | |
| The following sheets are also included: | | | | | | | | | | |
| - FP-4 of 7 Fire Protection - Area 3 | | | | | | | | | | |
| - P103 Plumbing DWV Plan - Area 3 | | | | | | | | | | |
| - P203 Plumbing Domestic Water Plan - Area 3 | | | | | | | | | | |
| - H101-3 HVAC Ductwork Plan - Area 3 | | | | | | | | | | |
| - H201-3 HVAC Piping Plan - Area 3 | | | | | | | | | | |
| - H500 HVAC Schedules | | | | | | | | | | |
| - H501 HVAC Schedules | | | | | | | | | | |
| - H502 HVAC Schedules | | | | | | | | | | |
| - E101-3 Electrical Lighting Plan - Area 3 | | | | | | | | | | |
| - E201-3 Electrical Power Plan - Area 3 | | | | | | | | | | |
| - E301-3 Electrical Data Plan - Area 3 | | | | | | | | | | |
| - E806 Electrical Panel Schedule | | | | | | | | | | |
| - E808 Electrical Panel Schedule | | | | | | | | | | |
| KEY: | | | | | Drawings for the Following Work are Provided Separately by the Design-Build Subcontractors, and are Not Included in this Drawing Set: | | | | | |
| ¹ A000 DENOTES THAT DRAWING WAS ISSUED UNDER BID PACKAGE #1 | | | | | - Fire Suppression | | | | | |
| ² A000 DENOTES THAT DRAWING WAS ISSUED UNDER BID PACKAGE #2 | | | | | - Plumbing | | | | | |
| | | | | | - HVAC | | | | | |
| | | | | | - Electrical | | | | | |
| | | | | | - Information Technology | | | | | |
| | | | | | - Electronic Safety & Security | | | | | |
| | | | | | - Solar Thermal | | | | | |
| SITE LOCATION MAP | | | | | | | | | | |
| Drawn by JCB Checked by File 1514T001.dwg | | | | | | | | | | |
| Title Sheet; Drawing Index | | | | | | | | | | |
| T001 | | | | | | | | | | |

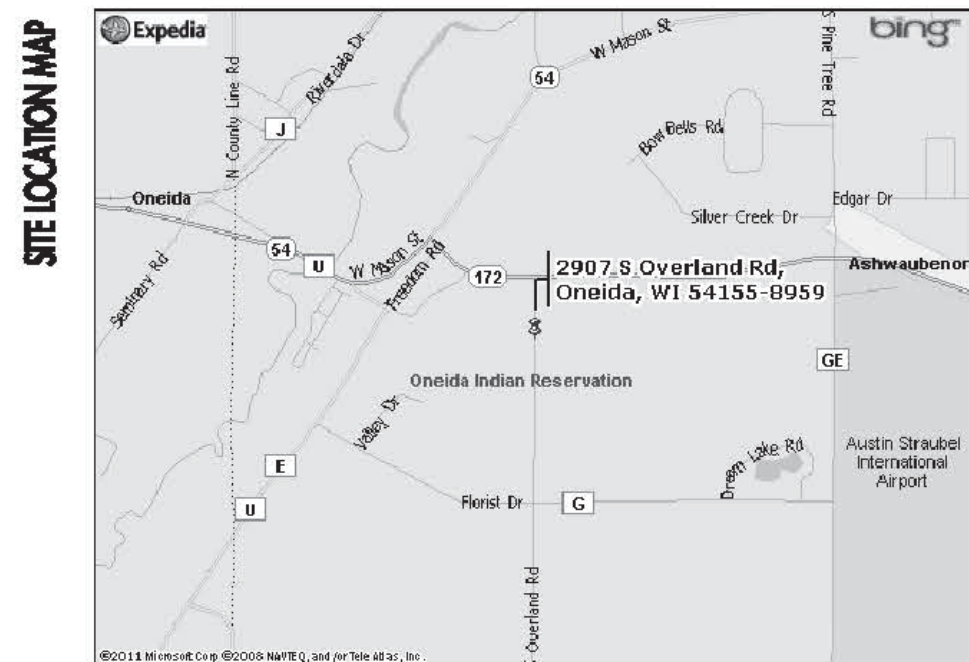

ONEIDA RESIDENT-CENTERED
CARE COMMUNITY
CIP #98-005
ONEIDA, WISCONSIN
Owner
ONEIDA TRIBE OF INDIANS OF WISCONSIN
P.O. Box 365
Oneida, WI 54155
Project No 051514


| No. | Description | Date |
|-----|------------------|------------|
| 01 | Plan Review | 09-27-2011 |
| 02 | Bid | 10-11-2011 |
| 03 | ASI-07 | 12-13-2011 |
| 04 | ASI-10 | 01-03-2012 |
| 05 | ASI-14 | 05-18-2012 |
| 06 | ASI-16 | 06-11-2012 |
| 07 | Record Documents | 02-11-2013 |

GENERAL NOTES

- A. DIMENSIONS TO INTERIOR WALLS:
ALL DIMENSION STRINGS SHOWN TO INTERIOR WALLS ARE TAKEN TO THE FACE OF CMU OR FACE OF CMU, UNLESS OTHERWISE NOTED. ANY INTERIOR WALL THICKNESSES SHOWN ON THE PLAN ARE OF THEIR NOMINAL (NOT ACTUAL) FINISHED THICKNESS.
- B. DIMENSIONS TO EXTERIOR WALLS:
ALL DIMENSION STRINGS SHOWN TO EXTERIOR WALLS ARE TAKEN TO THE FACE OF WOOD STUD OR FACE OF CMU, UNLESS OTHERWISE NOTED.
- C. SEE A301 FOR TYPICAL FLOOR PLANS OF EACH RESIDENT UNIT TYPE.
- D. UNLESS OTHERWISE NOTED, ALL FLOOR SLAB ELEVATIONS SHALL BE EL. 100'-0".

LEGEND

- SEE A401 FOR ALL ARCHITECTURAL SYMBOLS NOT INCLUDED IN THIS LEGEND
- FEC FIRE EXTINGUISHER CABINET FURNISHED AND INSTALLED BY CONTRACTOR, EXTINGUISHER SUPPLIED BY OWNER
- FE WALL-HUNG FIRE EXTINGUISHER FURNISHED AND INSTALLED BY OWNER
- AP WALL ACCESS PANEL AS SCHEDULED, BOTTOM OF PANEL TO BE AT 48" AFF, COORDINATE FINAL LOCATION WITH MECHANICAL CONTRACTOR
- DS DOWNSPOUT, SEE ROOF PLAN AND ELEVATIONS, SEE CIVIL FOR CONNECTION TO STORM SEWER

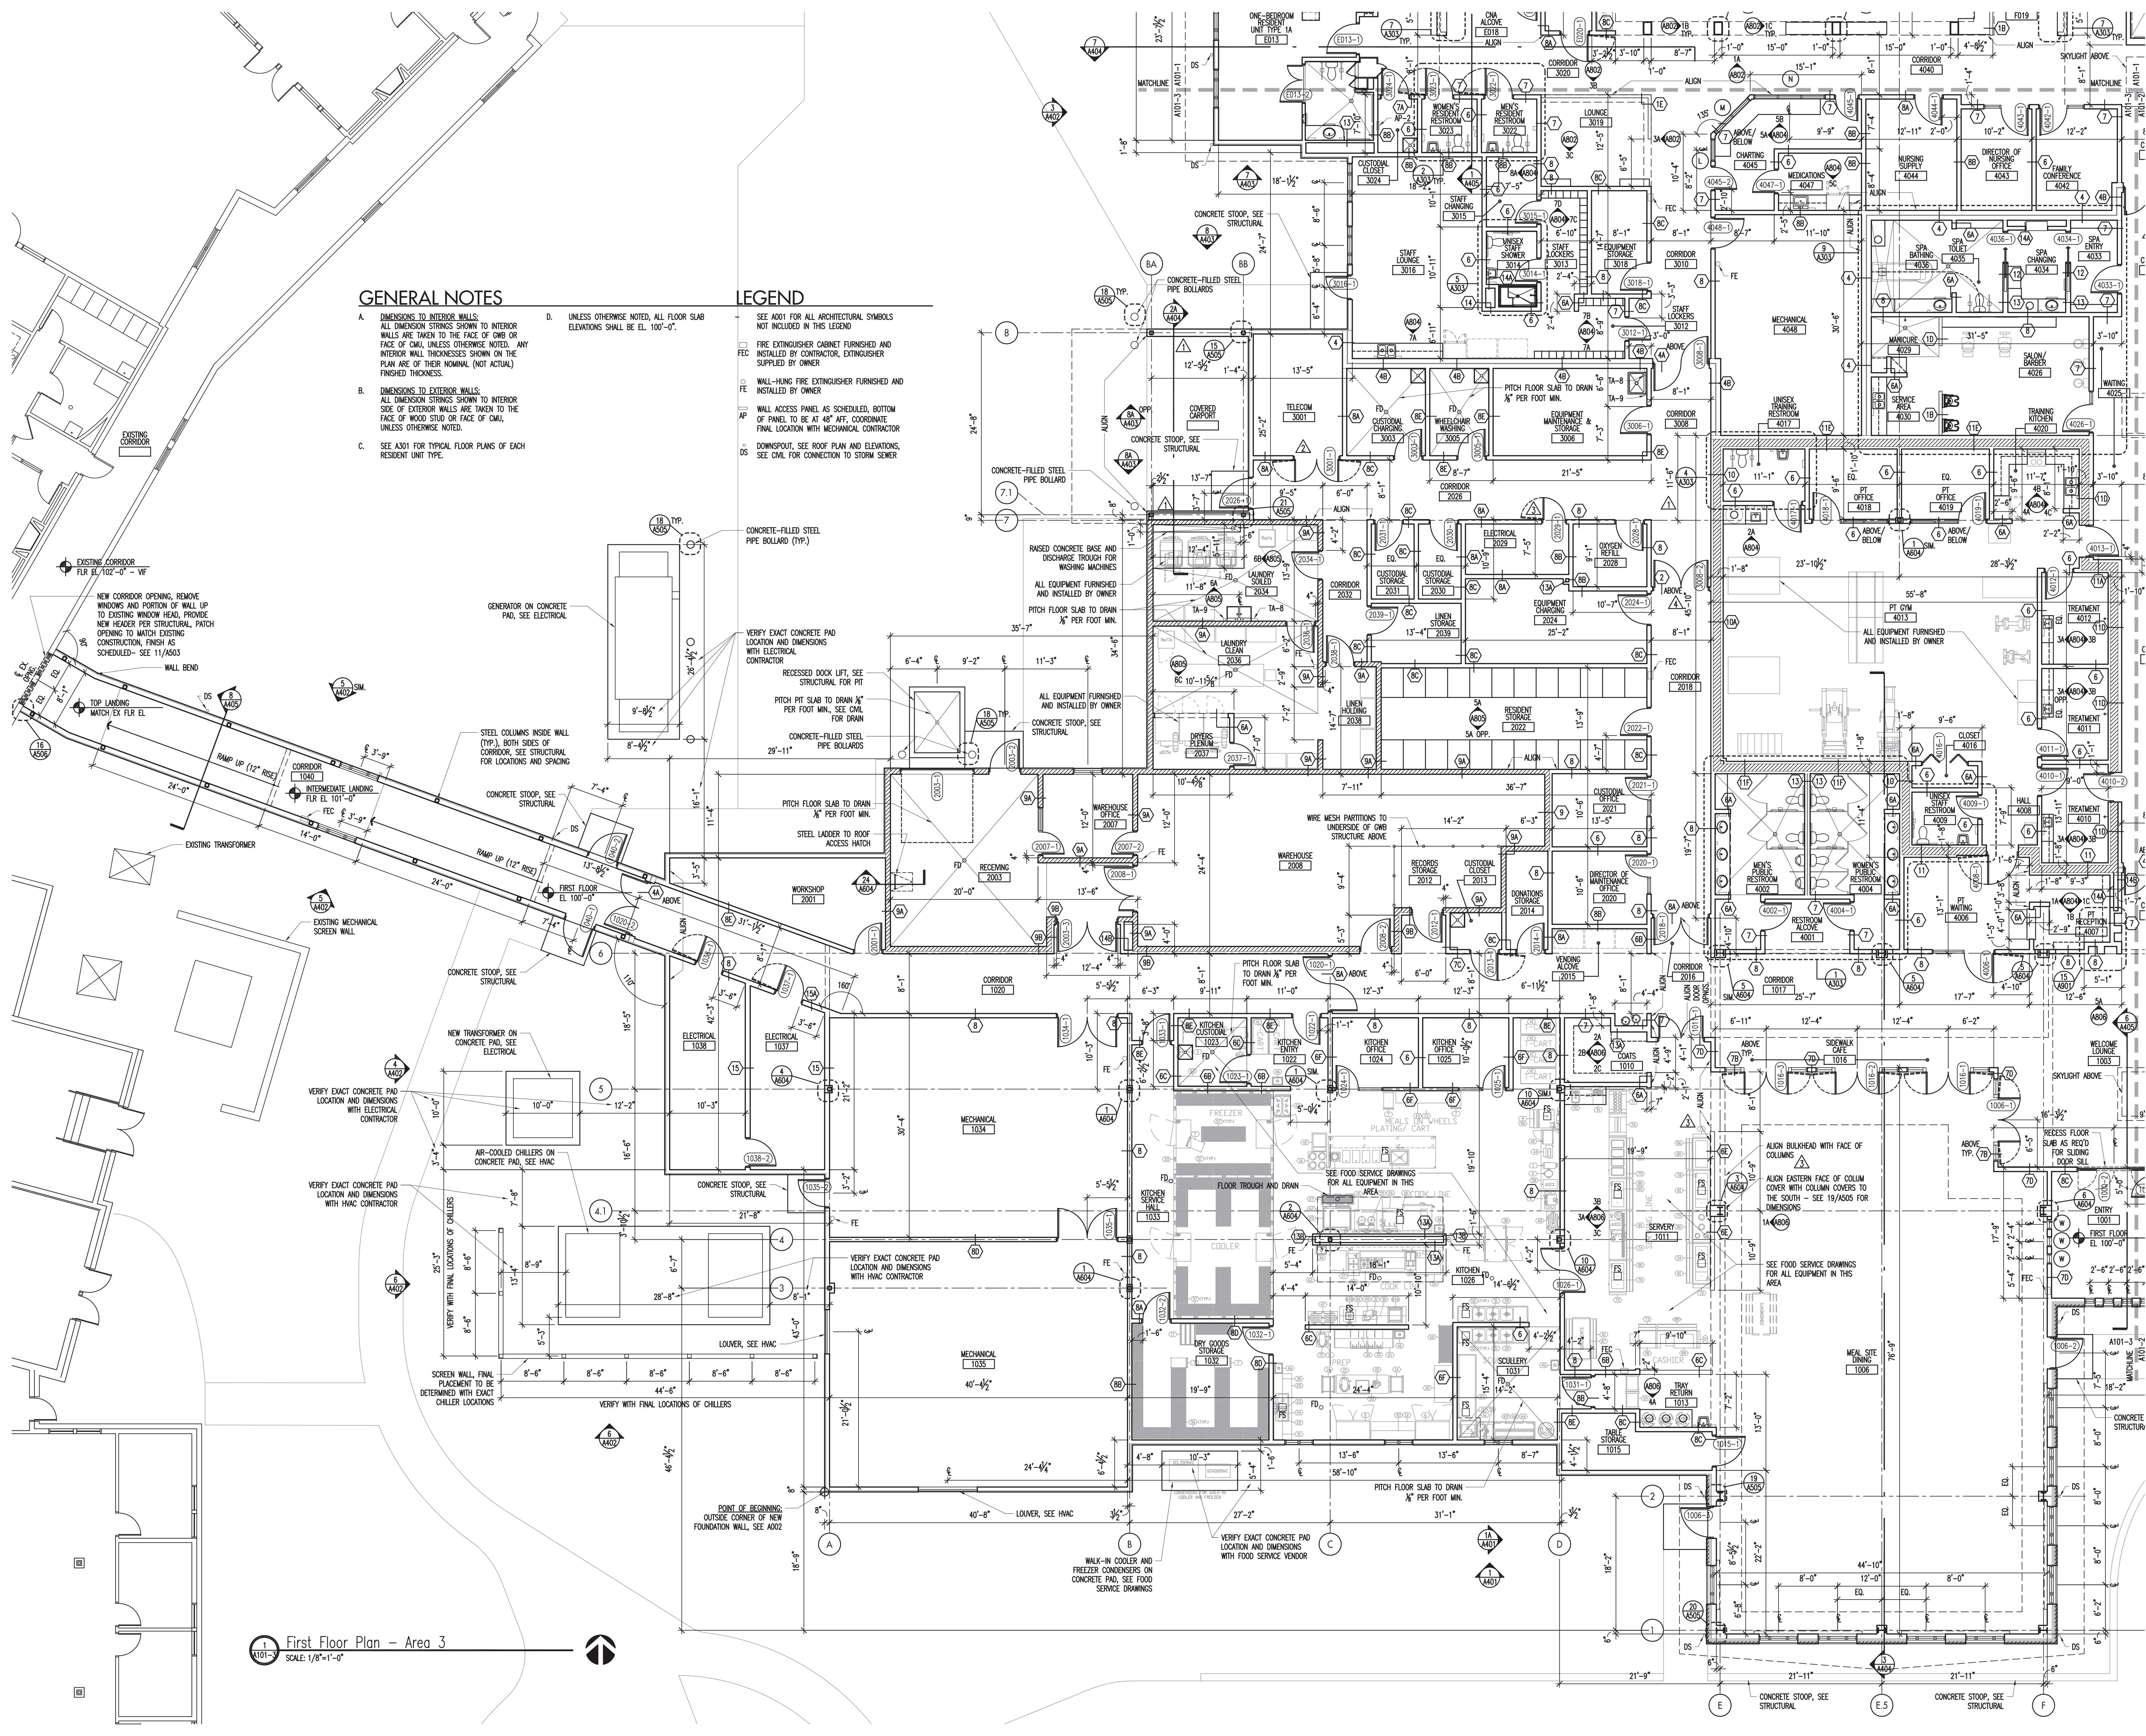

ONEIDA RESIDENT-CENTERED CARE COMMUNITY

CIP #98-005


ONEIDA, WISCONSIN

Owner
ONEIDA TRIBE OF INDIANS OF WISCONSIN
P.O. Box 365
Oneida, WI 54155


Project No 051514

Issued for:


| No. | Description | Date |
|-----|------------------|------------|
| 01 | Plan Review | 09-27-2011 |
| 02 | Bid | 10-11-2011 |
| 03 | Record Documents | 02-11-2013 |

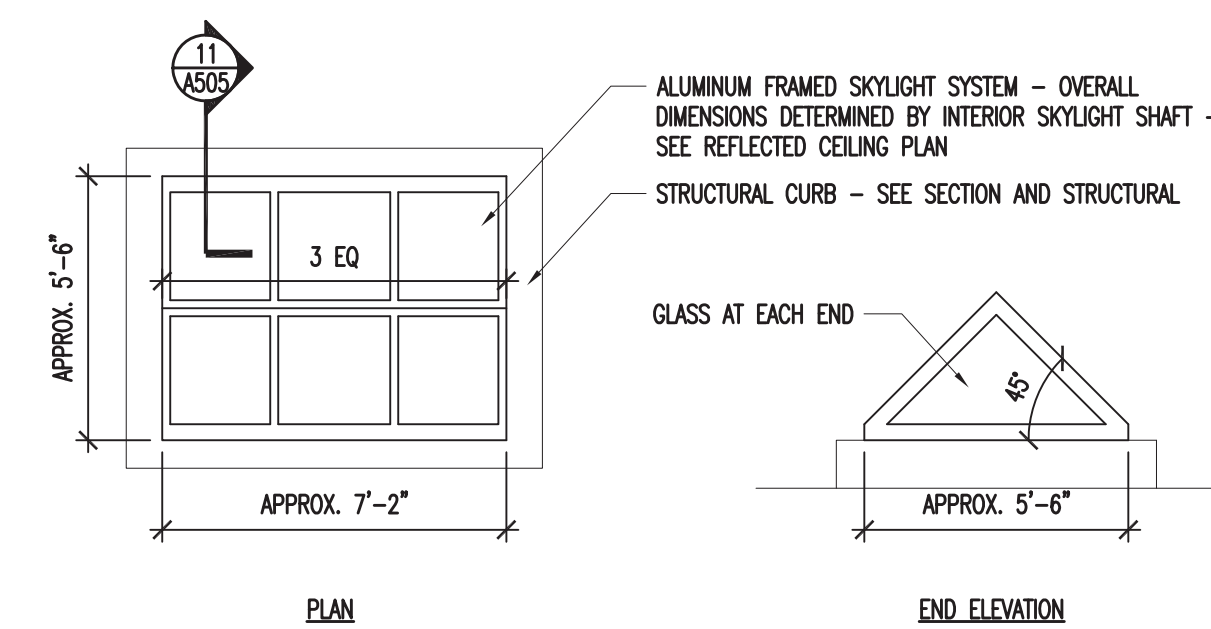


2 Skylight
SCALE: 1/4"=1'-0"

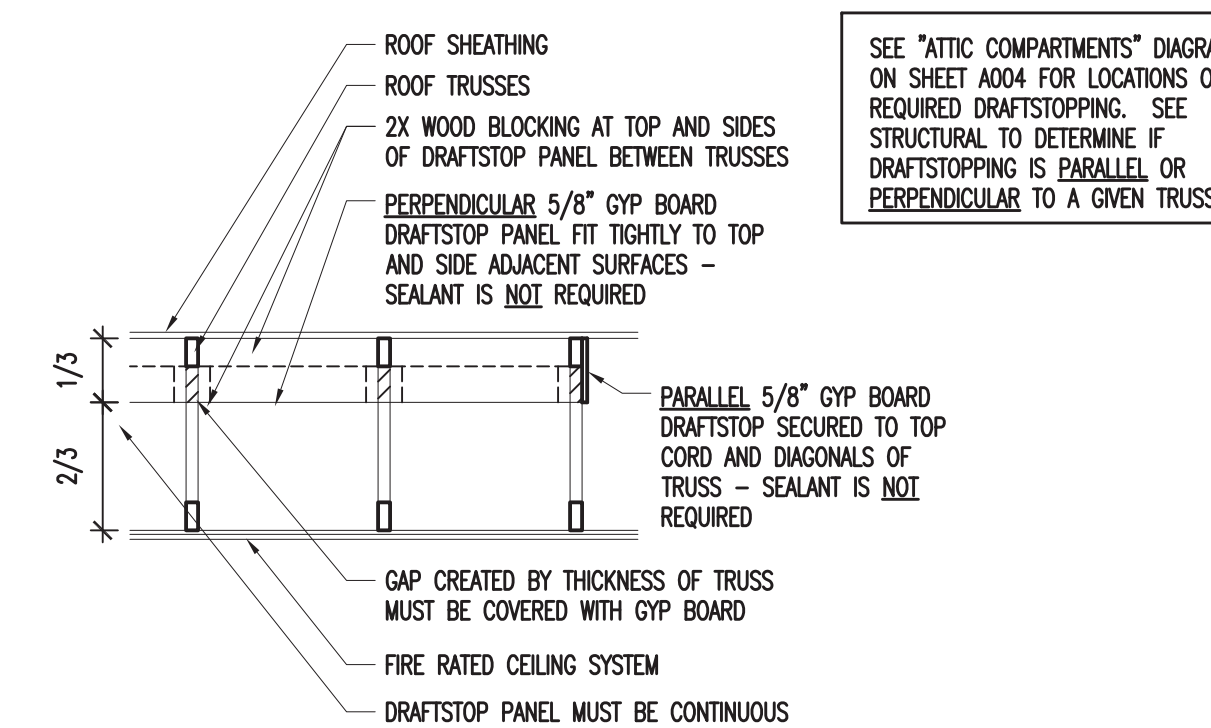



3 Draftstopping at Flat Roof Trusses
SCALE: 1/2"=1'-0"

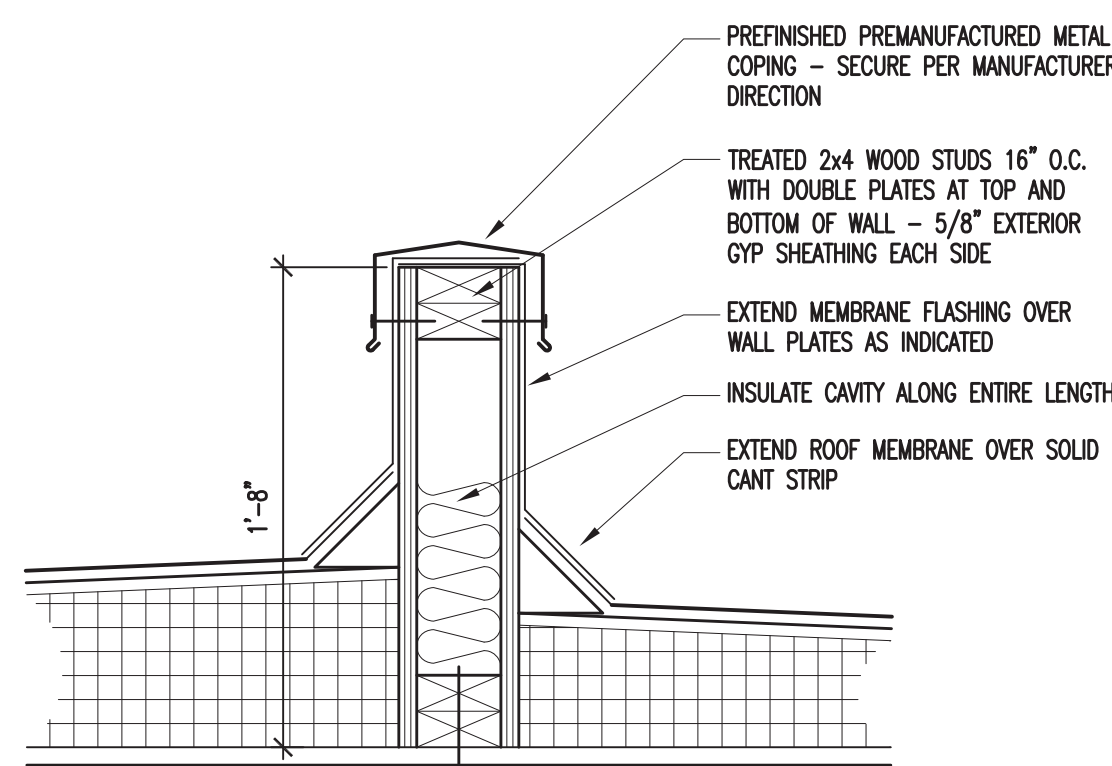

4 Roof Area Divider
SCALE: 1 1/2"=1'-0"

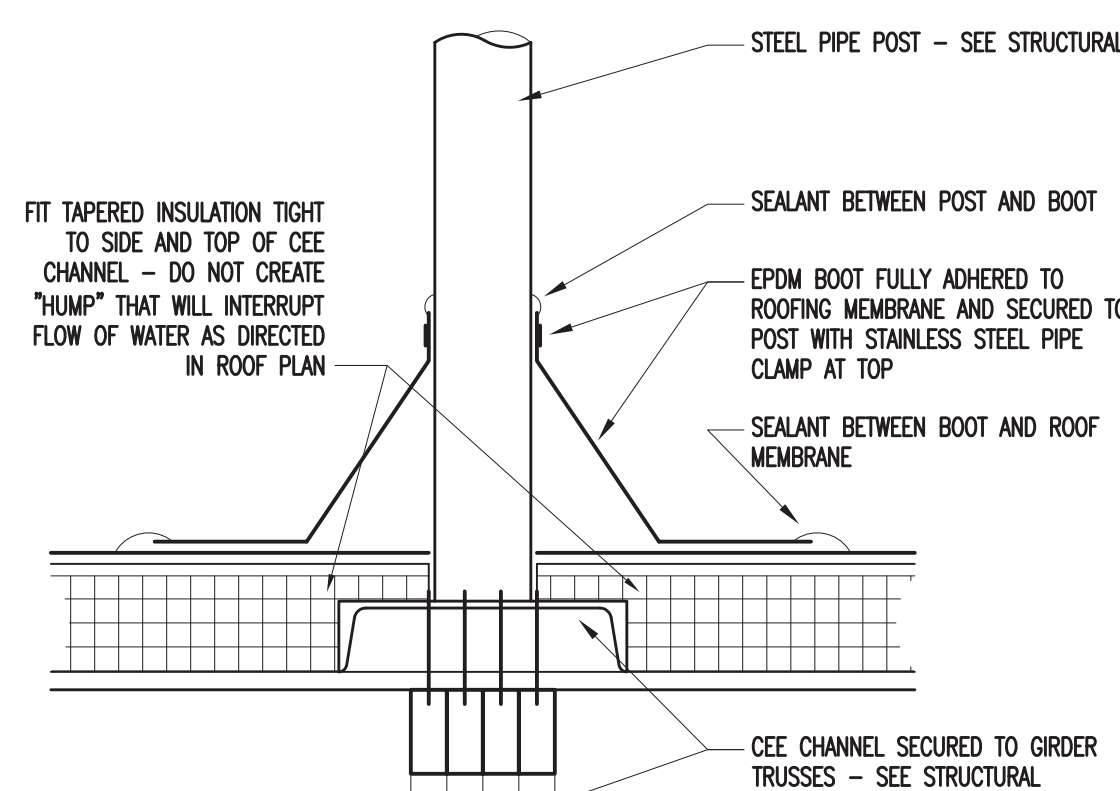


5 Solar Panel Frame - Base Detail
SCALE: 1 1/2"=1'-0"

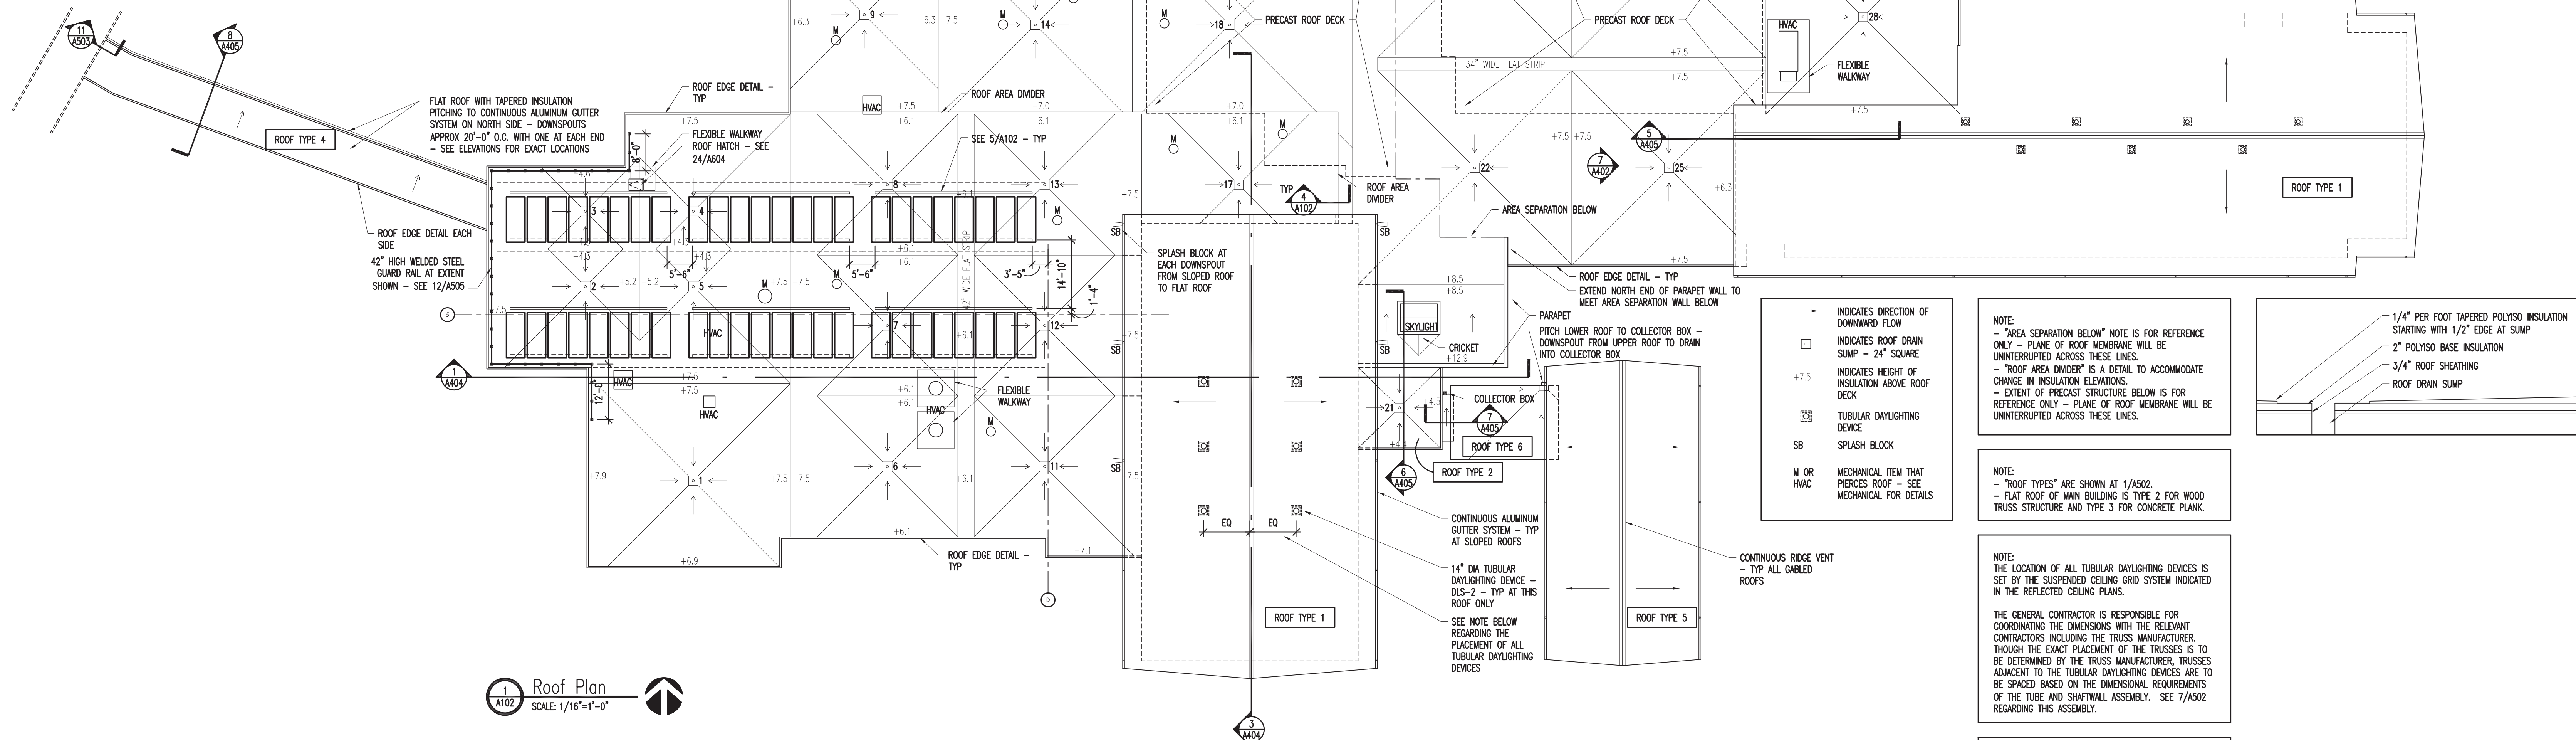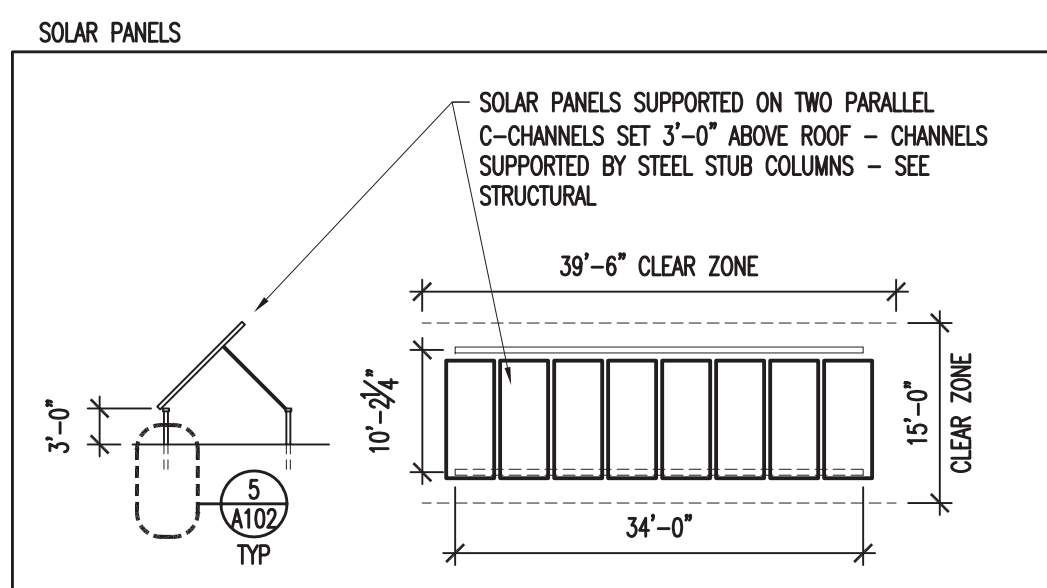

ONEIDA RESIDENT-CENTERED
CARE COMMUNITY
CIP #98-005
ONEIDA, WISCONSIN
Owner
ONEIDA TRIBE OF INDIANS OF WISCONSIN
P.O. Box 365
Oneida, WI 54155
Project No 051514

Issued For:


| No. | Description | Date |
|-----|------------------|------------|
| 01 | Plan Review | 09-27-2011 |
| 02 | Bid | 10-11-2011 |
| 03 | ASI-08 | 12-22-2011 |
| 04 | ASI-16 | 06-11-2012 |
| 05 | Record Documents | 02-11-2013 |

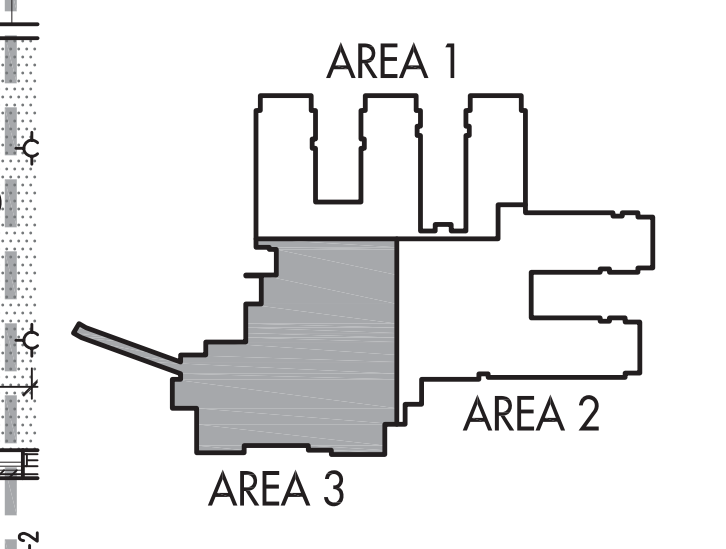

Drawn by JCB
Checked by JWH
File 1514A201-1_to_A201-3.dwg

First Floor Reflected Ceiling Plan -
Area 3

A201-3

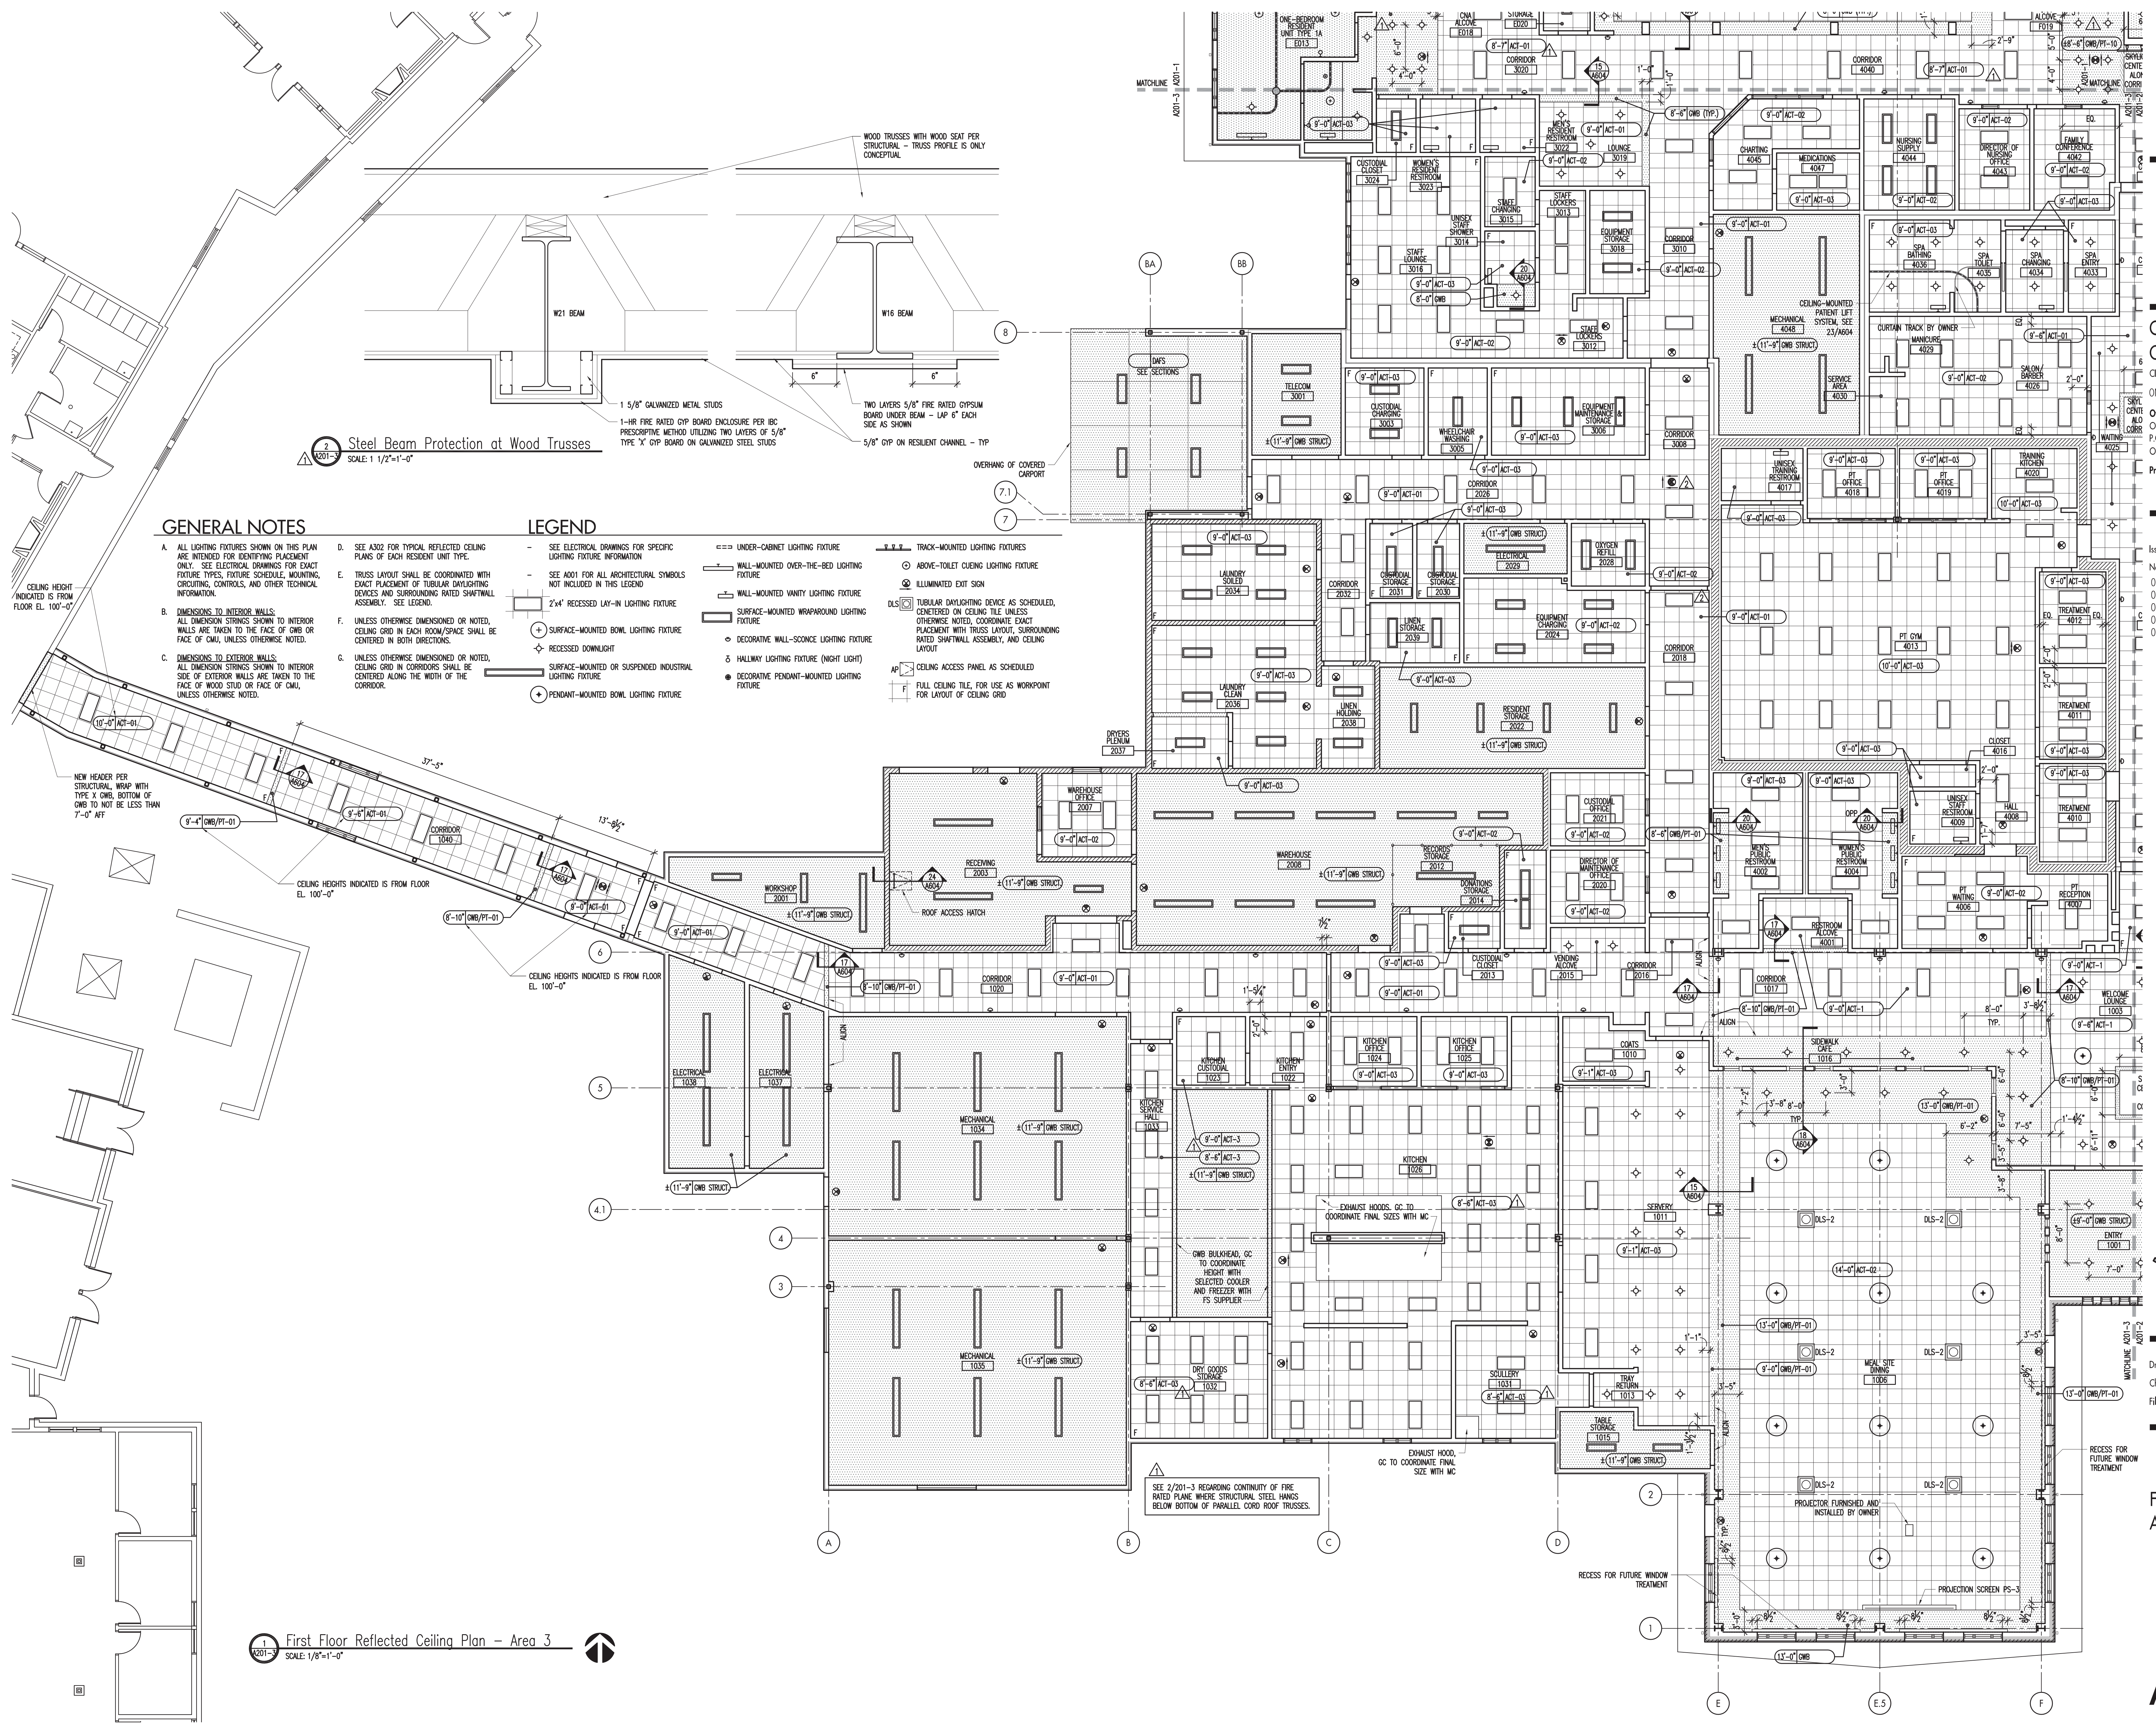

GENERAL NOTES

- A. ALL LIGHTING FIXTURES SHOWN ON THIS PLAN ARE INTENDED FOR IDENTIFYING PLACEMENT ONLY. SEE ELECTRICAL DRAWINGS FOR EXACT FIXTURE TYPES, FIXTURE SCHEDULE, MOUNTING, ORIENTING, CONTROLS, AND OTHER TECHNICAL INFORMATION.
- B. DIMENSIONS TO INTERIOR WALLS: ALL DIMENSION STRINGS SHOWN TO INTERIOR WALLS ARE TAKEN TO THE FACE OF GMB OR FACE OF CMU, UNLESS OTHERWISE NOTED.
- C. DIMENSIONS TO EXTERIOR WALLS: ALL DIMENSION STRINGS SHOWN TO INTERIOR SIDE OF EXTERIOR WALLS ARE TAKEN TO THE FACE OF WOOD STUD OR FACE OF CMU, UNLESS OTHERWISE NOTED.
- D. SEE A302 FOR TYPICAL REFLECTED CEILING PLANS OF EACH RESIDENT UNIT TYPE.
- E. TRUSS LAYOUT SHALL BE COORDINATED WITH EXACT PLACEMENT OF TUBULAR DAYLIGHTING DEVICES AND SURROUNDING RATED SHAFTWALL ASSEMBLY. SEE LEGEND.
- F. UNLESS OTHERWISE DIMENSIONED OR NOTED, CEILING GRID IN EACH ROOM/SPACE SHALL BE CENTERED IN BOTH DIRECTIONS.
- G. UNLESS OTHERWISE DIMENSIONED OR NOTED, CEILING GRID IN CORRIDORS SHALL BE CENTERED ALONG THE WIDTH OF THE CORRIDOR.

LEGEND

- UNDER-CABINET LIGHTING FIXTURE
- WALL-MOUNTED OVER-THE-BED LIGHTING FIXTURE
- WALL-MOUNTED VANITY LIGHTING FIXTURE
- SURFACE-MOUNTED WRAPAROUND LIGHTING FIXTURE
- RECESSED DOWNLIGHT
- SURFACE-MOUNTED OR SUSPENDED INDUSTRIAL LIGHTING FIXTURE
- PENDANT-MOUNTED BOWL LIGHTING FIXTURE
- SEE ELECTRICAL DRAWINGS FOR SPECIFIC LIGHTING FIXTURE INFORMATION
- SEE A001 FOR ALL ARCHITECTURAL SYMBOLS NOT INCLUDED IN THIS LEGEND
- 2'x4' RECESSED LAY-IN LIGHTING FIXTURE
- SURFACE-MOUNTED BOWL LIGHTING FIXTURE
- RECESSED DOWNLIGHT
- SURFACE-MOUNTED OR SUSPENDED INDUSTRIAL LIGHTING FIXTURE
- PENDANT-MOUNTED BOWL LIGHTING FIXTURE
- TRACK-MOUNTED LIGHTING FIXTURES
- ABOVE-TOILET CLUING LIGHTING FIXTURE
- ILLUMINATED EXIT SIGN
- TUBULAR DAYLIGHTING DEVICE AS SCHEDULED, CENTERED ON CEILING TILE UNLESS OTHERWISE NOTED, COORDINATE EXACT PLACEMENT WITH TRUSS LAYOUT, SURROUNDING RATED SHAFTWALL ASSEMBLY, AND CEILING LAYOUT
- CEILING ACCESS PANEL AS SCHEDULED
- FULL CEILING TILE, FOR USE AS WORKPOINT FOR LAYOUT OF CEILING GRID

1 First Floor Reflected Ceiling Plan - Area 3
SCALE: 1/8"=1'-0"

ONEIDA RESIDENT-CENTERED
CARE COMMUNITY

CIP #98-005


ONEIDA, WISCONSIN

Owner
ONEIDA TRIBE OF INDIANS OF WISCONSIN
P.O. Box 365
Oneida, WI 54155

Project No 051514


Issued For:

| No. | Description | Date |
|-----|------------------|------------|
| 01 | Plan Review | 09-27-2011 |
| 02 | Bid | 10-11-2011 |
| 03 | Record Documents | 02-11-2013 |

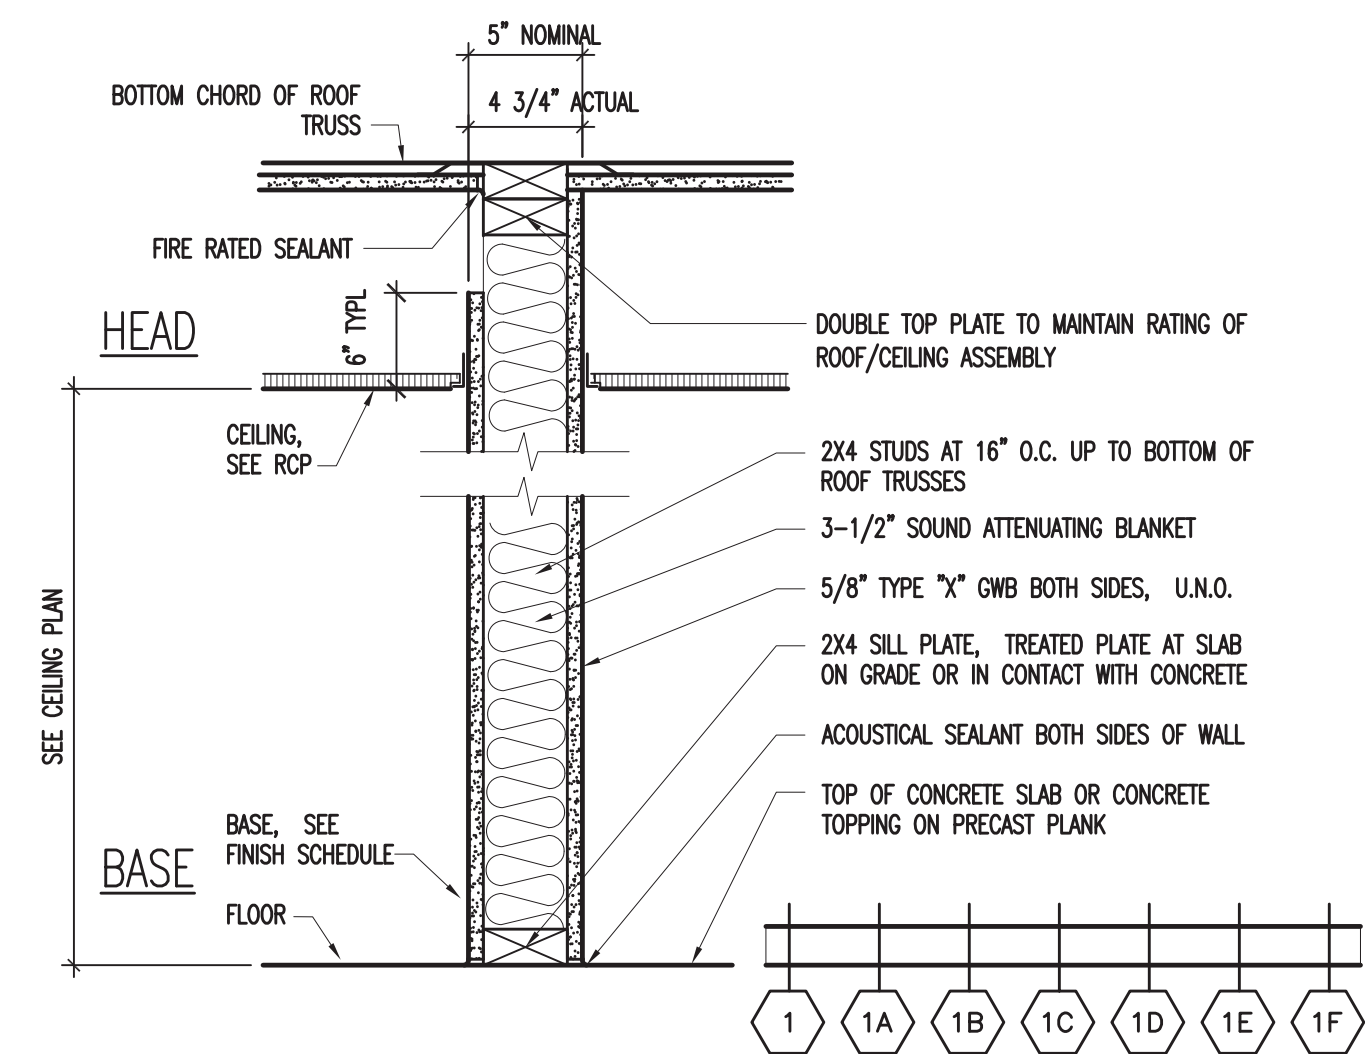


- 1A SAME AS WALL TYPE 1 WITHOUT SOUND ATTENUATING BLANKET
- 1B SAME AS WALL TYPE 1 WITHOUT SOUND ATTENUATING BLANKET AND PROVIDE 5/8" TYPE "X" ABUSE RESISTANT GWB UP TO 4'-0" A.F.F. ON CORRIDOR SIDE. SEE INTERIOR ELEVATIONS FOR HEIGHT OF WALL.
- 1C SAME AS WALL TYPE 1 WITHOUT SOUND ATTENUATING BLANKET AND PROVIDE 5/8" TYPE "X" ABUSE RESISTANT GWB UP TO 4'-0" A.F.F. ON BOTH SIDES OF WALL.
- 1D SAME AS WALL TYPE 1 WITHOUT SOUND ATTENUATING BLANKET. SEE INTERIOR ELEVATIONS FOR HEIGHT OF WALL.
- 1E SAME AS WALL TYPE 1 WITHOUT SOUND ATTENUATING BLANKET AND PROVIDE 5/8" TYPE "X" ABUSE RESISTANT GWB UP TO 4'-0" A.F.F. ON BOTH SIDES OF WALL. SEE INTERIOR ELEVATIONS FOR HEIGHT OF WALL.
- 1F SAME AS WALL TYPE 1 WITHOUT SOUND ATTENUATING BLANKET AND PROVIDE 5/8" TYPE "X" ABUSE RESISTANT GWB UP TO 4'-0" A.F.F. ON ONE SIDE OF WALL.

1 WALL TYPE (1)
SCALE: 1 1/2"=1'-0"

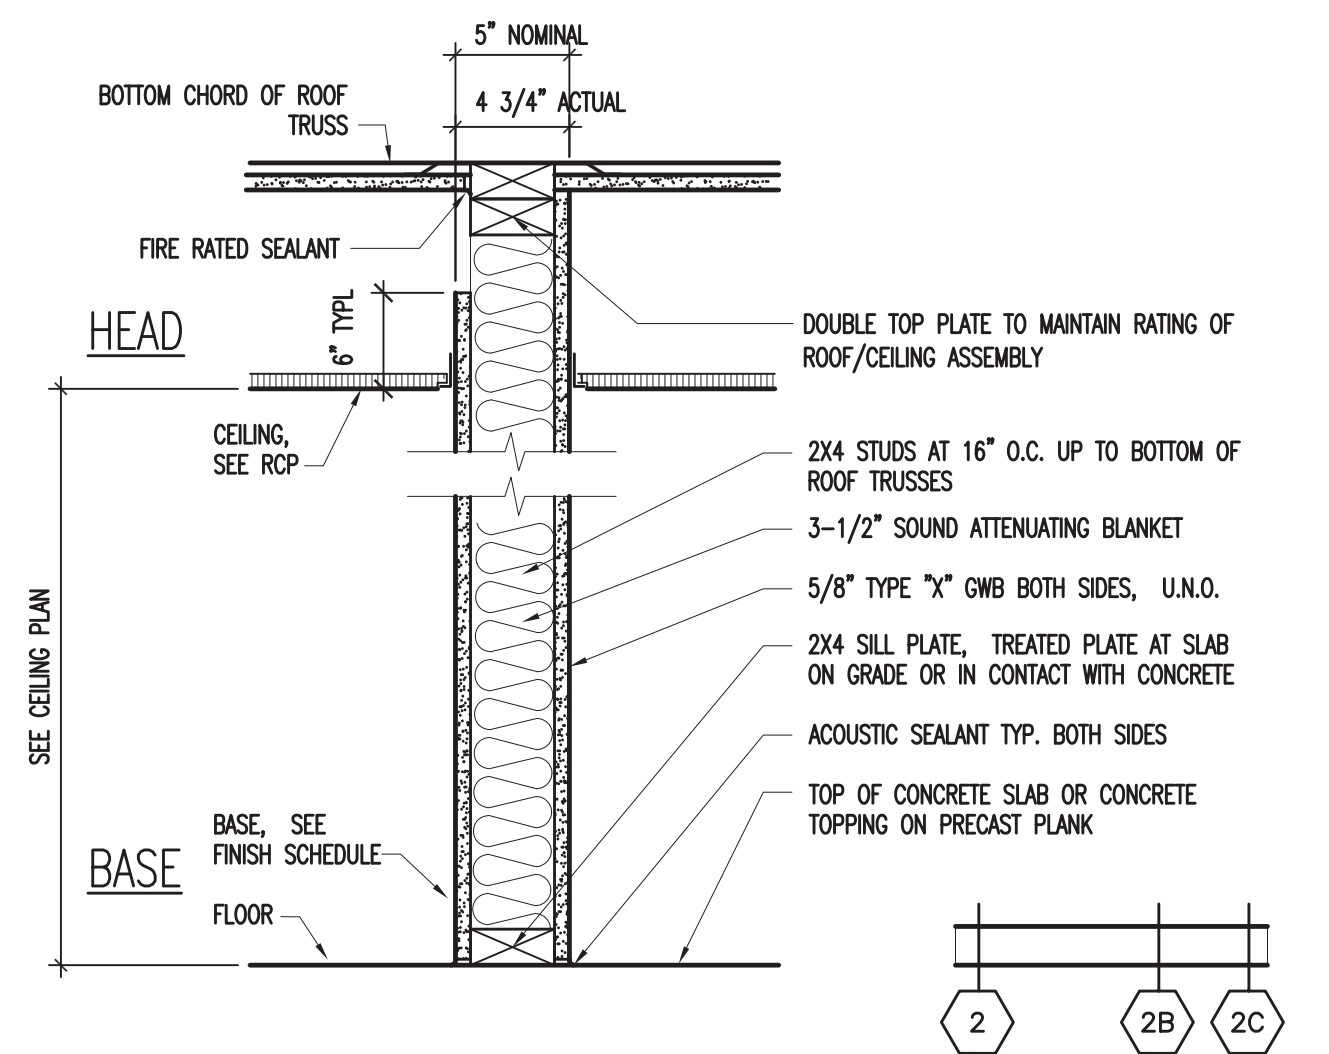


- 2B SAME AS WALL TYPE 2 WITHOUT SOUND ATTENUATING BLANKET AND PROVIDE 5/8" TYPE "X" ABUSE RESISTANT GWB UP TO 4'-0" A.F.F. ON CORRIDOR SIDE OF WALL.
- 2C SAME AS WALL TYPE 2 EXCEPT PROVIDE 5/8" TYPE "X" ABUSE RESISTANT GWB UP TO 4'-0" A.F.F. ON CORRIDOR SIDE OF WALL.

2 WALL TYPE (2)
SCALE: 1 1/2"=1'-0"

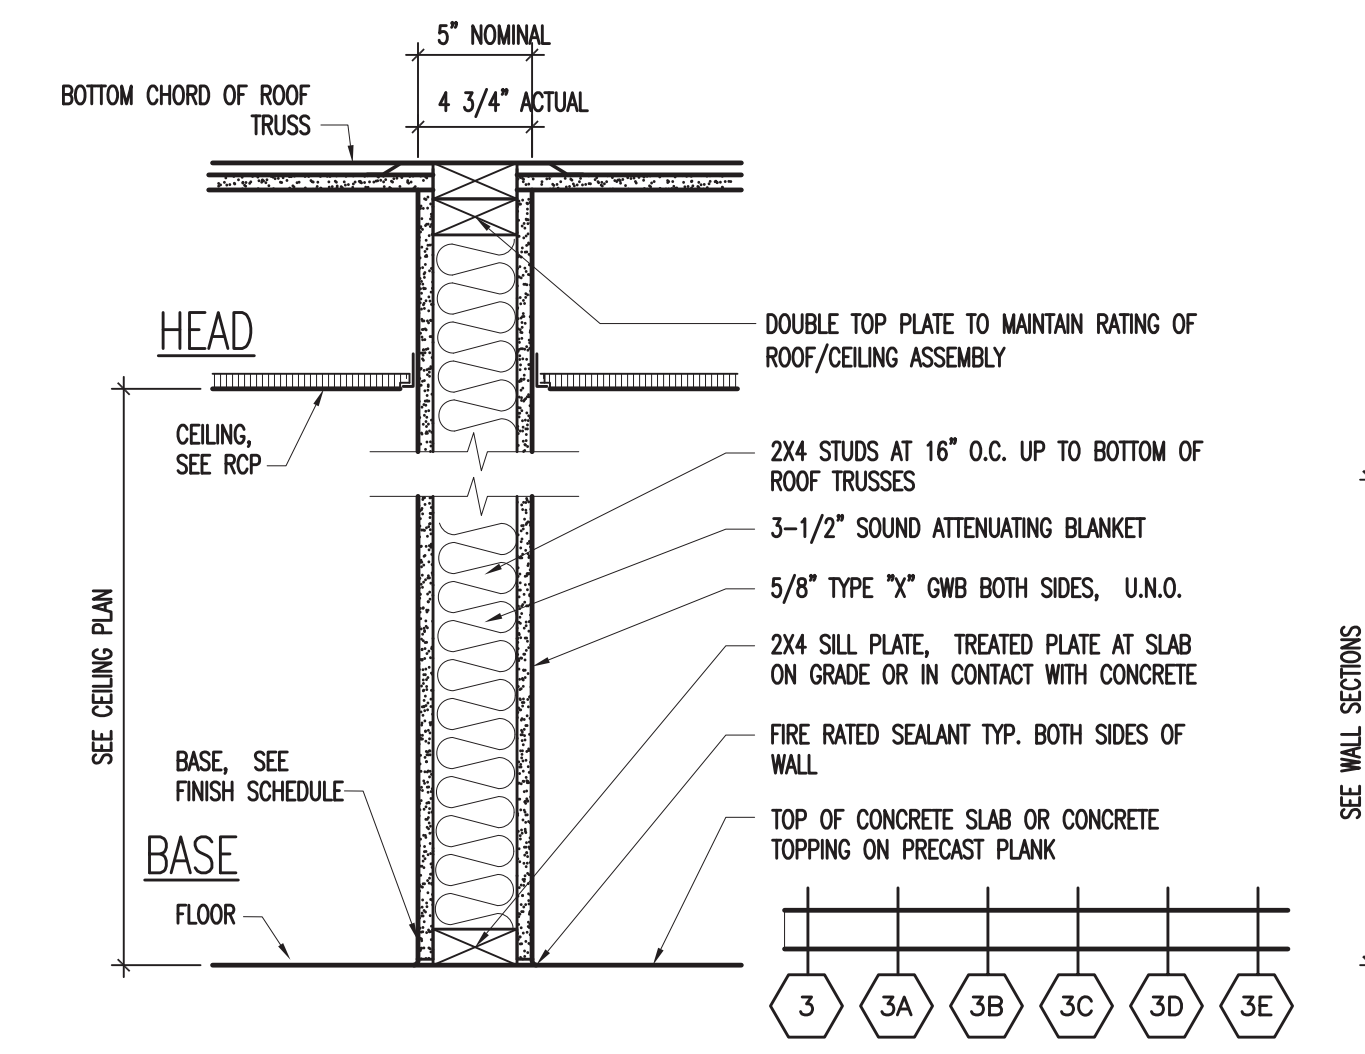


- 3A SAME AS WALL TYPE 3 WITHOUT SOUND ATTENUATING BLANKET
- 3B SAME AS WALL TYPE 3 WITHOUT SOUND ATTENUATING BLANKET AND PROVIDE 5/8" TYPE "X" ABUSE RESISTANT GWB UP TO 4'-0" A.F.F. ON BOTH SIDES OF WALL.
- 3C SAME AS WALL TYPE 3 WITHOUT SOUND ATTENUATING BLANKET AND PROVIDE 5/8" TYPE "X" ABUSE RESISTANT GWB UP TO 4'-0" A.F.F. ON ONE SIDE OF WALL.
- 3D SAME AS WALL TYPE 3 EXCEPT PROVIDE 5/8" TYPE "X" ABUSE RESISTANT GWB UP TO 4'-0" A.F.F. ON ONE SIDE OF WALL.
- 3E SAME AS WALL TYPE 3 EXCEPT PROVIDE 5/8" TYPE "X" ABUSE RESISTANT GWB UP TO 4'-0" A.F.F. ON BOTH SIDES OF WALL.

3 WALL TYPE (3)
SCALE: 1 1/2"=1'-0"

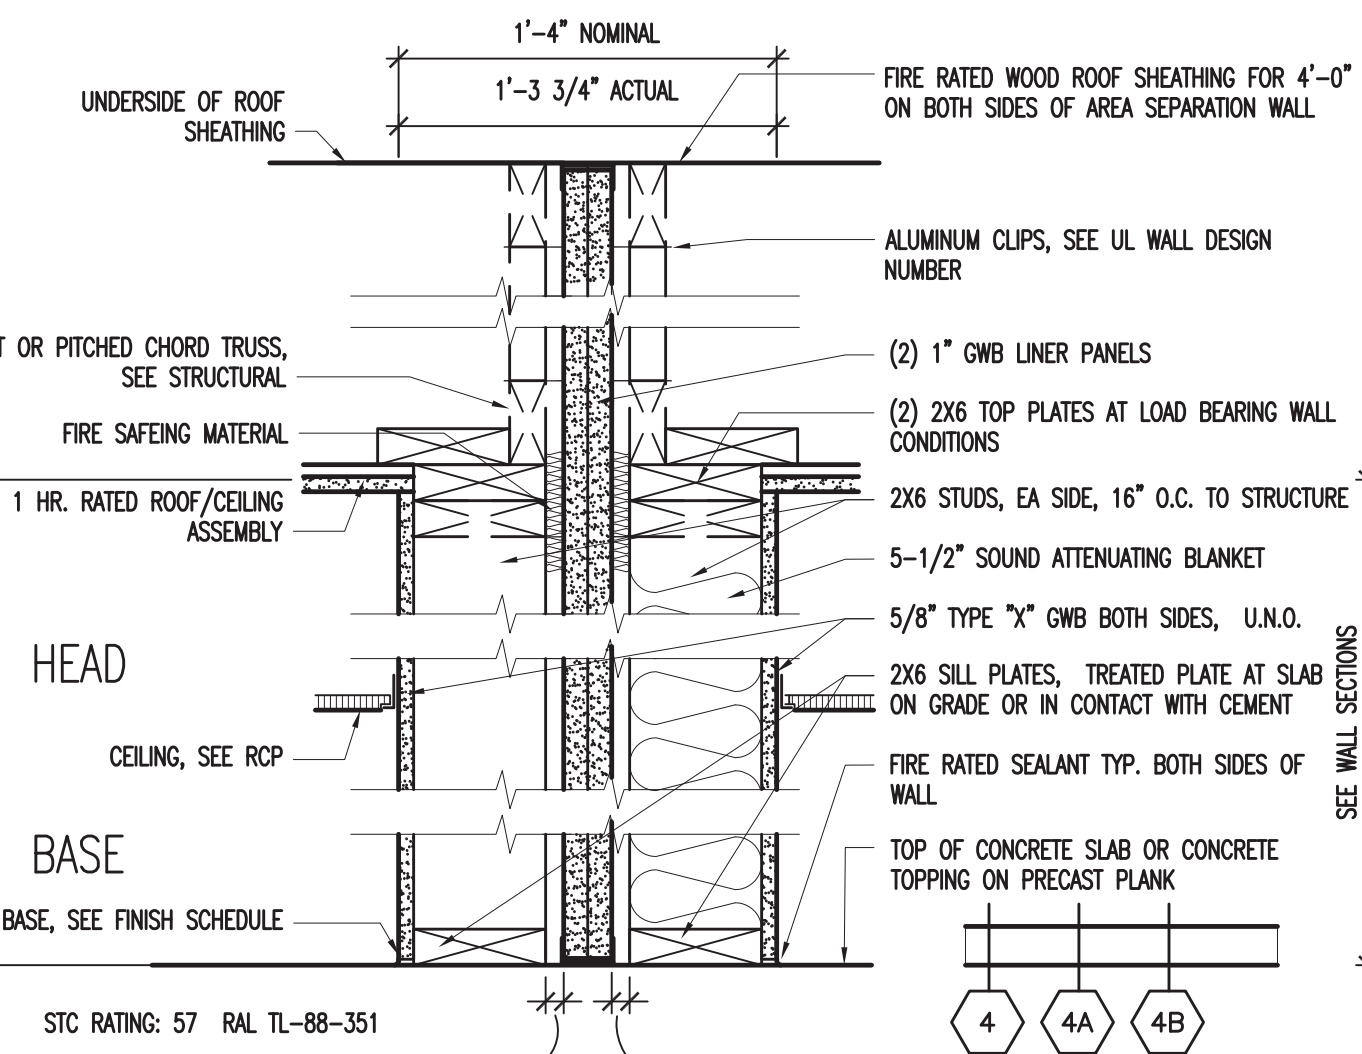


- 4A SAME AS WALL TYPE 4 WITHOUT SOUND ATTENUATING BLANKET
- 4B SAME AS WALL TYPE 4 EXCEPT PROVIDE 5/8" TYPE "X" ABUSE RESISTANT GWB UP TO 4'-0" A.F.F. ON ONE SIDE OF WALL.

4 WALL TYPE (4)
SCALE: 1 1/2"=1'-0"

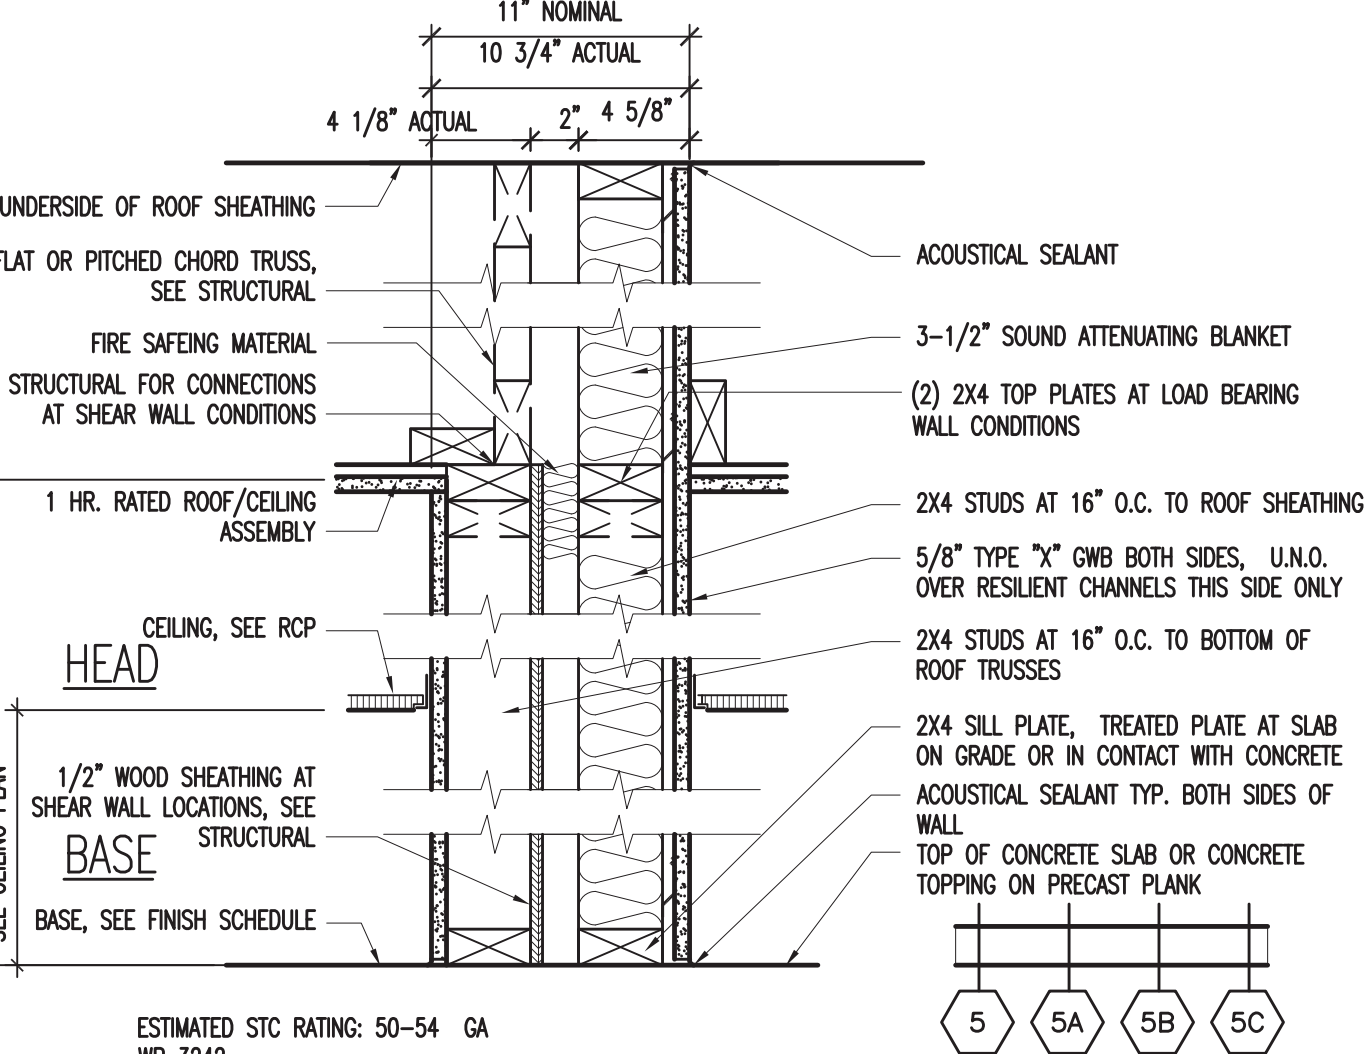


- 5A SAME AS WALL TYPE 5 EXCEPT PROVIDE 5/8" TYPE "X" ABUSE RESISTANT GWB UP TO 4'-0" A.F.F. ON CORRIDOR SIDE OF WALL.
- 5B UL DES U341, 1-HOUR RATED. SAME AS WALL TYPE 5 EXCEPT PROVIDE 3-1/2" SOUND ATTENUATING BLANKET IN BOTH STUD CAVITIES AND PROVIDE 5/8" TYPE "X" ABUSE RESISTANT GWB UP TO 4'-0" A.F.F. ON NON-RESIDENT ROOM SIDE OF WALL.
- 5C UL DES U341, 1-HOUR RATED. SAME AS WALL TYPE 5 EXCEPT PROVIDE 3-1/2" SOUND ATTENUATING BLANKET IN BOTH STUD CAVITIES.

5 WALL TYPE (5)
SCALE: 1 1/2"=1'-0"

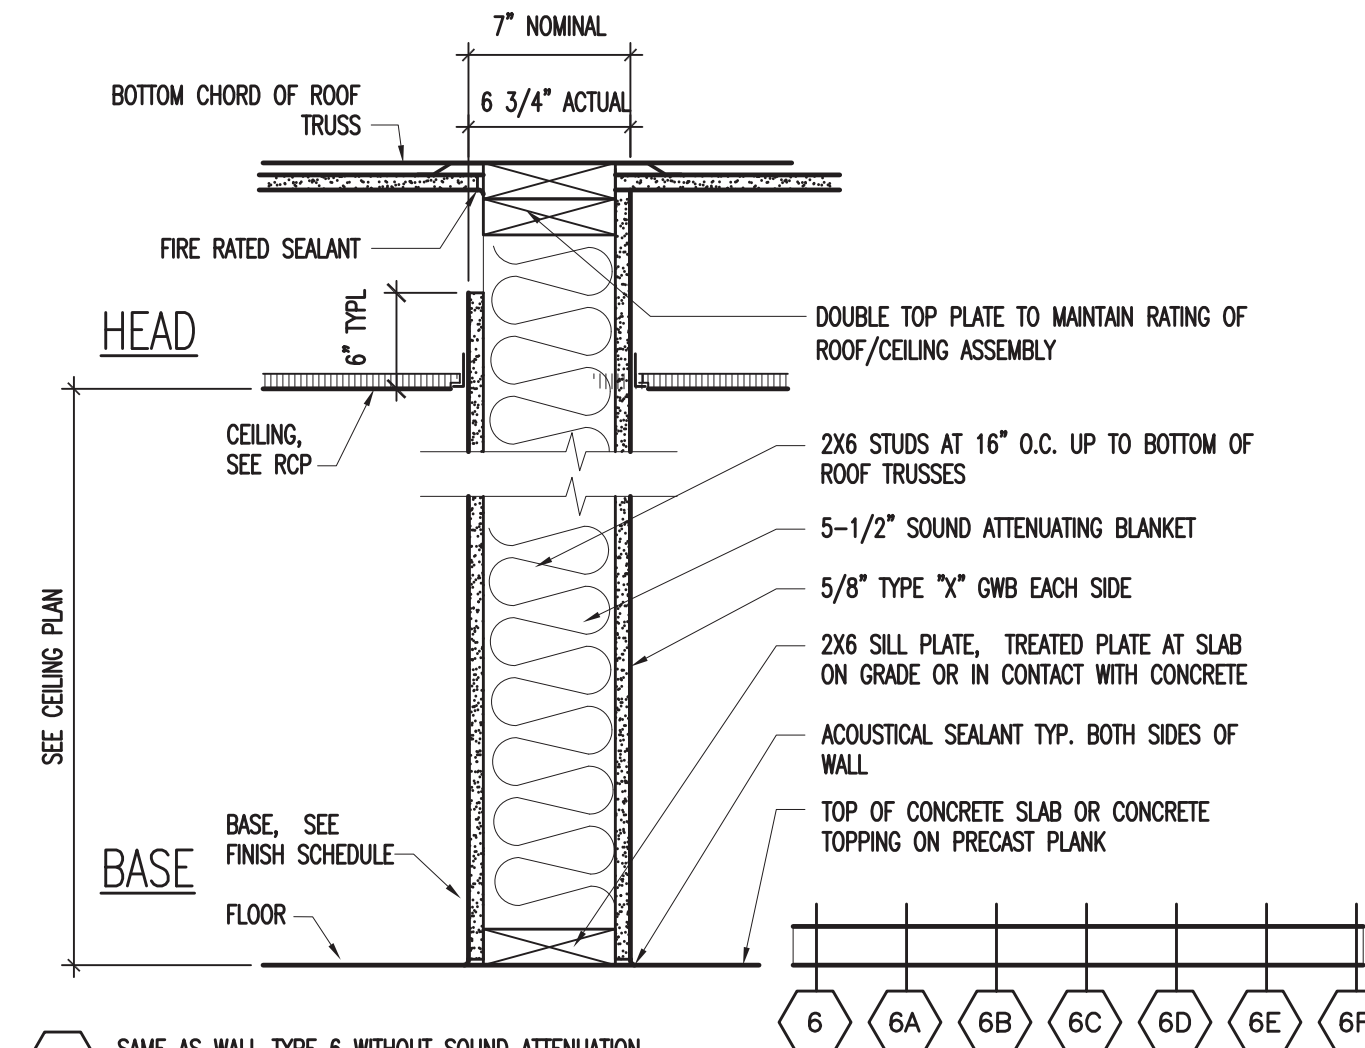


- 6A SAME AS WALL TYPE 6 WITHOUT SOUND ATTENUATING BLANKET
- 6B SAME AS WALL TYPE 6 WITHOUT SOUND ATTENUATING BLANKET AND PROVIDE 5/8" TYPE "X" ABUSE RESISTANT GWB UP TO 4'-0" A.F.F. ON CORRIDOR SIDE OF WALL.
- 6C SAME AS WALL TYPE 6 WITHOUT SOUND ATTENUATING BLANKET AND PROVIDE 5/8" TYPE "X" ABUSE RESISTANT GWB UP TO 4'-0" A.F.F. ON BOTH SIDES OF WALL.
- 6D SAME AS WALL TYPE 6 WITHOUT SOUND ATTENUATING BLANKET. SEE INTERIOR ELEVATIONS FOR HEIGHT OF WALL.
- 6E SAME AS WALL TYPE 6 WITHOUT SOUND ATTENUATING BLANKET AND PROVIDE 5/8" TYPE "X" ABUSE RESISTANT GWB UP TO 4'-0" A.F.F. ON ONE SIDE OF WALL. SEE INTERIOR ELEVATIONS FOR HEIGHT OF WALL.
- 6F SAME AS WALL TYPE 6 EXCEPT PROVIDE 5/8" TYPE "X" ABUSE RESISTANT GWB UP TO 4'-0" A.F.F. ON ONE SIDE OF WALL.

6 WALL TYPE (6)
SCALE: 1 1/2"=1'-0"

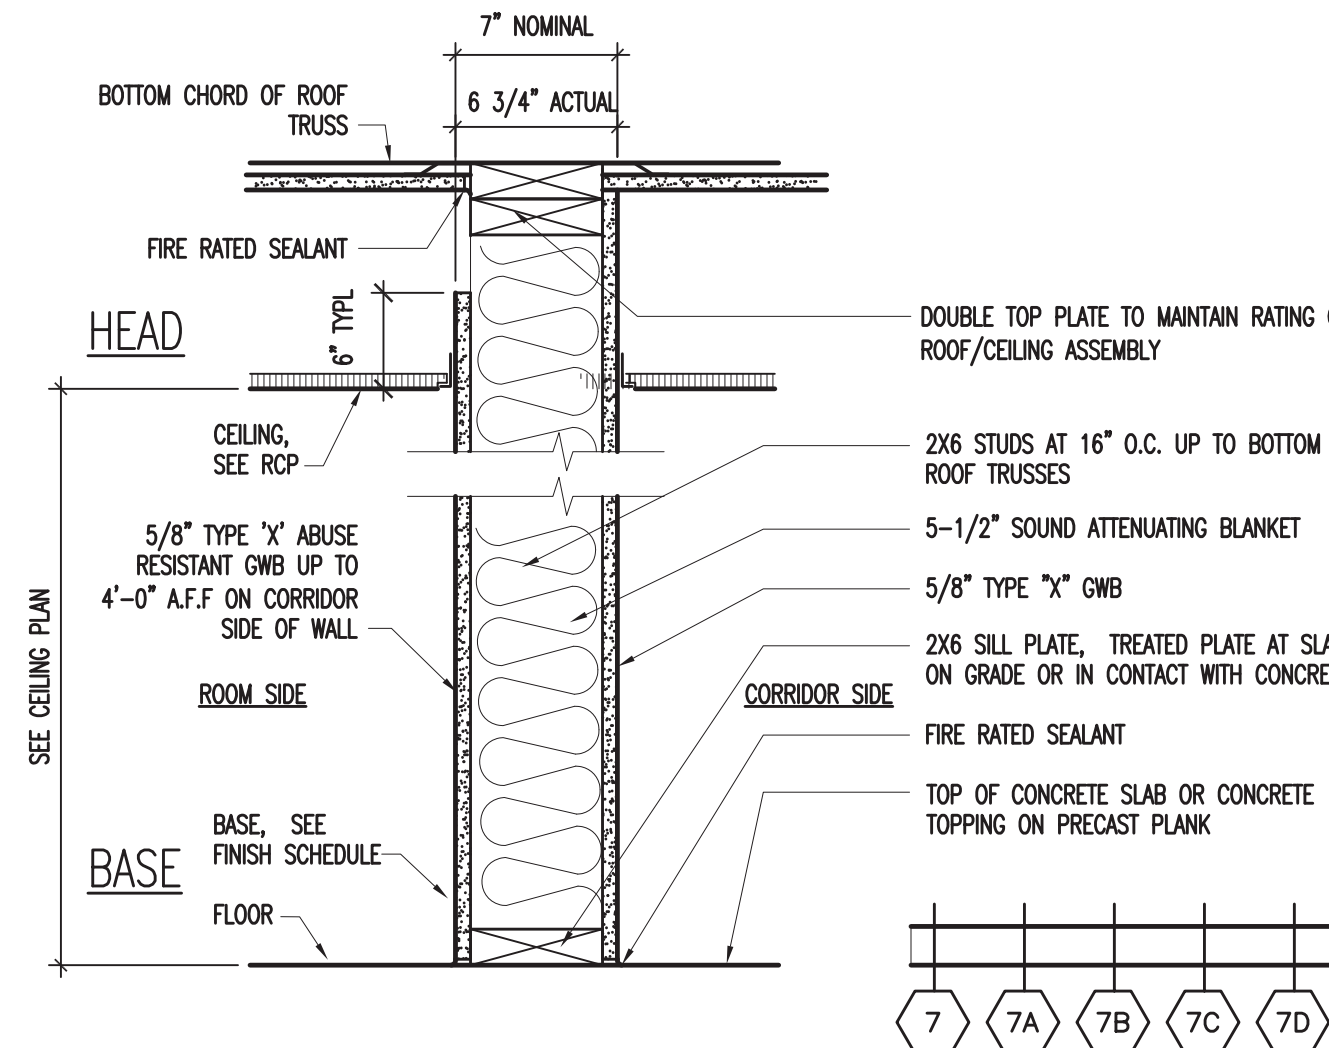


- 7A SAME AS WALL TYPE 7 WITHOUT SOUND ATTENUATING BLANKET, SMOKE TIGHT
- 7B SAME AS WALL TYPE 7 WITH 5/8" TYPE "X" GWB BOTH SIDES OF STUDS IN LIEU OF ABUSE RESISTANT GWB
- 7C SAME AS WALL TYPE 7 WITHOUT SOUND ATTENUATING BLANKET AND PROVIDE 5/8" TYPE "X" GWB ON BOTH SIDES OF WALL.

7 WALL TYPE (7)
SCALE: 1 1/2"=1'-0"

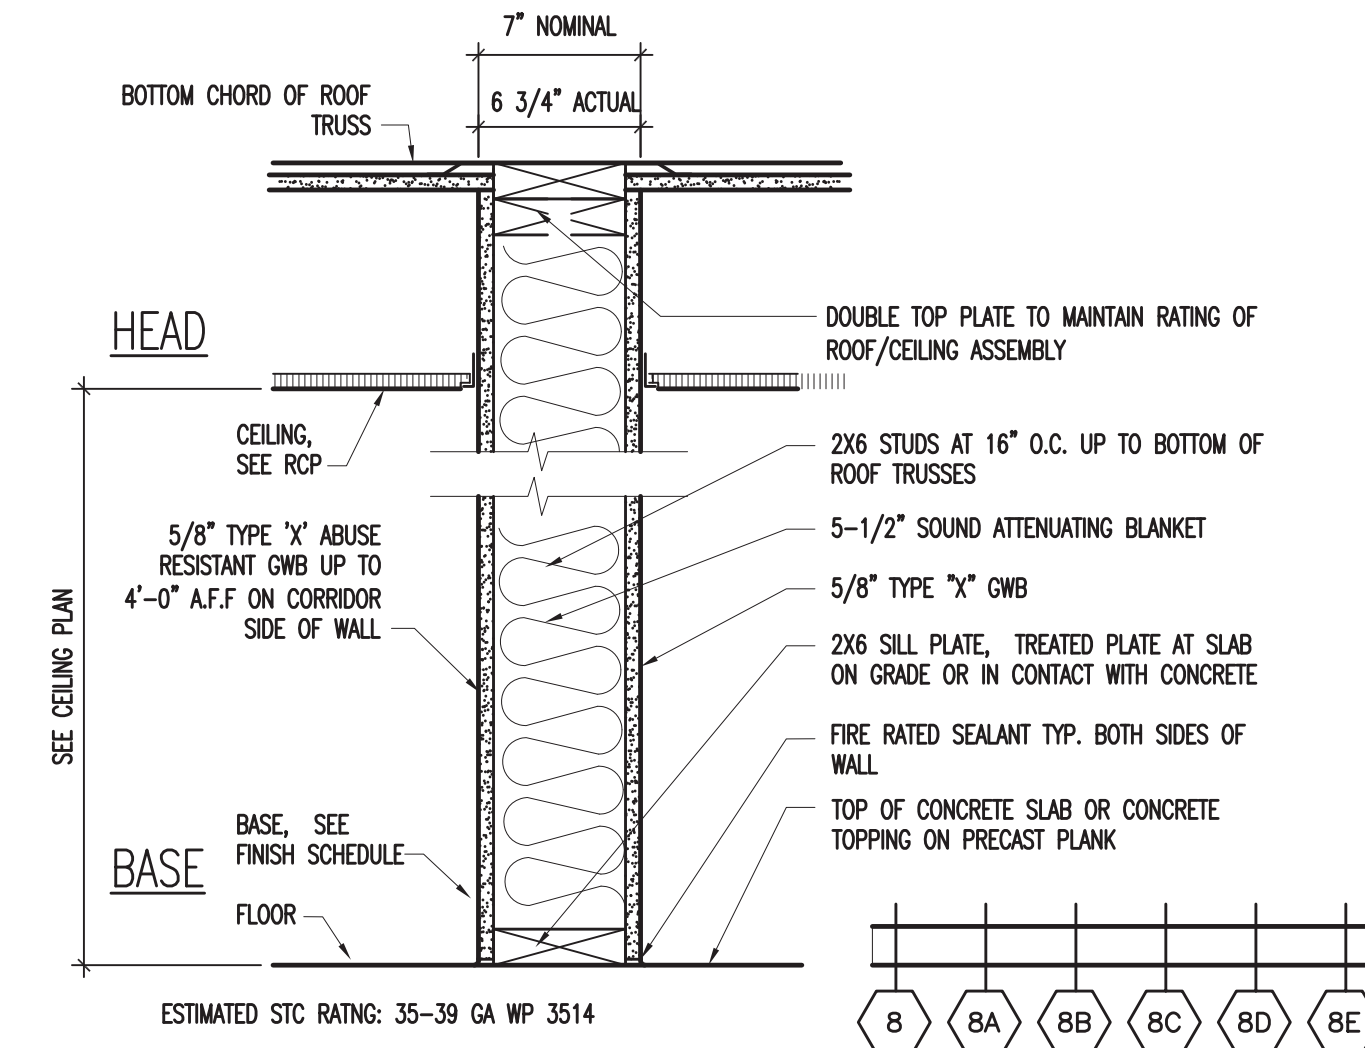


- 8A SAME AS WALL TYPE 8 WITHOUT SOUND ATTENUATING BLANKET
- 8B SAME AS WALL TYPE 8 WITH 5/8" TYPE "X" GWB BOTH SIDES OF STUDS IN LIEU OF ABUSE RESISTANT GWB
- 8C SAME AS WALL TYPE 8 WITHOUT SOUND ATTENUATING BLANKET AND PROVIDE 5/8" TYPE "X" ABUSE RESISTANT GWB UP TO 4'-0" A.F.F. ON BOTH SIDES OF WALL.
- 8D SAME AS WALL TYPE 8 WITHOUT SOUND ATTENUATING BLANKET AND PROVIDE 5/8" TYPE "X" GWB ON BOTH SIDES OF WALL.
- 8E SAME AS WALL TYPE 8 EXCEPT PROVIDE 5/8" TYPE "X" ABUSE RESISTANT GWB UP TO 4'-0" A.F.F. ON BOTH SIDES OF WALL.

8 WALL TYPE (8)
SCALE: 1 1/2"=1'-0"

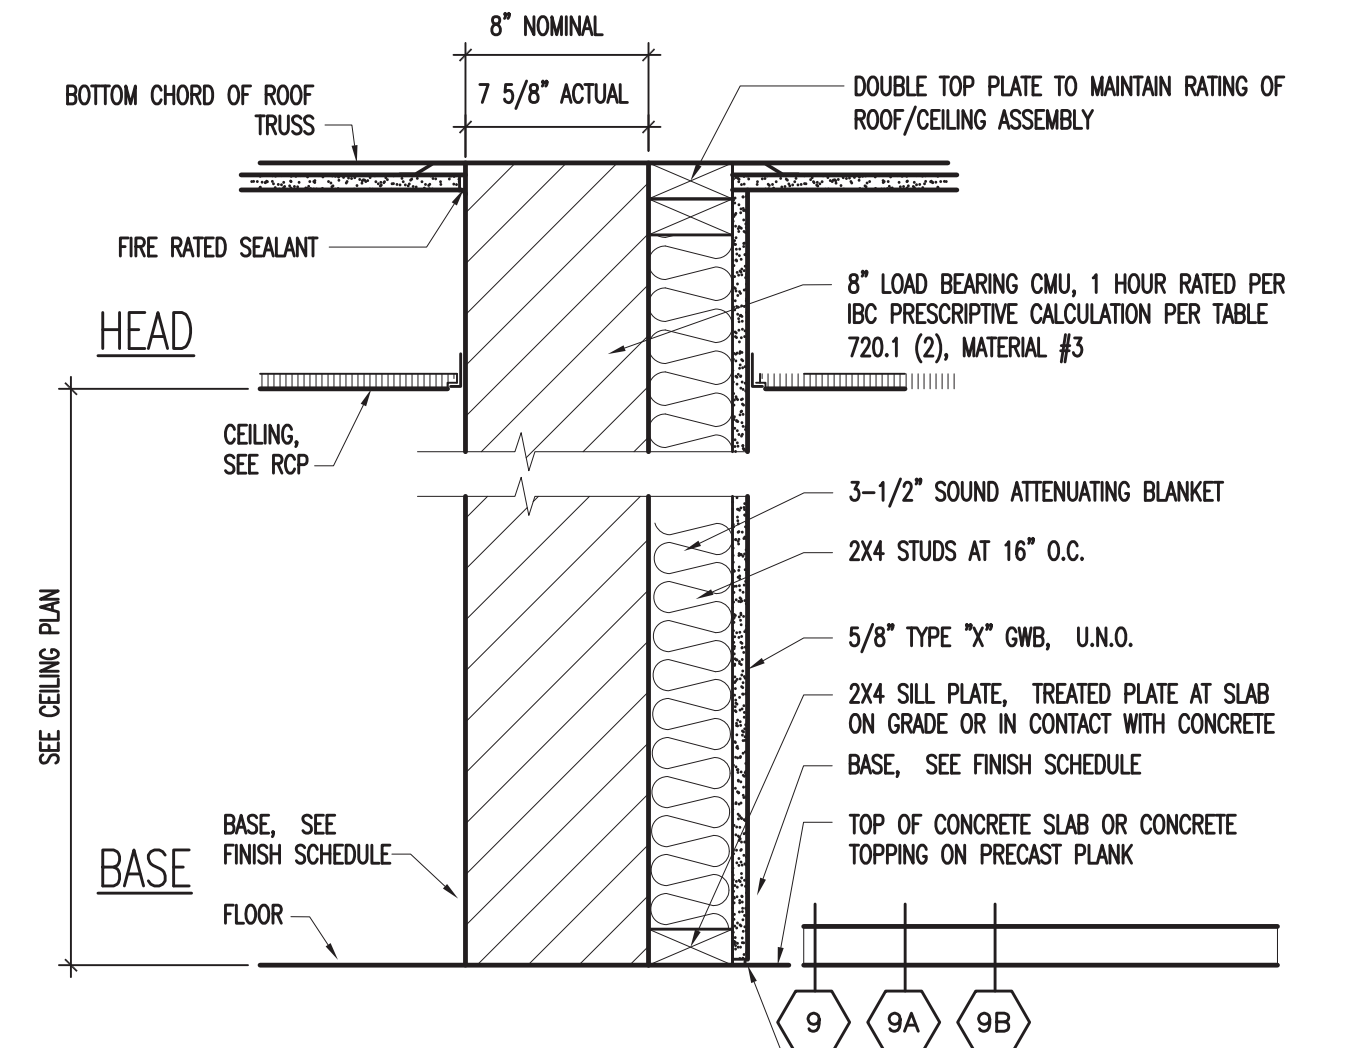


- 9A 1 HOUR RATED 8" CMU WALL WITHOUT 5/8" GWB AND STUDS
- 9B SAME AS WALL TYPE 9 EXCEPT PROVIDE 5/8" TYPE "X" ABUSE RESISTANT GWB UP TO 4'-0" A.F.F. ON CORRIDOR SIDE OF WALL.

9 WALL TYPE (9)
SCALE: 1 1/2"=1'-0"

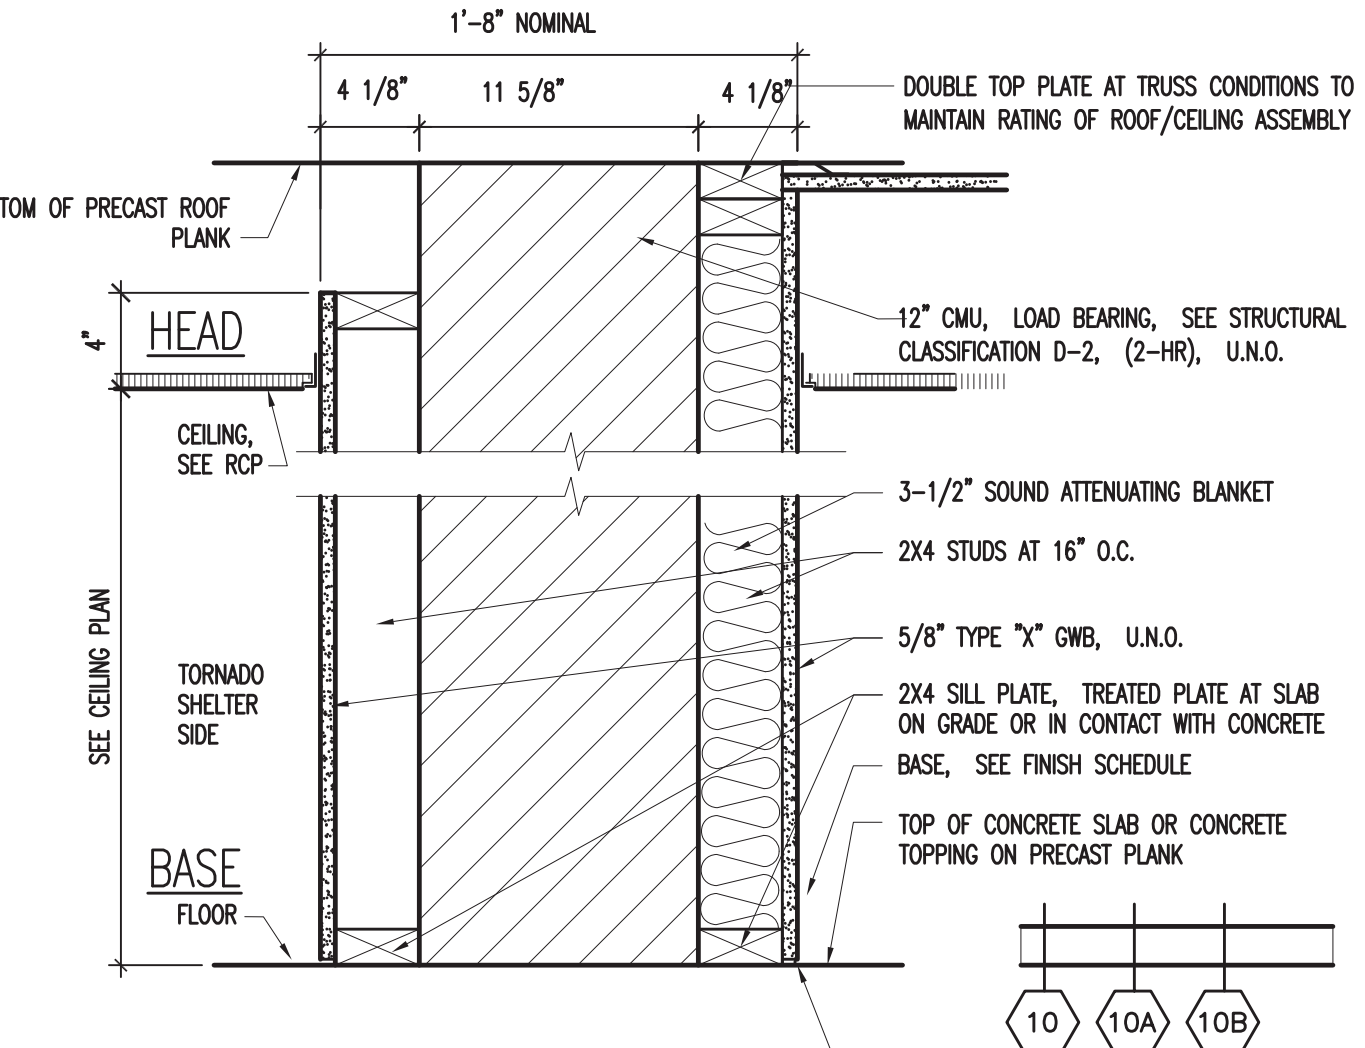


- 10A SAME AS WALL TYPE 10 EXCEPT PROVIDE 5/8" TYPE "X" ABUSE RESISTANT GWB UP TO 4'-0" A.F.F. ON CORRIDOR SIDE OF WALL AND 3/4" PLYWOOD BACKER PANELS BEHIND 5/8" GWB ON ROOM SIDE
- 10B SAME AS WALL TYPE 10 EXCEPT ELIMINATE WOOD STUDS AND GWB ON ONE SIDE

10 WALL TYPE (10)
SCALE: 1 1/2"=1'-0"

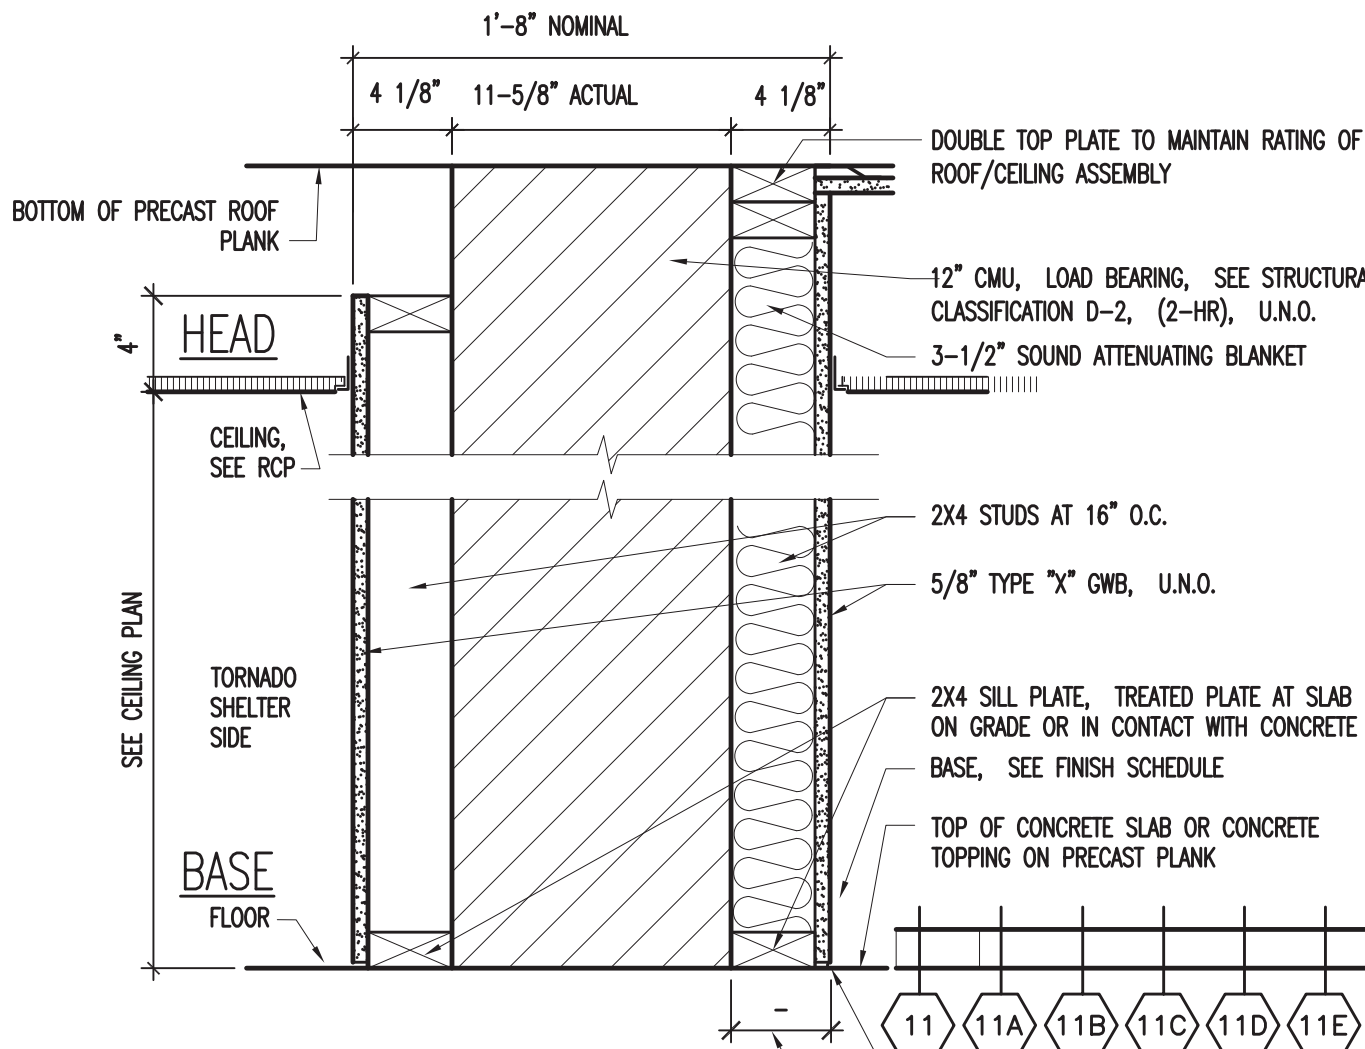


- 11A SAME AS WALL TYPE 11 EXCEPT PROVIDE 5/8" TYPE "X" ABUSE RESISTANT GWB UP TO 4'-0" A.F.F. ON CORRIDOR SIDE OF WALL.
- 11B SAME AS WALL TYPE 11 EXCEPT ELIMINATE 5/8" GWB AND 2X4 STUDS ON TORNADO SHELTER SIDE OF WALL.
- 11C SAME AS WALL TYPE 11 EXCEPT ELIMINATE 5/8" GWB AND PROVIDE 5/8" TYPE "X" ABUSE RESISTANT GWB UP TO 4'-0" A.F.F. ON CORRIDOR SIDE.
- 11D SAME AS WALL TYPE 11 EXCEPT PROVIDE 5/8" TYPE "X" ABUSE RESISTANT GWB UP TO 4'-0" A.F.F. ON 2X6 WOOD STUDS 16" O.C. ON CORRIDOR SIDE OF WALL.
- 11E SAME AS WALL TYPE 11 EXCEPT PROVIDE LOAD BEARING 2X6 WOOD STUDS 16" O.C. IN LIEU OF LOAD BEARING 2X4 WOOD STUDS.
- 11F SAME AS WALL TYPE 11 EXCEPT PROVIDE 3/4" PLYWOOD BACKER PANELS BEHIND 5/8" GWB ON ROOM SIDE.
- 11G SAME AS WALL TYPE 11 EXCEPT PROVIDE 5/8" TYPE "X" ABUSE RESISTANT GWB UP TO 4'-0" A.F.F. ON CORRIDOR SIDE AND 3/4" PLYWOOD BACKER PANELS BEHIND 5/8" GWB ON ROOM SIDE.

11 WALL TYPE (11)
SCALE: 1 1/2"=1'-0"

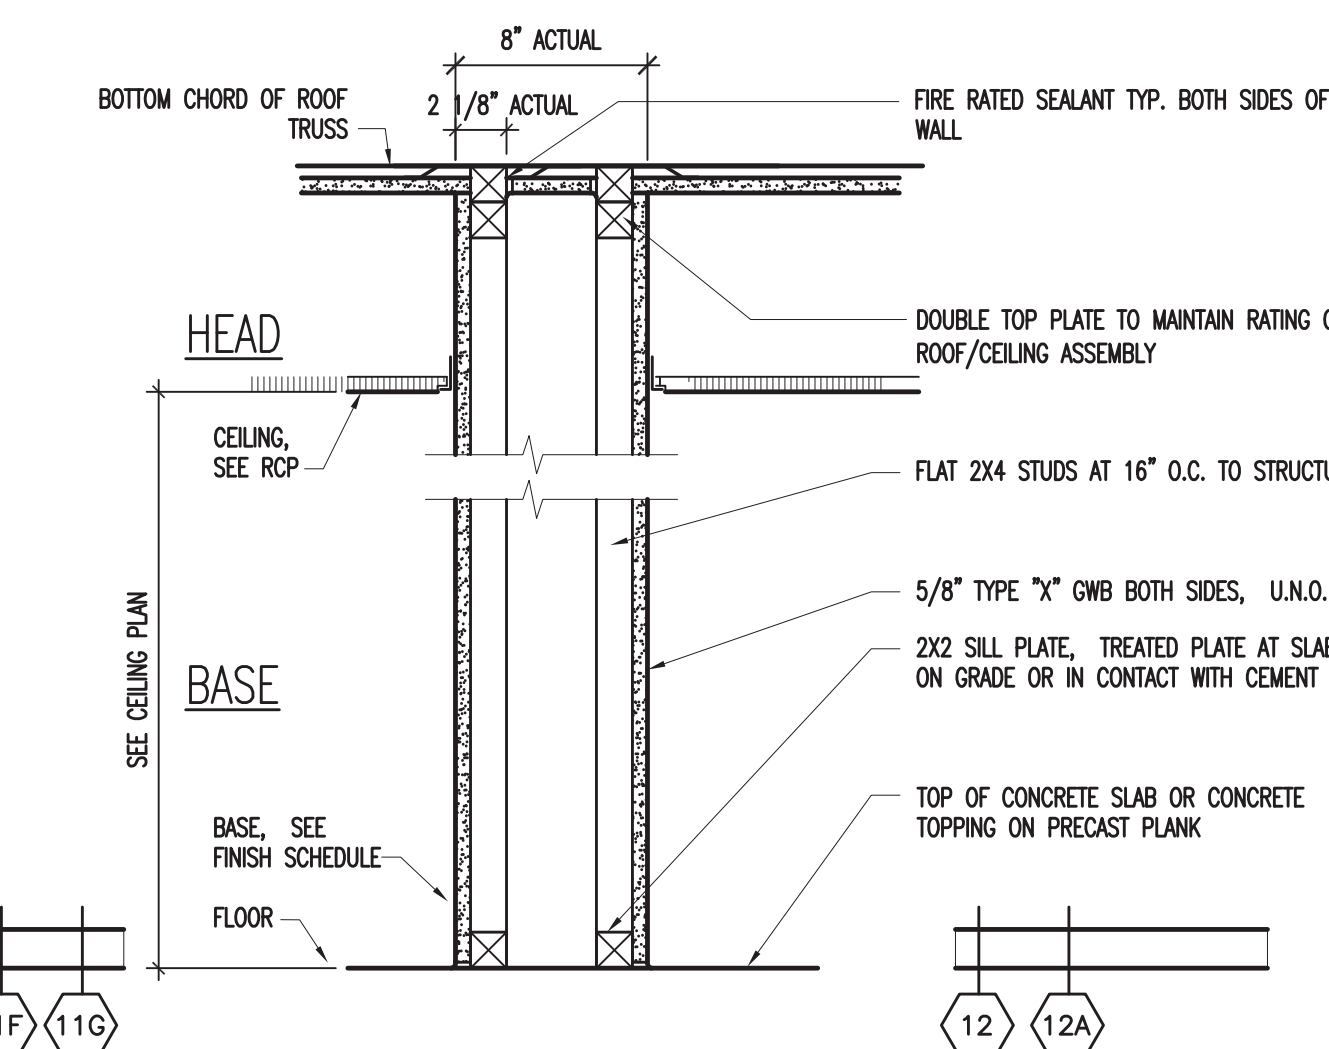


- 12A SAME AS WALL TYPE 12 EXCEPT PROVIDE 5/8" TYPE "X" ABUSE RESISTANT GWB UP TO 4'-0" A.F.F. ON CORRIDOR SIDE OF WALL.

12 WALL TYPE (12)
SCALE: 1 1/2"=1'-0"

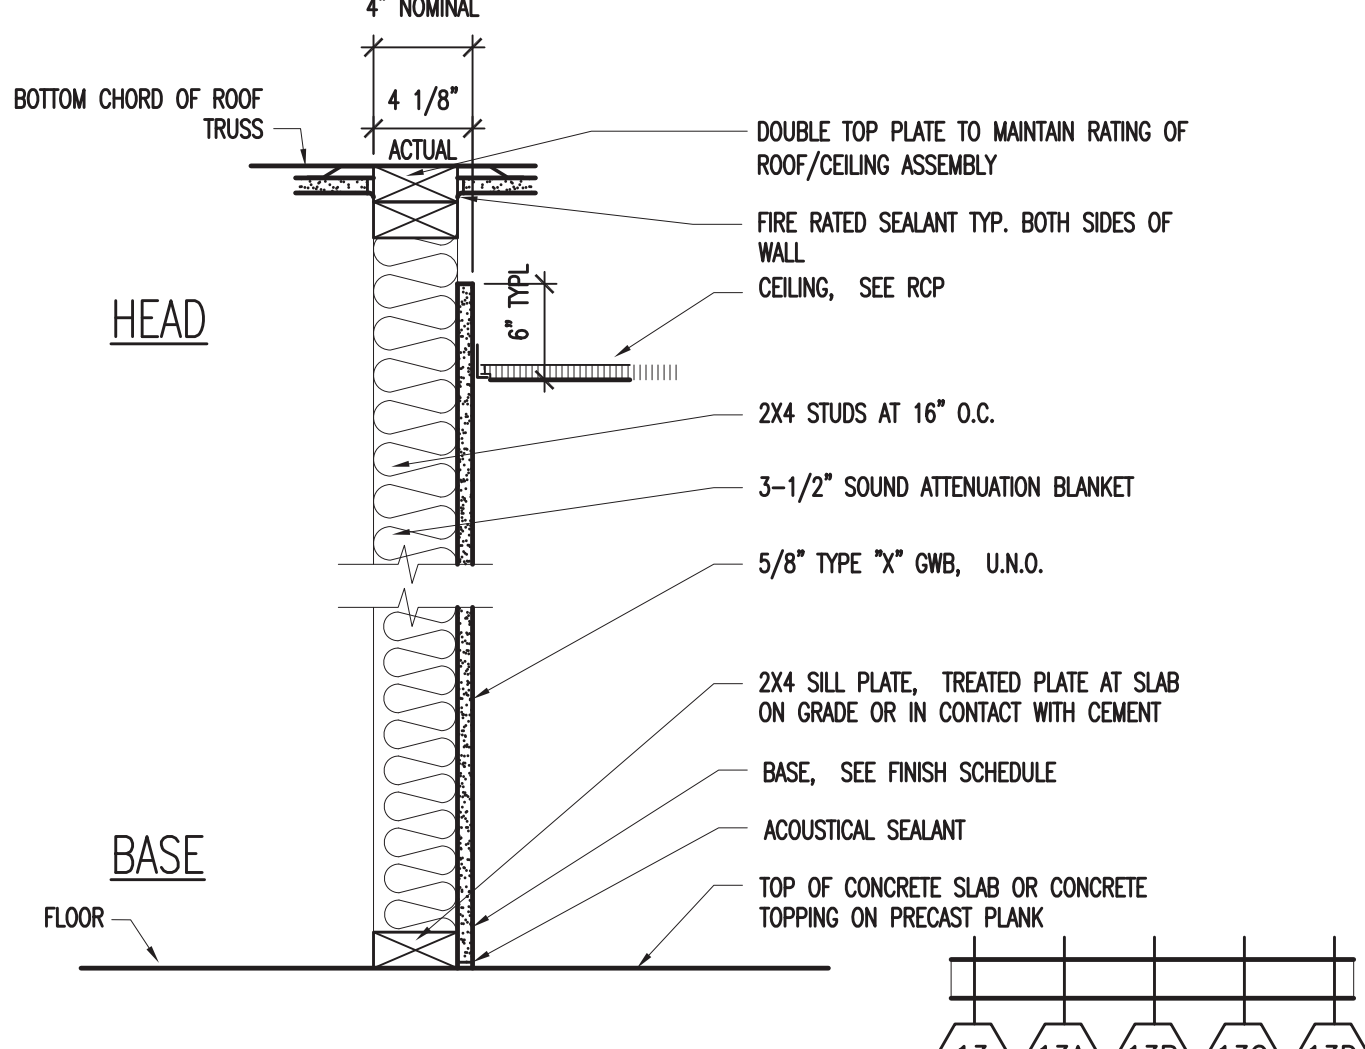


- 13A SAME AS WALL TYPE 13 WITHOUT SOUND ATTENUATING BLANKET
- 13B SAME AS WALL TYPE 13 EXCEPT PROVIDE 5/8" TYPE "X" ABUSE RESISTANT GWB UP TO 4'-0" A.F.F. ON CORRIDOR SIDE OF WALL.
- 13C SAME AS WALL TYPE 13 WITHOUT SOUND ATTENUATING BLANKET AND PROVIDE 5/8" TYPE "X" ABUSE RESISTANT GWB UP TO 4'-0" A.F.F. ON ONE SIDE OF WALL.
- 13D SAME AS WALL TYPE 13 WITHOUT SOUND ATTENUATING BLANKET AND PROVIDE 5/8" TYPE "X" ABUSE RESISTANT GWB UP TO 4'-0" A.F.F. ON CORRIDOR SIDE. SEE INTERIOR ELEVATIONS FOR HEIGHT OF WALL.

13 WALL TYPE (13)
SCALE: 1 1/2"=1'-0"

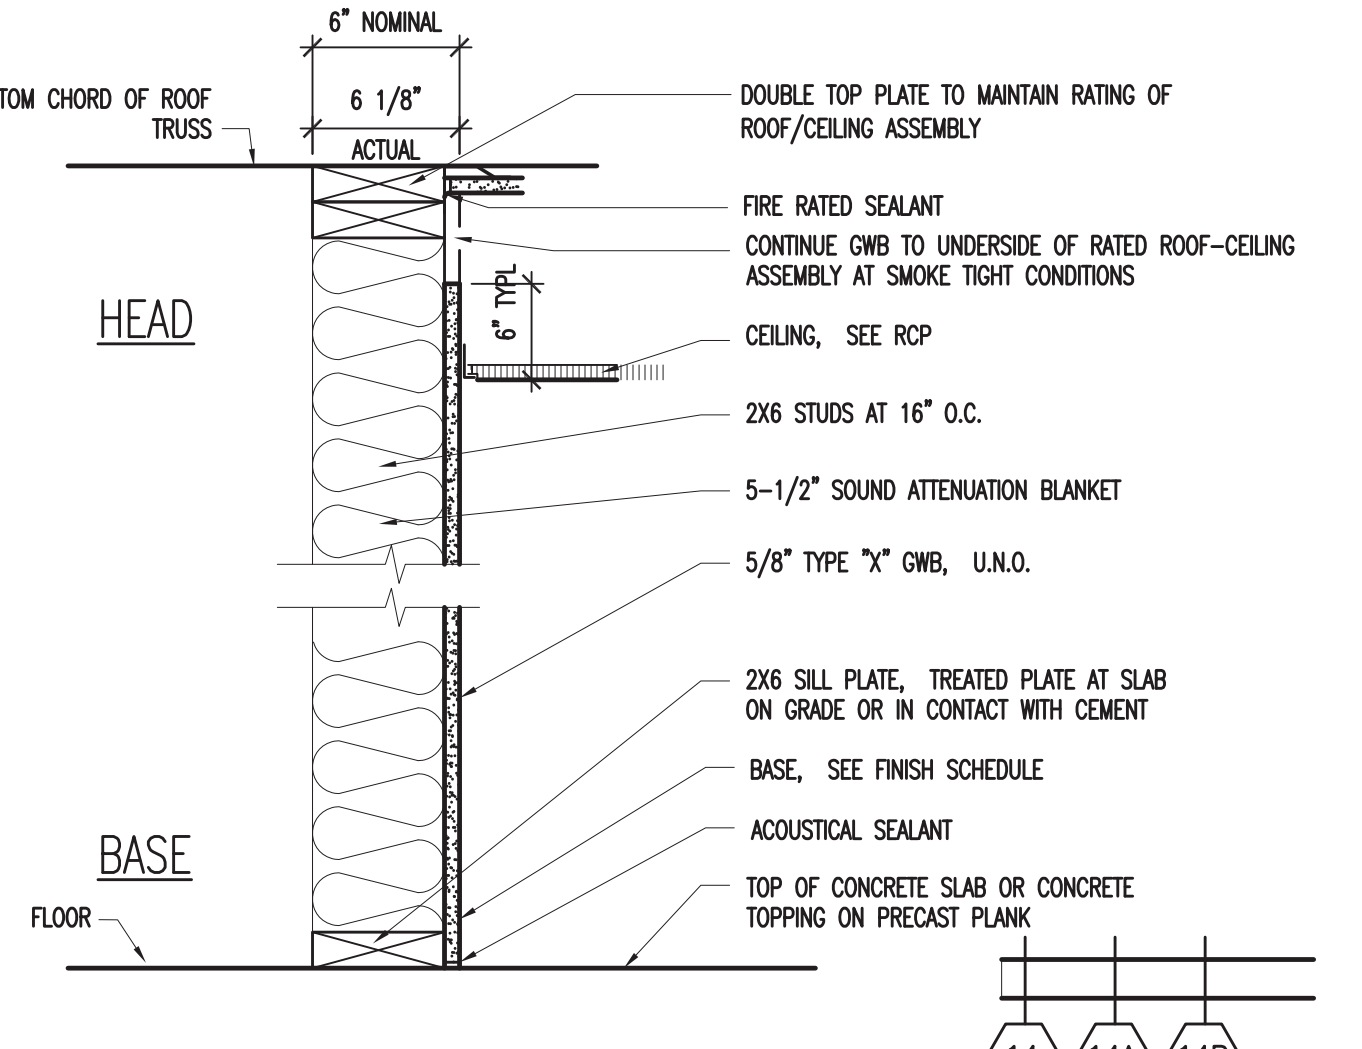

- 14A SAME AS WALL TYPE 14 WITHOUT SOUND ATTENUATING BLANKET
- 14B SAME AS WALL TYPE 14 WITHOUT SOUND ATTENUATING BLANKET AND PROVIDE 5/8" TYPE "X" ABUSE RESISTANT GWB UP TO 4'-0" A.F.F. ON ONE SIDE OF WALL. SMOKE TIGHT

14 WALL TYPE (14)
SCALE: 1 1/2"=1'-0"

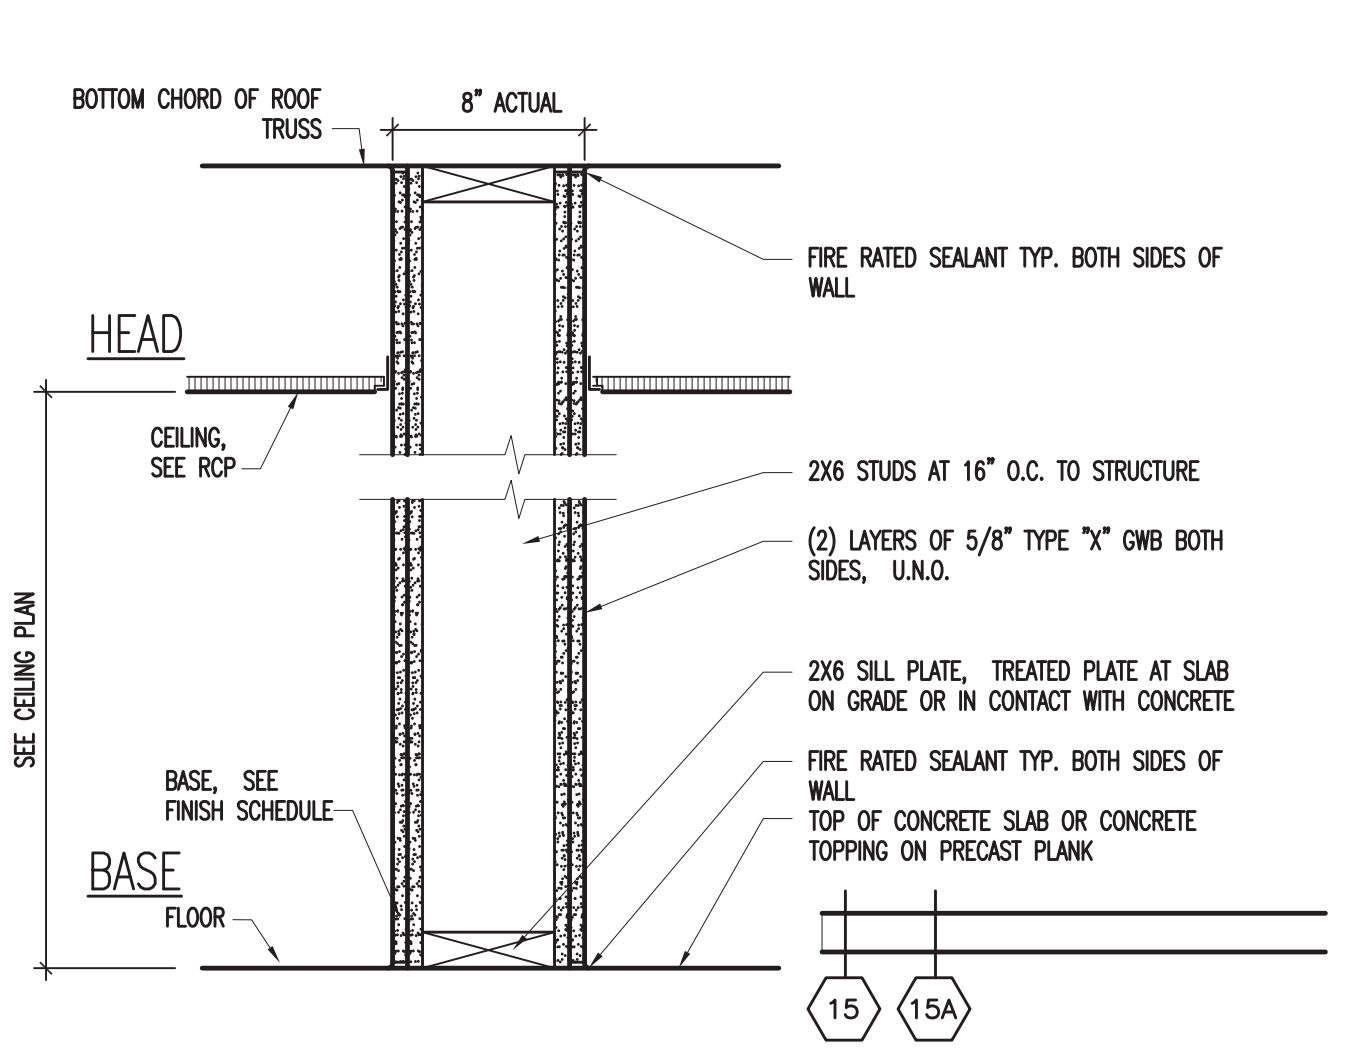

- 15A SAME AS WALL TYPE 15 EXCEPT OUTER LAYER OF GWB TO BE 5/8" TYPE "X" ABUSE RESISTANT GWB UP TO 4'-0" A.F.F. ON CORRIDOR SIDE AND PROVIDE 5-1/2" SOUND ATTENUATING BLANKET


15 WALL TYPE (15)
SCALE: 1 1/2"=1'-0"

GENERAL NOTES

- WALL ASSEMBLIES SEPARATING DWELLING UNITS FROM EACH OTHER OR FROM PUBLIC OR SERVICE AREAS SHALL HAVE A SOUND TRANSMISSION CLASS (STC) OF NOT LESS THAN 50 (45 IF FIELD TESTED) FOR AIR BORNE NOISE WHEN TESTED IN ACCORDANCE WITH ASTM E 90. THIS REQUIREMENT SHALL NOT APPLY TO DWELLING UNIT ENTRANCE DOORS.
- PROVIDE JOINT TAPE AND COMPOUND PER UL DESIGN REQUIREMENTS.
- COORDINATE WITH STRUCTURAL FOR BEARING CONDITIONS.
- STOP ALL PENETRATIONS INTO AND THROUGH RATED ASSEMBLIES IN A MANNER LISTED AND TESTED FOR THE SPECIFIC APPLICATION.
- BLOCKING REQUIRED FOR STRUCTURAL BRACING IS NOT SHOWN ON THESE DRAWINGS. VERIFY ALL BLOCKING AND NAILING/FASTENING REQUIREMENTS WITH STRUCTURAL NOTES AND FRAMING PLANS. VERIFY LOCATIONS, THICKNESS AND FASTENING REQUIREMENTS FOR THE PLYWOOD SHEATHING FOR LATERAL BRACING, REFER TO STRUCTURAL.
-
- PROVIDE 5/8" HIGH-IMPACT GWB ALONG THE LOWEST 4 FT OF WALLS IN CORRIDORS, WHEEL-CHAIR STORAGE, CHANGING ROOM, CUSTODIAL CLOSET, LINEN STORAGE, SOILED-LINEN, TRASH ROOM OR AS NOTED OTHERWISE ON THE DRAWINGS AND SPECIFICATIONS.

Interior Wall Types

A603

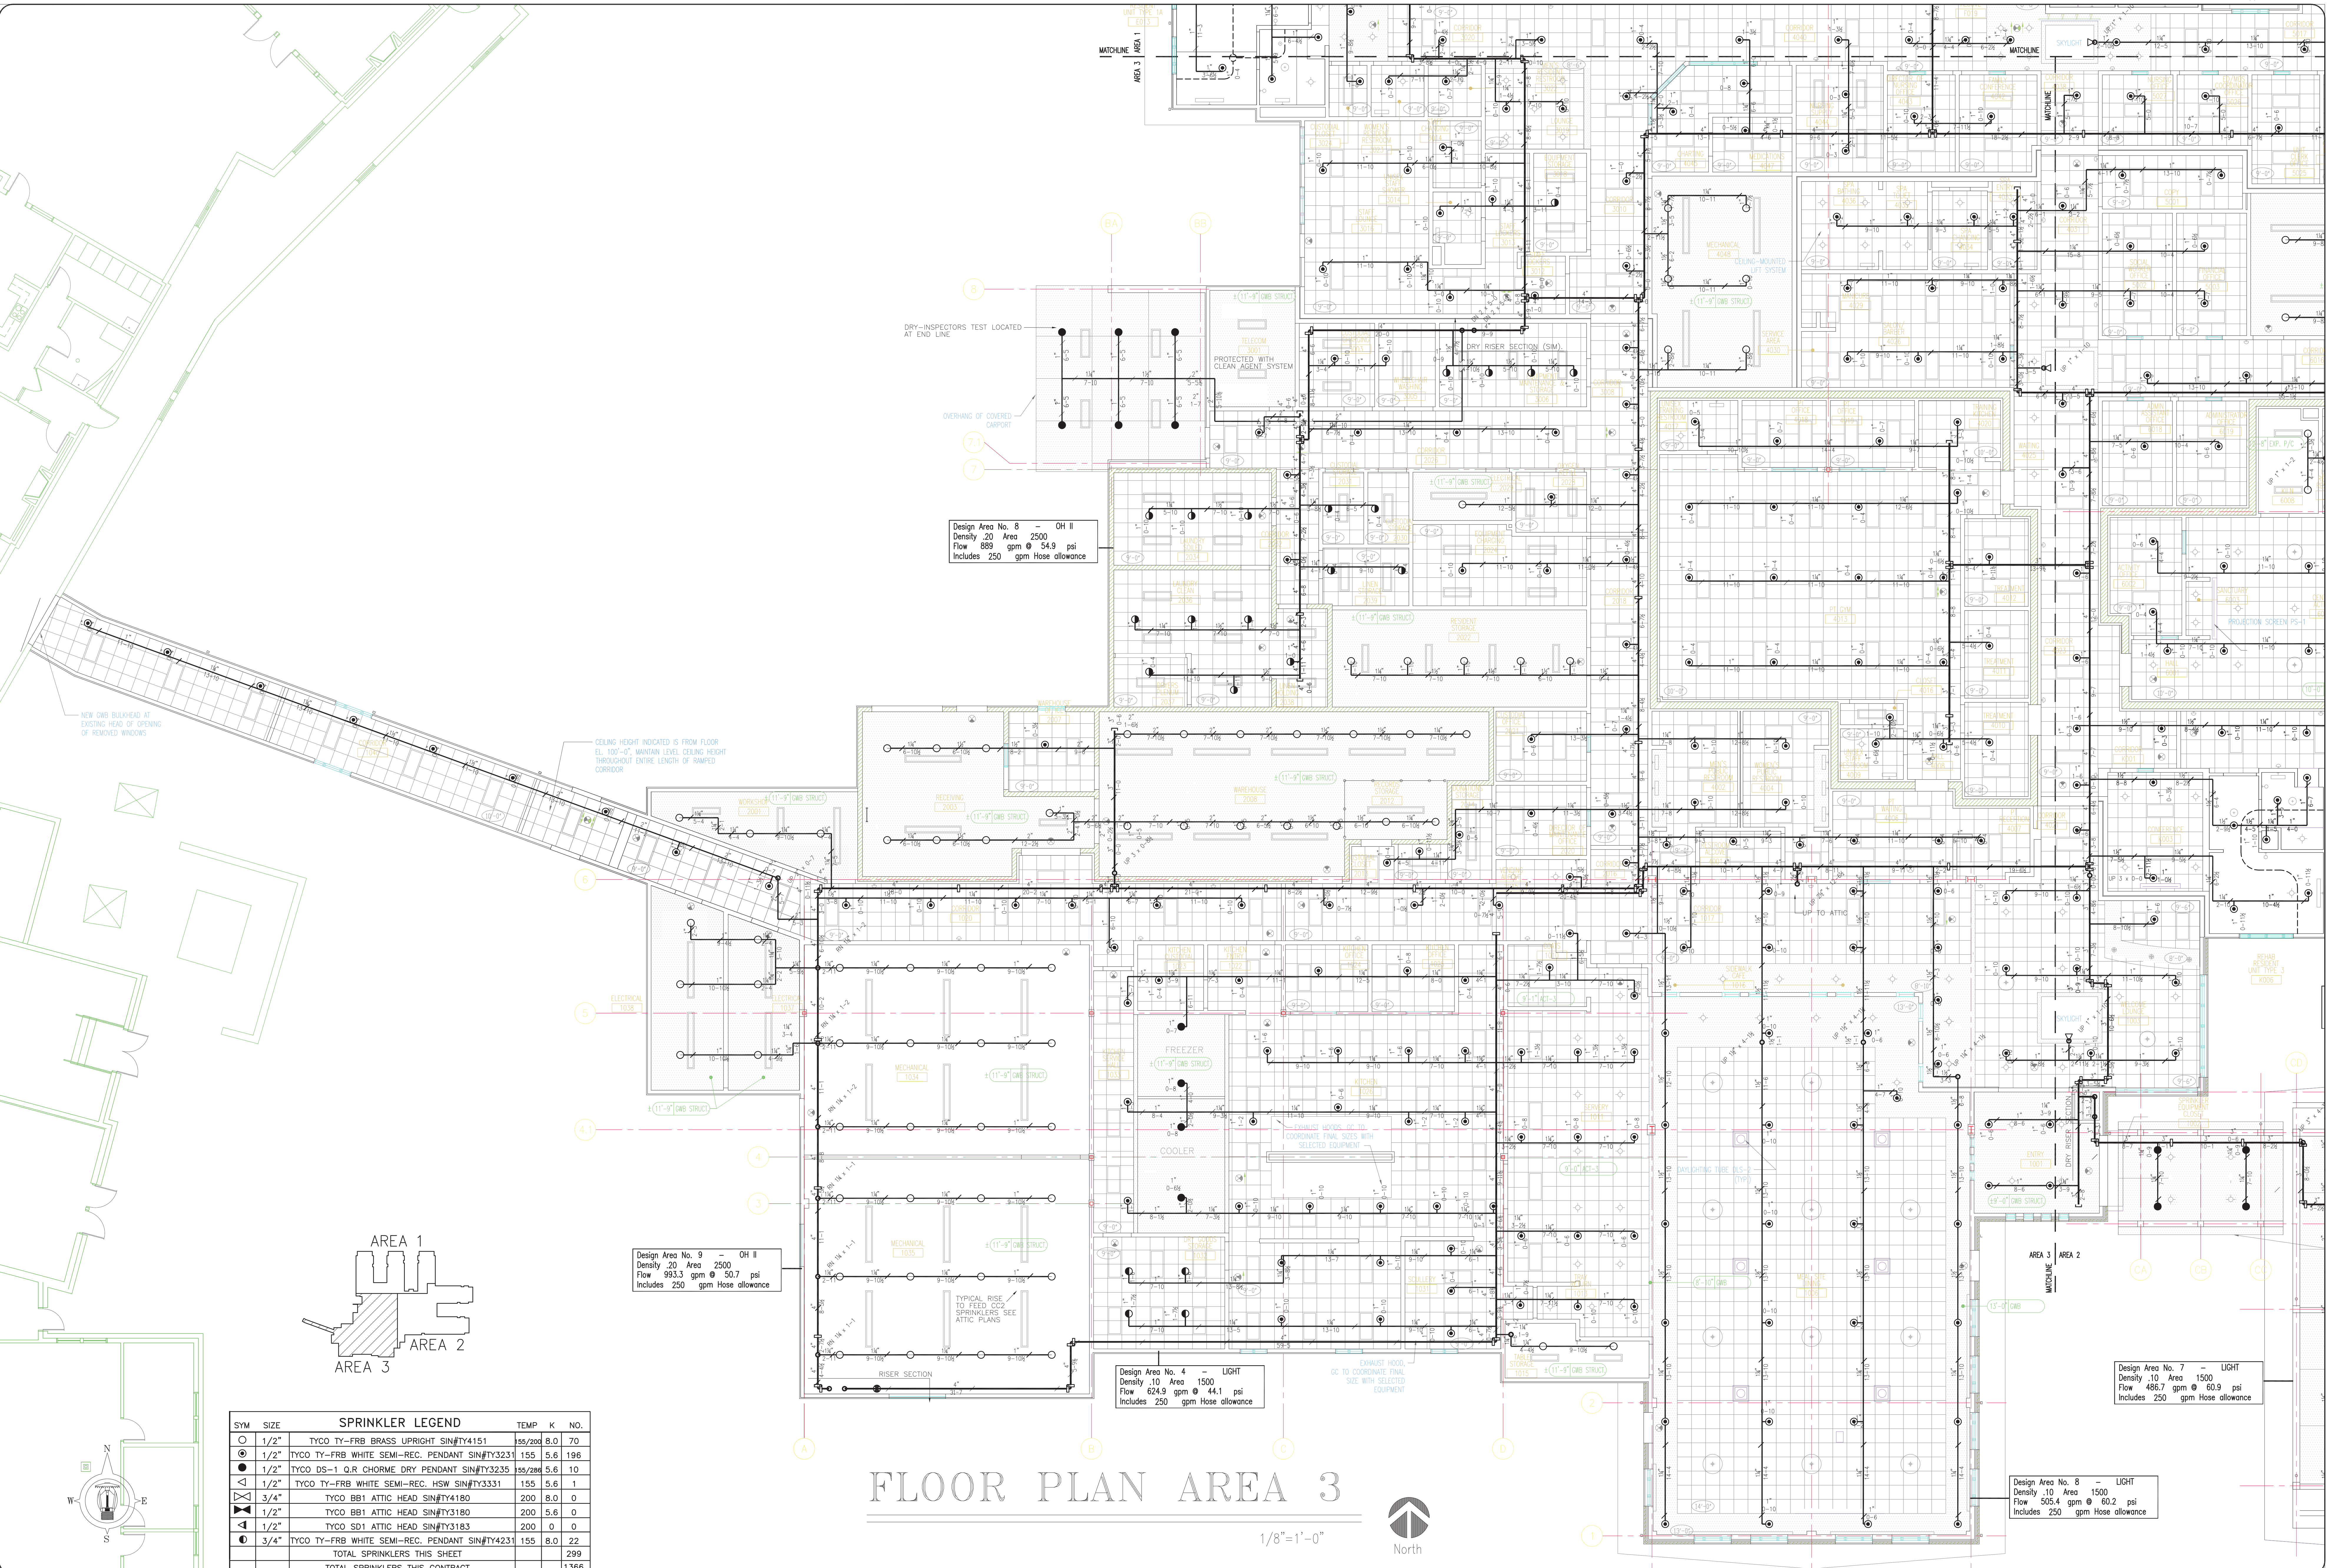

| SPRINKLER LEGEND | | | | |
|--------------------------------|------|--|---------|---------|
| SYM | SIZE | | TEMP | K NO. |
| ○ | 1/2" | TYCO TY-FRB BRASS UPRIGHT SIN#TY4151 | 155/200 | 8.0 70 |
| ● | 1/2" | TYCO TY-FRB WHITE SEMI-REC. PENDANT SIN#TY3231 | 155 | 5.6 196 |
| ⊙ | 1/2" | TYCO DS-1 Q.R CHORME DRY PENDANT SIN#TY3235 | 155/288 | 5.6 10 |
| △ | 1/2" | TYCO TY-FRB WHITE SEMI-REC. HSW SIN#TY3331 | 155 | 5.6 1 |
| ▽ | 3/4" | TYCO BB1 ATTIC HEAD SIN#TY4180 | 200 | 8.0 0 |
| ◀ | 1/2" | TYCO BB1 ATTIC HEAD SIN#TY3180 | 200 | 5.6 0 |
| ▶ | 1/2" | TYCO SD1 ATTIC HEAD SIN#TY3183 | 200 | 0 0 |
| ● | 3/4" | TYCO TY-FRB WHITE SEMI-REC. PENDANT SIN#TY4231 | 155 | 8.0 22 |
| TOTAL SPRINKLERS THIS SHEET | | | | 299 |
| TOTAL SPRINKLERS THIS CONTRACT | | | | 1366 |

FLOOR PLAN AREA 3

1/8" = 1'-0"



PRELIMINARY-DRAWING FOR CONSTRUCTION

RELEASED FOR CONST. ☒

BY: DATE:

| NO. | REVISIONS | BY: | DATE: |
|-----|------------------|-----|----------|
| 1. | APPROVAL DRAWING | RM | 9/20/11 |
| 2. | FM APPROVAL | RM | 4/26/12 |
| 3. | AS-BUILT | RM | 8/31/12 |
| 4. | XX | XX | XX/XX/XX |

1 SYSTEM DESIGNED PER NFPA-13 (2007)

2 ALL SYSTEM MATERIAL AND INSTALLATION PER NFPA-13 (2007)

3 ALL HANGER COMPONENTS, LOCATION, & INSTALLATION PER NFPA-13 (2007)

4 PIPE SPECIFICATIONS: 1" - 2" SCHEDULE 40
2 1/2" - 4" SCHEDULE 10
6" - 8" ALLIED SCHEDULE 10

5 FITTING SPECIFICATIONS: SCREWED - DUCTILE IRON; GROOVED - DUCTILE IRON

6 SYMBOL (○) INDICATES CENTER LINE OF PIPE TO DECK IN INCHES

7 SYMBOL (○-○) INDICATES CENTER LINE OF PIPE TO FINISHED FLOOR

8 SYMBOL (○) INDICATES HYDRANT CALCULATION POINT

9 SPRINKLERS TO BE CENTERED IN CEILING TILE

10 SPRINKLERS NOT NECESSARILY ALIGNED WITH CEILING FIXTURES

11 CEILING ARE ALL 0' - 0" UNLESS NOTED WITH SYMBOL (○-○)

12 XXX

13 XXX

PLEASE SEE SPRINKLER TYPE, TEMPERATURE, AND FINISH ON SCHEDULE ABOVE

SHEET TITLE: FIRE PROTECTION PLAN AREA 1

DATE: 9/20/2011

DRAWN BY: RM

CHECKED BY: RM

SCALE: 1/8" = 1'-0"

REEKE-MAROLD COMPANY

Mechanical Contractors & Engineers

1337 S. Broadway - Green Bay, WI 54306

Phone: (920) 435-5377 Fax: (920) 435-5379

WISCONSIN SPRINKLER CONTRACTOR #121668

PROPERTY OF REEKE-MAROLD CO. INC., GREEN BAY, WISCONSIN

THIS PRINT IS NOT TO BE COPIED, REPRODUCED, OR USED WITHOUT WRITTEN PERMISSION FROM REEKE-MAROLD CO. INC.

PROJECT NAME: ONEIDA RESIDENT-CENTERED CARE COMMUNITY

2907 S. OVERLAND ROAD

GREEN BAY, WI 54155

DRAWING NO. FP-4 of 7

CONTRACT NO. 2011

REVISIONS

| REVISIONS: | |
|------------|---------------------------------------|
| 1 | EA REVIEW/COORDINATION COMMENTS 9/12/ |
| 2 | RECORD DRAWINGS 06/07/201 |
| | |
| | |
|-------------|------------|
| DATE: | 08/17/2011 |
| JOB#: | 200210 |
| DRAWN BY: | S.TOLL |
| CHECKED BY: | T.CAYER |
| SCALE: | AS SHOWN |

P103



FIRST FLOOR DWV PLAN - AREA 3
SCALE: 1/8"=1'-0"




ONEIDA RESIDENT CENTERED CARE COMMUNITY
2907 SOUTH OVERLAND RD.
ONEIDA, WI 54155-8959

| REVISIONS: | |
|-----------------|----------------------------|
| EA REVIEW | COORDINATION COMMENTS 9/12 |
| RECORD DRAWINGS | 06/07/201 |
| | |
| | |

FIRST FLOOR
DOMESTIC WATER
AREA 3

| | |
|-------------|------------|
| DATE: | 08/17/2011 |
| JOB#: | 200210 |
| DRAWN BY: | S.TOLL |
| CHECKED BY: | T.CAYER |
| SCALE: | AS SHOWN |

P203

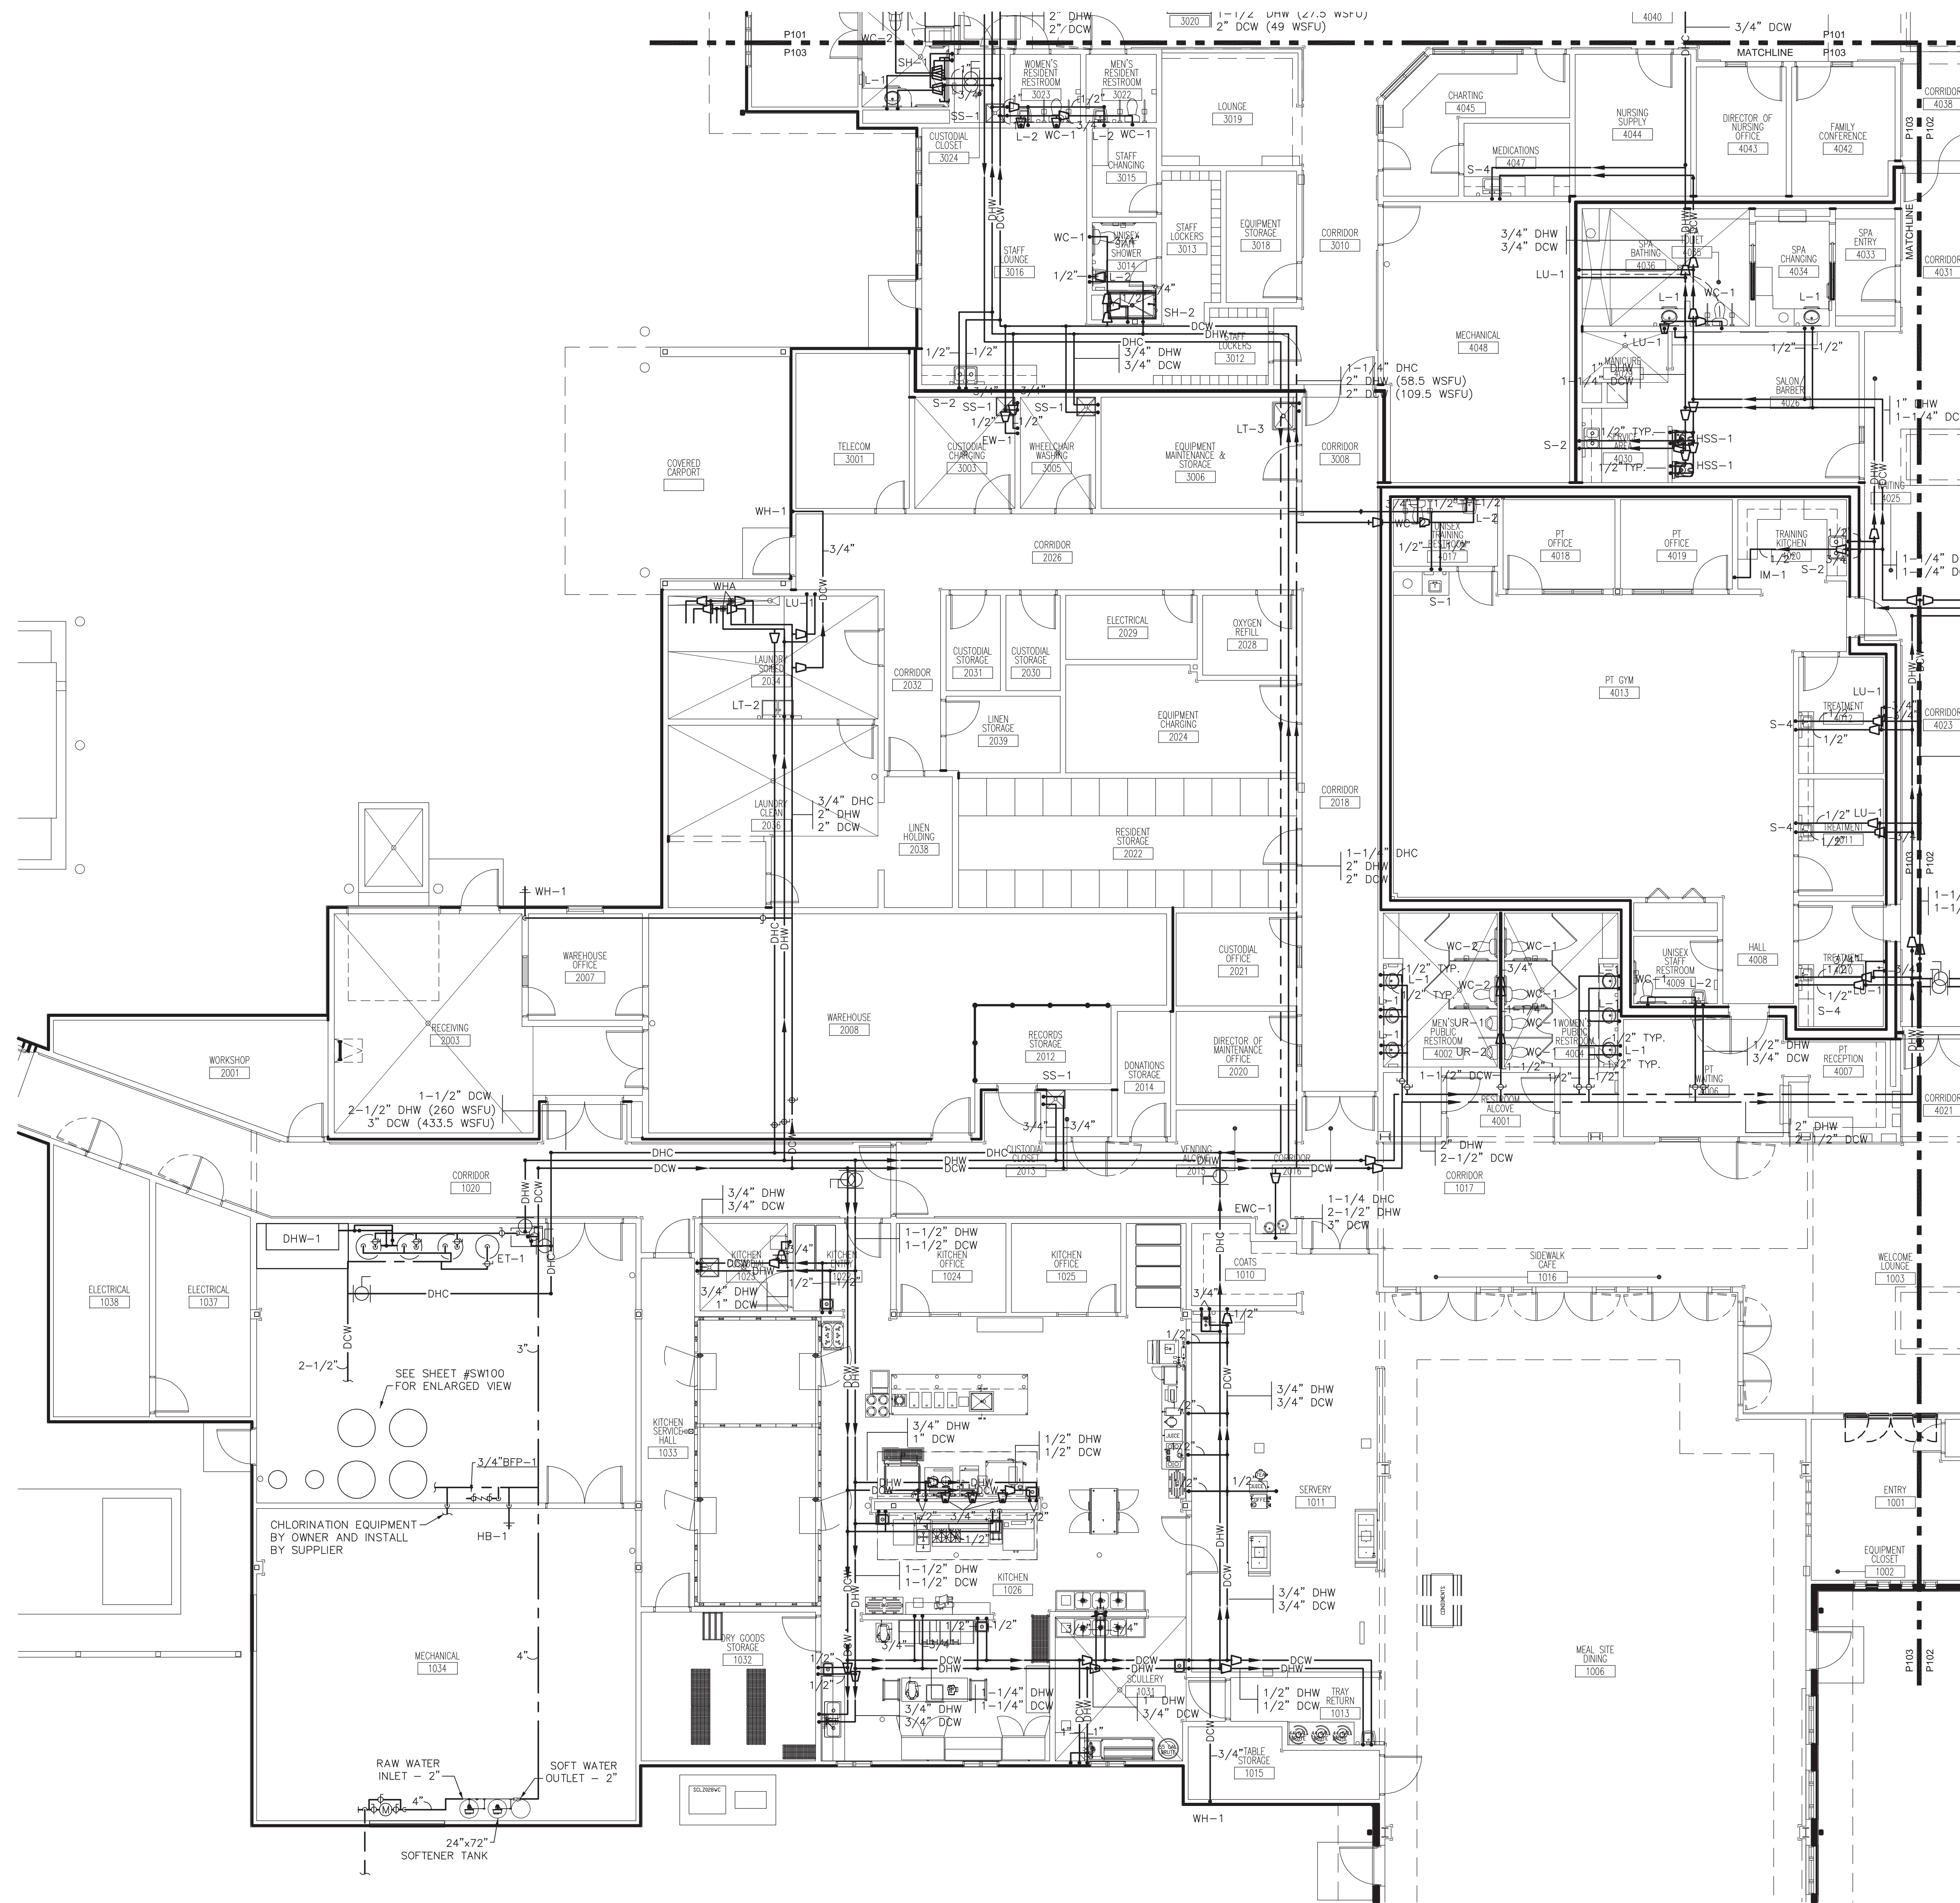

FIRST FLOOR DOMESTIC WATER PLAN - AREA 3
SCALE: 1/8"=1'-0"

| | |
|------------------|-----------------|
| REVISION HISTORY | |
| 7/1/13 | RECORD DRAWINGS |

| | |
|-------------|-------------|
| DATE: | 09/27/2011 |
| JOB#: | 300344 |
| DRAWN BY: | N. PETERSON |
| CHECKED BY: | W. ZIMPEL |
| SCALE: | AS SHOWN |

H101-3



FIRST FLOOR HVAC DUCTWORK PLAN - AREA 3
SCALE: 1/8"=1'-0"






P.O. Box 11767 / 2545 Larsen Rd.
Green Bay, WI. 54307-1767
920-498-0400
WWW.TWEETGAROT.COM

ONEIDA RESIDENT -
CENTERED CARE COMMUNITY
2907 SOUTH OVERLAND ROAD
ONEIDA, WI 54155-8959

| REVISION HISTORY | |
|---|-----------------|
| 7/1/13 | RECORD DRAWINGS |
| | |
| | |
| | |
| TITLE | |
| FIRST FLOOR HVAC PIPING PLAN - AREA 3 | |
| | |
| DATE: | 09/27/2011 |
| JOB#: | 300344 |
| DRAWN BY: | N. PETERSON |
| CHECKED BY: | W. ZIMPEL |
| SCALE: | AS SHOWN |
| CONSTRUCTION DOCUMENTS | |

H201-3

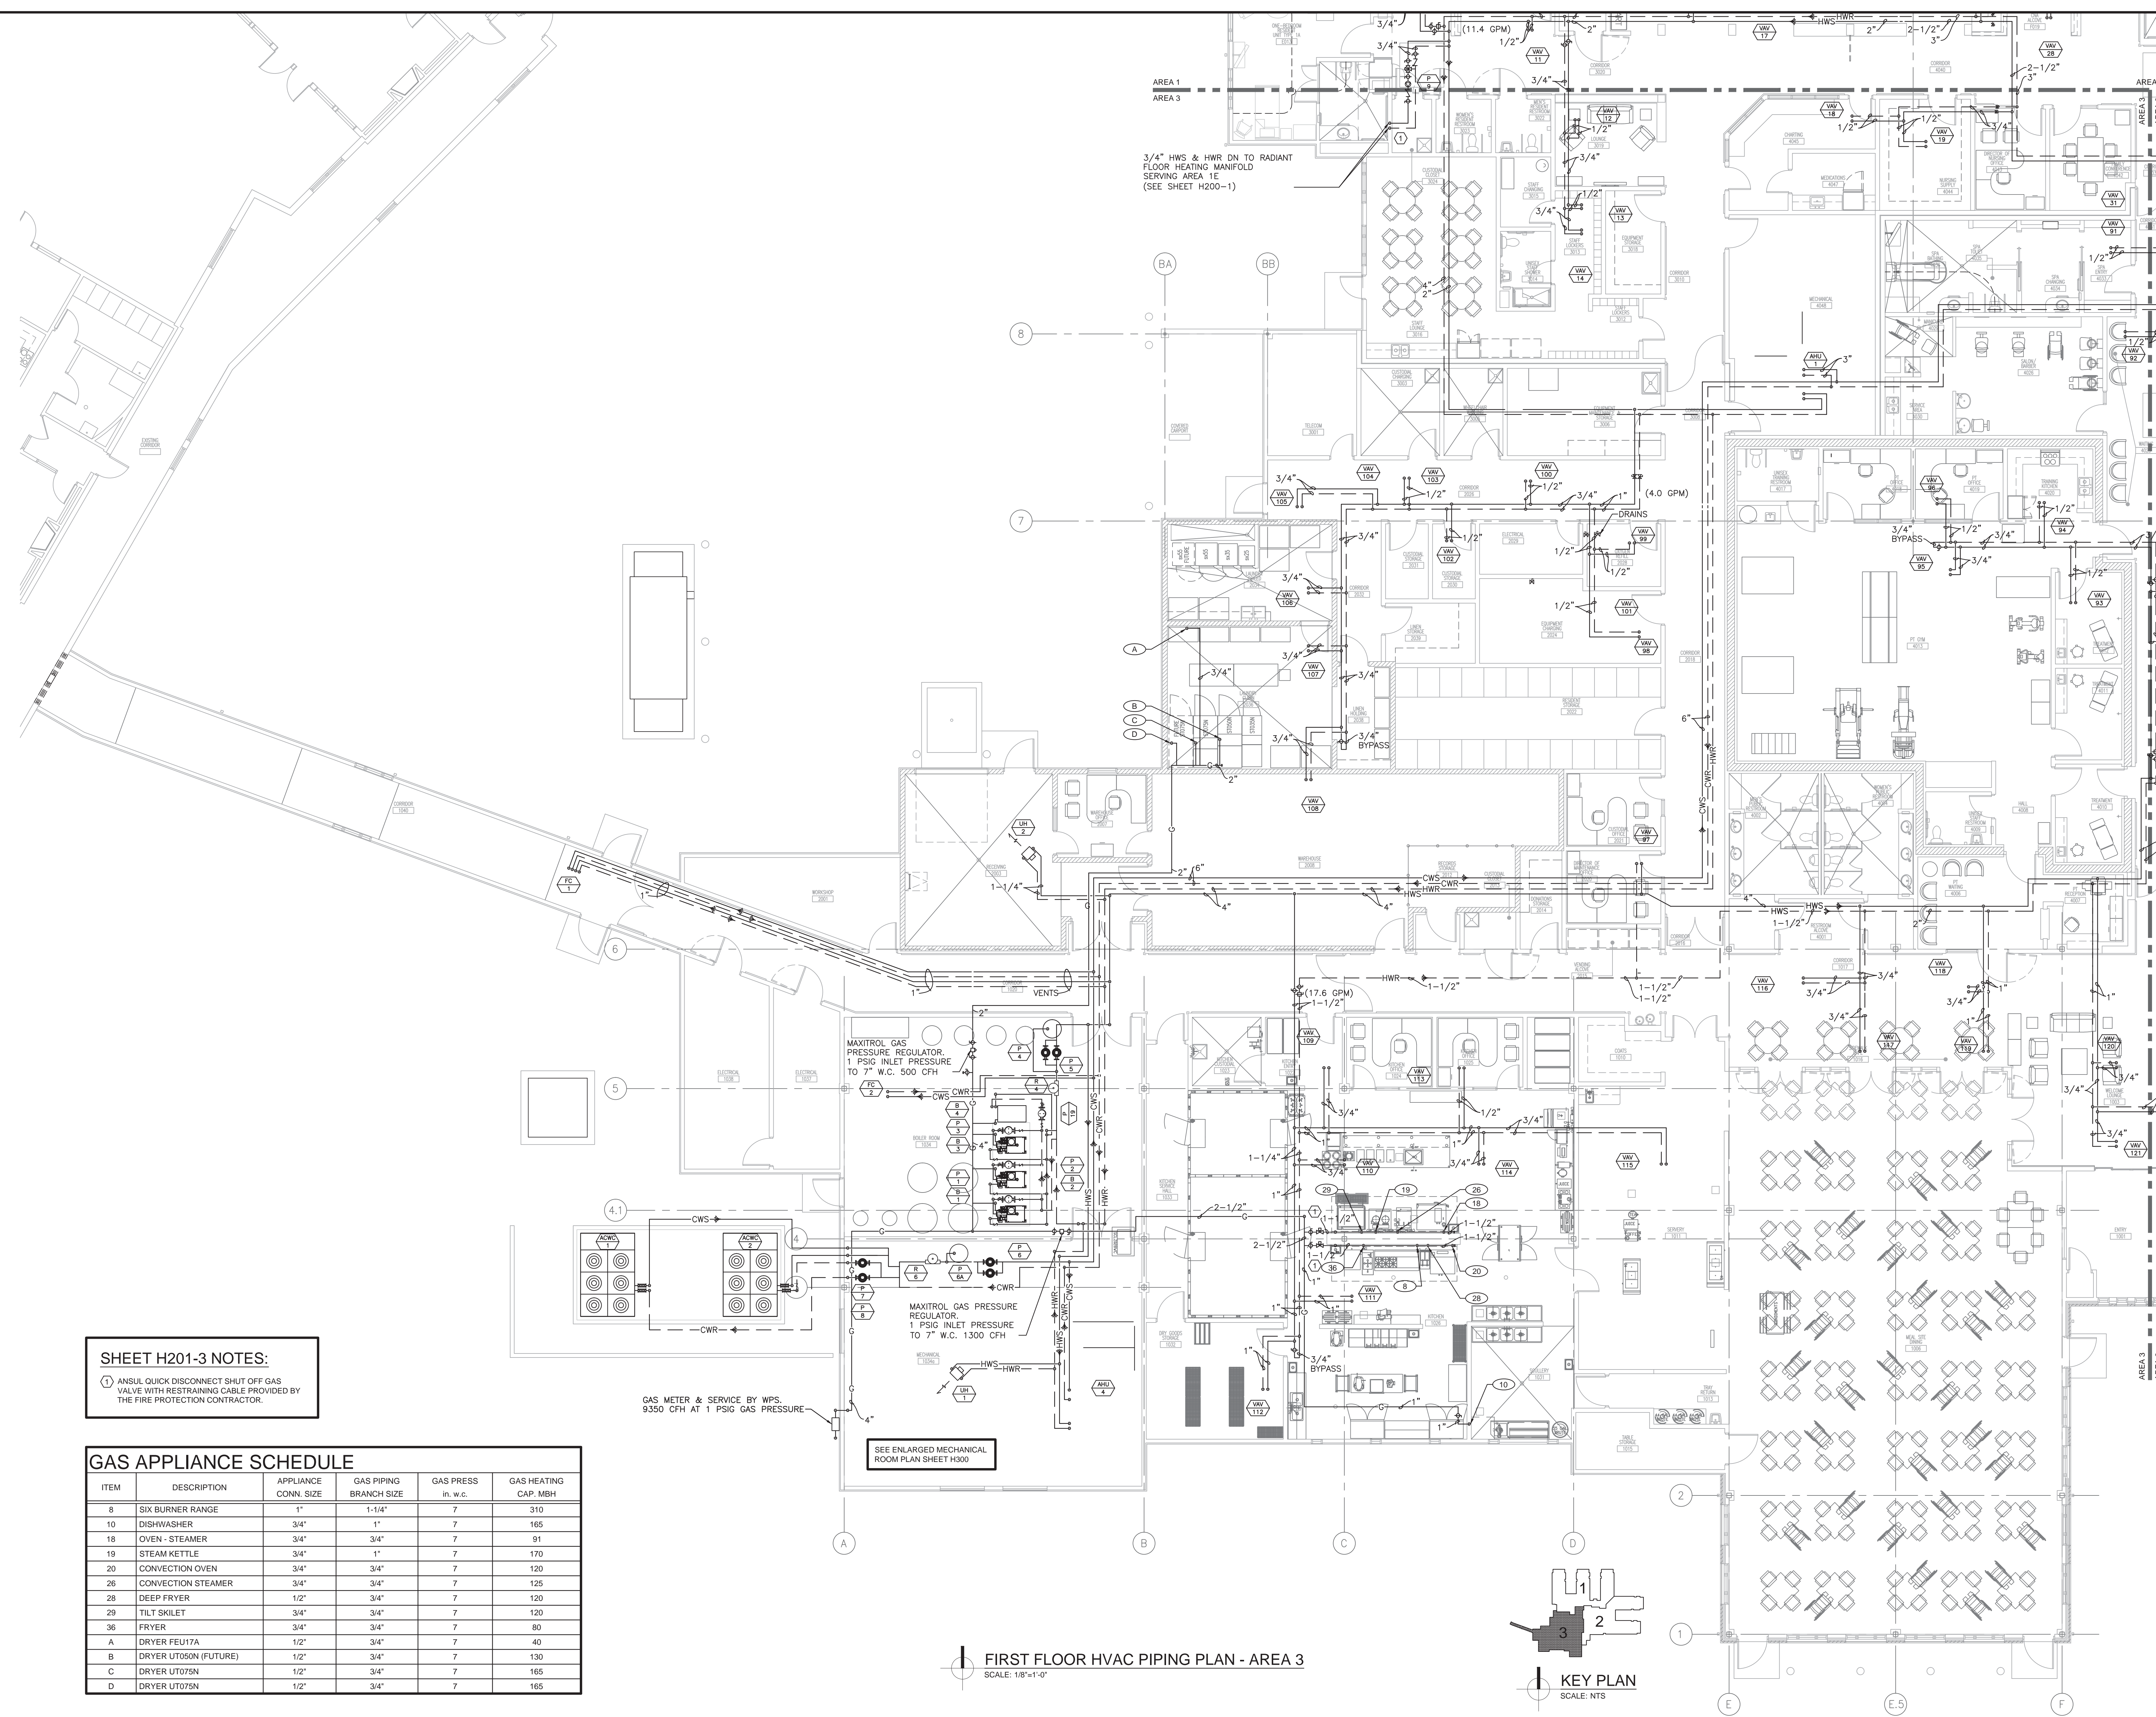

FIRST FLOOR HVAC PIPING PLAN - AREA 3

 KEY PLAN
SCALE: NTS

SHEET H201-3 NOTES:

1 ANSUL QUICK DISCONNECT SHUT OFF GAS VALVE WITH RESTRAINING CABLE PROVIDED BY THE FIRE PROTECTION CONTRACTOR.

| GAS APPLIANCE SCHEDULE | | | | | |
|------------------------|-----------------------|-------------------------|---------------------------|-----------------------|-------------------------|
| ITEM | DESCRIPTION | APPLIANCE CONN. SIZE | GAS PIPING BRANCH SIZE | GAS PRESS in. w.c. | GAS HEATING CAP. MBH |
| 8 | SIX BURNER RANGE | 1" | 1-1/4" | 7 | 310 |
| 10 | DISHWASHER | 3/4" | 1" | 7 | 165 |
| 18 | OVEN - STEAMER | 3/4" | 3/4" | 7 | 91 |
| 19 | STEAM KETTLE | 3/4" | 1" | 7 | 170 |
| 20 | CONVECTION OVEN | 3/4" | 3/4" | 7 | 120 |
| 26 | CONVECTION STEAMER | 3/4" | 3/4" | 7 | 125 |
| 28 | DEEP FRYER | 1/2" | 3/4" | 7 | 120 |
| 29 | TILT SKILLET | 3/4" | 3/4" | 7 | 120 |
| 36 | FRYER | 3/4" | 3/4" | 7 | 80 |
| A | DRYER FEU17A | 1/2" | 3/4" | 7 | 40 |
| B | DRYER UT050N (FUTURE) | 1/2" | 3/4" | 7 | 130 |
| C | DRYER UT075N | 1/2" | 3/4" | 7 | 165 |
| D | DRYER UT075N | 1/2" | 3/4" | 7 | 165 |



P.O. Box 11767 / 2545 Larsen Rd.
Green Bay, WI. 54307-1767
920-498-0400
WWW.TWEETGAROT.COM

ONEIDA RESIDENT -
CENTERED CARE COMMUNITY
2907 SOUTH OVERLAND ROAD
ONEIDA, WI 54155-8959

| REVISION HISTORY | |
|------------------|-----------------|
| | RECORD DRAWINGS |
| | |
| | |
| | |
| | |

TITLE
HVAC SCHEDULES

| | |
|------------------------|-------------|
| DATE: | 09/27/2011 |
| JOB#: | 300344 |
| DRAWN BY: | N. PETERSON |
| CHECKED BY: | W. ZIMPEL |
| SCALE: | AS SHOWN |
| CONSTRUCTION DOCUMENTS | |

H501

| KITCHEN HOOD EXHAUST FAN SCHEDULE | | | | | | | | | | | |
|---|--------------------|--------------|---------------|------------------|--------------------|------|---------------|------|-----|---------|---------|
| UNIT NUMBER | SERVES | MANUFACTURER | MODEL | TYPE | DISCHARGE POSITION | CFM | S. P. (IN WC) | RPM | HP | VOLTAGE | REMARKS |
| KEF-1 | KITCHEN HOOD NO. 1 | GREENHECK | CUBE-240HP-30 | CENTRIFUGAL ROOF | UP BLAST | 5100 | 1.75 | 1126 | 3 | 460/3 | 1, 2 |
| KEF-2 | KITCHEN HOOD NO. 2 | GREENHECK | CUBE-200HP-20 | CENTRIFUGAL ROOF | UP BLAST | 3650 | 1.75 | 1362 | 2 | 460/3 | 1, 2 |
| KEF-3 | KITCHEN HOOD NO. 3 | GREENHECK | CUBE-101HP-3 | CENTRIFUGAL ROOF | UP BLAST | 450 | 0.5 | 1555 | 1/3 | 120/1 | 1, 3 |
| NOTES: 1. MFR TO PROVIDE VIBRATION ISOLATORS, PREMIUM EFFICIENCY MOTOR, 16" HIGH INSULATED ROOF CURB, DISCONNECT SWITCH, GREASE TRAP WITH DRAIN CONNECTION, HEAT BAFFLE, BEARINGS WITH GREASE FITTINGS, BELT GUARD 2. ELECTRICAL CONTRACTOR TO PROVIDE MAGNETIC HOA MOTOR STARTER WITH AUXILIARY CONTACTS AND WALL START/STOP PUSH PUTTON SWITCH. 3. ELECTRICAL CONTRACTOR TO PROVIDE MANUAL MOTOR STARTER AND WALL START/STOP PUSH PUTTON SWITCH. | | | | | | | | | | | |

| KITCHEN EXHAUST HOOD SCHEDULE | | | | | | | | | | | | | |
|---|--------------|-------|---------------|-------------------|--------------------|-------------------|----------------|-------------------------|----------------------|---------------|---------------------|--------|------|
| TAG | MANUFACTURER | MODEL | HOOD MATERIAL | SERVES | HOOD TYPE | SIZE L x W x D | EXHAUST CFM | EXHAUST S.P. in.w.c. | EXHAUST NECK SIZE | UL LISTING | FIRE SUPPRESSION | LIGHTS | NOTE |
| KH-1 | GREENHECK | GGEW | 300 SERIES SS | FRYER & RANGE | TYPE 1 HEAVY DUTY | 17" X 60" X 24" | 5100 | 1.53 | (2) 24" X 10" | 710 | ANSUL R-102 | YES | 1 |
| KH-2 | GREENHECK | GGEW | 300 SERIES SS | STEAMER & SKILLET | TYPE 1 MEDIUM DUTY | 17" X 60" X 24" | 3650 | 1.1 | (2) 17" x 10" | 710 | ANSUL R-102 | YES | 1 |
| KH-3 | GREENHECK | GO | 300 SERIES SS | DISH WASHER | CONDENSATE | 36" x 36" x 24" | 450 | 0.05 | 10" x 9" | 1150 | 22 X 10 | NO | 2 |
| NOTE 1. PROVIDE GREASE GRABER FILTER AND DUCT HEAT THERMOSTATS (2 PER HOOD) DOWNSTREAM OF EXHAUST BAFFLE ON HOOD. | | | | | | | | | | | | | |
| NOTE 2. PROVIDE CONDENSATE HOOD WITH CONDENSATE DRAIN CONNECTION. | | | | | | | | | | | | | |

| TAG | MANUFACTURER | MODEL | MATERIAL | FINISH | BRANCH SIZE | GRILLE NECK SIZE | GRILLE FACE SIZE | MOUNTING | VOLUME DAMPER | BLOW PATTERN | STYLE | REMARKS |
|------|--------------|----------|----------|-----------|-------------|------------------|------------------|----------|---------------|--------------|--|---------|
| CD1A | METAL-AIRE | 5750-6 | STEEL | OFF WHITE | 6" DIA | 6" DIA | 12 x 12 | SURFACE | NO | 4-WAY | CEILING SUPPLY DIFFUSER - PLAQUE | 2 |
| CD1B | METAL-AIRE | 5750-6 | STEEL | OFF WHITE | 6" DIA | 6" DIA | 24 x 24 | LAY-IN | NO | 4-WAY | CEILING SUPPLY DIFFUSER - PLAQUE | |
| CD2A | METAL-AIRE | 5200-2 | ALUMINUM | OFF WHITE | 8" DIA | 12 x 12 | 14 x 14 | SURFACE | NO | 4-WAY | CEILING SUPPLY DIFFUSER - LOUVER | 1 |
| CD2B | METAL-AIRE | 5750-6 | STEEL | OFF WHITE | 8" DIA | 8" DIA | 24 x 24 | LAY-IN | NO | 4-WAY | CEILING SUPPLY DIFFUSER - PLAQUE | |
| CD3A | METAL-AIRE | 5200-2 | ALUMINUM | OFF WHITE | 10" DIA | 12 x 12 | 14 x 14 | SURFACE | NO | 4-WAY | CEILING SUPPLY DIFFUSER - LOUVER | 1 |
| CD3B | METAL-AIRE | 5750-6 | STEEL | OFF WHITE | 10" DIA | 10" DIA | 24 x 24 | LAY-IN | NO | 4-WAY | CEILING SUPPLY DIFFUSER - PLAQUE | |
| CD4A | METAL-AIRE | 5200-2 | ALUMINUM | OFF WHITE | 12" DIA | 14 x 14 | 16 x 16 | SURFACE | NO | 4-WAY | CEILING SUPPLY DIFFUSER - LOUVER | 1 |
| CD4B | METAL-AIRE | 5750-6 | STEEL | OFF WHITE | 12" DIA | 12" DIA | 24 x 24 | LAY-IN | NO | 4-WAY | CEILING SUPPLY DIFFUSER - PLAQUE | |
| EG1A | METAL-AIRE | 5750-6 | STEEL | OFF WHITE | 6" DIA | 6" DIA | 12 x 12 | SURFACE | NO | -- | CEILING EXHAUST GRILLE - PLAQUE | 2 |
| EG1B | METAL-AIRE | 5750-6 | STEEL | OFF WHITE | 6" DIA | 6" DIA | 24 x 24 | LAY-IN | NO | -- | CEILING EXHAUST GRILLE - PLAQUE | |
| EG2A | METAL-AIRE | 5750-6 | STEEL | OFF WHITE | 8" DIA | 8" DIA | 12 x 12 | SURFACE | NO | -- | CEILING EXHAUST GRILLE - PLAQUE | 2 |
| EG2B | METAL-AIRE | RH-1 | ALUMINUM | OFF WHITE | 8" DIA | 14 x 14 | 16 x 16 | SURFACE | NO | -- | CEILING EXHAUST GRILLE - DEFLECTION BLADES | 1 |
| EG2C | METAL-AIRE | 5750-6 | STEEL | OFF WHITE | 8" DIA | 8" DIA | 24 x 24 | LAY-IN | NO | -- | CEILING EXHAUST GRILLE - PLAQUE | |
| EG3A | METAL-AIRE | 5750-6 | STEEL | OFF WHITE | 10" DIA | 10" DIA | 24 x 24 | LAY-IN | NO | -- | CEILING EXHAUST GRILLE - PLAQUE | |
| EG4 | METAL-AIRE | CCS-1 | ALUMINUM | OFF WHITE | 22 x 22 | 22 x 22 | 24 x 24 | SURFACE | NO | -- | CEILING EXHAUST GRILLE - EGG CRATE | |
| EG5 | METAL-AIRE | SRH-1 | STEEL | OFF WHITE | -- | 8 x 14 | 10 x 16 | SURFACE | NO | -- | SIDEWALL EXHAUST GRILLE | |
| EG6 | METAL-AIRE | SRH-1 | STEEL | OFF WHITE | -- | 6 x 12 | 8 x 14 | SURFACE | NO | -- | SIDEWALL EXHAUST GRILLE | |
| RG1A | METAL-AIRE | 5750-6 | STEEL | OFF WHITE | 6" DIA | 6" DIA | 12 x 12 | SURFACE | NO | -- | CEILING RETURN GRILLE - PLAQUE | 2 |
| RG1B | METAL-AIRE | 5750-6 | STEEL | OFF WHITE | 6" DIA | 6" DIA | 24 x 24 | LAY-IN | NO | -- | CEILING RETURN GRILLE - PLAQUE | |
| RG2A | METAL-AIRE | 5750-6 | STEEL | OFF WHITE | 8" DIA | 8" DIA | 12 x 12 | SURFACE | NO | -- | CEILING RETURN GRILLE - PLAQUE | 2 |
| RG2B | METAL-AIRE | RH-1 | ALUMINUM | OFF WHITE | 8" DIA | 14 x 14 | 16 x 16 | SURFACE | NO | -- | CEILING RETURN GRILLE - DEFLECTION BLADES | 1 |
| RG2C | METAL-AIRE | 5750-6 | STEEL | OFF WHITE | 8" DIA | 8" DIA | 24 x 24 | LAY-IN | NO | -- | CEILING RETURN GRILLE - PLAQUE | |
| RG3A | METAL-AIRE | RH-1 | ALUMINUM | OFF WHITE | 10" DIA | 14 x 14 | 16 x 16 | SURFACE | NO | -- | CEILING RETURN GRILLE - DEFLECTION BLADES | 1 |
| RG3B | METAL-AIRE | 5750-6 | STEEL | OFF WHITE | 10" DIA | 10" DIA | 24 x 24 | LAY-IN | NO | -- | CEILING RETURN GRILLE - PLAQUE | |
| RG4A | METAL-AIRE | RH-1 | ALUMINUM | OFF WHITE | 12" DIA | 14 x 14 | 16 x 16 | SURFACE | NO | -- | CEILING RETURN GRILLE - DEFLECTION BLADES | 1 |
| RG4B | METAL-AIRE | 5750-6 | STEEL | OFF WHITE | 12" DIA | 12" DIA | 24 x 24 | LAY-IN | NO | -- | CEILING RETURN GRILLE - PLAQUE | |
| RG5A | METAL-AIRE | 5750-6 | STEEL | OFF WHITE | 14" DIA | 14" DIA | 24 x 24 | LAY-IN | NO | -- | CEILING RETURN GRILLE - PLAQUE | |
| RG6A | METAL-AIRE | CCS-1 | ALUMINUM | OFF WHITE | 22 x 22 | 22 x 22 | 24 x 24 | LAY-IN | NO | -- | CEILING RETURN GRILLE - EGG CRATE | |
| RG6 | METAL-AIRE | SRH-1 | STEEL | OFF WHITE | 16 x 10 | 24 x 12 | 26 x 14 | SURFACE | NO | -- | SIDEWALL RETURN GRILLE - DEFLECTION BLADES | |
| RG7 | METAL-AIRE | SRH-1 | STEEL | OFF WHITE | 8" DIA | 12 x 8 | 14 x 10 | SURFACE | NO | -- | SIDEWALL RETURN GRILLE - DEFLECTION BLADES | |
| RG8 | METAL-AIRE | SRH-1 | STEEL | OFF WHITE | -- | 16 x 12 | 18 x 14 | SURFACE | YES | -- | SIDEWALL RETURN GRILLE - DEFLECTION BLADES | |
| RG9 | METAL-AIRE | SRH-1 | STEEL | OFF WHITE | -- | 24 x 16 | 24 x 18 | SURFACE | YES | -- | SIDEWALL RETURN GRILLE - DEFLECTION BLADES | |
| TG2 | METAL-AIRE | 5750-6 | STEEL | OFF WHITE | 8" DIA | 8" DIA | 12 X 12 | SURFACE | NO | -- | CEILING TRANSFER GRILLE - PLAQUE | 2 |
| TG3 | METAL-AIRE | 5750-6 | STEEL | OFF WHITE | 10" DIA | 10" DIA | 24 x 24 | LAY-IN | NO | -- | CEILING TRANSFER GRILLE - PLAQUE | |
| TG5 | METAL-AIRE | 5750-6 | STEEL | OFF WHITE | 14" DIA | 14" DIA | 24 x 24 | LAY-IN | NO | -- | CEILING TRANSFER GRILLE - PLAQUE | |
| SG1 | METAL-AIRE | H4004S-1 | STEEL | OFF WHITE | 8" DIA | 8 x 8 | 10 x 10 | SURFACE | NO | DBL DEFL | SIDEWALL SUPPLY GRILLE | |
| SG2 | METAL-AIRE | H4004S-1 | STEEL | OFF WHITE | -- | 24 x 16 | 26 x 18 | SURFACE | NO | DBL DEFL | SIDEWALL SUPPLY GRILLE | |
| SG3 | METAL-AIRE | H4004S-1 | STEEL | OFF WHITE | -- | 12 x 12 | 14 x 14 | SURFACE | YES | DBL DEFL | SIDEWALL SUPPLY GRILLE | |
| SG4 | METAL-AIRE | H4004S-1 | STEEL | OFF WHITE | -- | 24 x 12 | 26 x 14 | SURFACE | YES | DBL DEFL | SIDEWALL SUPPLY GRILLE | |
| SG5 | METAL-AIRE | H4004S-1 | STEEL | OFF WHITE | 16 x 10 | 22 x 10 | 24 x 12 | SURFACE | NO | DBL DEFL | SIDEWALL SUPPLY GRILLE | |
| SD1 | DONCO | J-21 | ALUMINUM | OFF WHITE | 8" DIA | 8" DIA | 2 slot 4" lng | LAY-IN | NO | -- | CEILING SUPPLY LINEAR SLOT DIFFUSER | 3 |
| SD2 | DONCO | J-21 | ALUMINUM | OFF WHITE | 10" DIA | 10" DIA | 2 slot 4" lng | LAY-IN | NO | -- | CEILING SUPPLY LINEAR SLOT DIFFUSER | 3 |

- NOTES:
1. PROVIDE AIRE TECHNOLOGIES, INC. MODEL 50 CRD BOOT AND RADIATION DAMPER ASSEMBLY FOR GRILLES AND DIFFUSERS LOCATED IN ONE HOUR FIRE RATED CEILINGS. RADIATION DAMPER BOOT ASSEMBLY SHALL MEET THE REQUIREMENTS OF UL 263 & 555C AND NFPA 90A.
2. PROVIDE AUXILIARY PLASTER SURFACE MOUNT FRAME.
3. PROVIDE 14" HIGH INSULATED PLENUM

| SEALED COMBUSTION GAS-FIRED BOILER SCHEDULE | | | | | | | | | | | | | | | | | |
|--|---------------|----------|---------------|-----------------|--------------------------|-----|-------------|-------------------|-----------------|---------------------|---------------|--------------------------------|-----------------|------|-------|--------|------------|
| TAG | MANUFACTURER | MODEL | GAS INPUT MBH | HEAT OUTPUT MBH | LEAVING WATER TEMP DEG F | GPM | BOILER EFF. | EXHAUST FLUE SIZE | COMB. AIR INLET | GAS TRAIN CERTIFIED | BURNER STAGES | ELECTRICAL COMPONENT CERTIFIED | DRAFT BLOWER HP | AMPS | VOLTS | WEIGHT | NOTES |
| B-1 | P-K MODU-FIRE | N2000MFD | 2000 | 1700 | 190 | 115 | 85 | 6" | 8" | F.M. & CSD-1 | MODULATING | U.L. | 1 | 12 | 208/1 | 990 | 1, 2, 3, 4 |
| B-2 | P-K MODU-FIRE | N2000MFD | 2000 | 1700 | 190 | 115 | 85 | 6" | 8" | F.M. & CSD-1 | MODULATING | U.L. | 1 | 12 | 208/1 | 990 | 1, 2, 3, 4 |
| B-3 | P-K MODU-FIRE | N2000MFD | 2000 | 1700 | 190 | 115 | 85 | 6" | 8" | F.M. & CSD-1 | MODULATING | U.L. | 1 | 12 | 208/1 | 990 | 1, 2, 3, 4 |
| B-4 | P-K MACH | C750 | 750 | 712.5 | 150 | 48 | 95 | 6" | 6" | F.M. & CSD-1 | MODULATING | U.L. | 0.4 | 5 | 120/1 | 695 | 1, 2, 3, 4 |
| NOTES: 1. MANUFACTURER TO PROVIDE BOILERS WITH 100 PSIG RELIEF VALVES AND 1 PSIG - 14" W.C. GAS PRESSURE REGULATOR 2. FULL BURNER MODULATION 20% - 100%, 5:1 TURN DOWN RATIO 3. BOILER PERFORMANCE BASED ON A STRAIGHT WATER SOLUTION 4. ELECTRICAL CONTRACTOR TO PROVIE DISCONNECT SWITCH | | | | | | | | | | | | | | | | | |

| UNIT | LOCATION | MFR | MODEL | CAP. TONS | COMPRESSOR TYPE | NO. OF REFRIGERATION CIRCUITS | CAP. UNLOAD STEPS | CHILLED WATER CONDITIONS | | | | EER | VOLTS | MCA AMPS | FUSE AMPS | WEIGHT LBS |
|---|----------|--------|---------|-----------|-----------------|-------------------------------|-------------------|--------------------------|----------------|-----------------|-----------------|-----|----------|----------|-----------|------------|
| | | | | | | | | GPM | ENT TEMP DEG F | LVNG TEMP DEG F | W.P.D. FT. w.c. | | | | | |
| ACWC-1 | ON GRADE | McQUAY | AGZ090D | 87 | SCROLL | 2 | 4 | 235 | 54 | 44 | 18.4 | 9.6 | 460/60/3 | 211.2 | 250 | 5,900 |
| ACWC-2 | ON GRADE | McQUAY | AGZ090D | 87 | SCROLL | 2 | 4 | 235 | 54 | 44 | 18.4 | 9.6 | 460/60/3 | 211.2 | 250 | 5,900 |
| NOTE: PROVIDE 5 YEAR COMPRESSOR WARRANTY, R-410a REFRIGERANT, CHILLED WATER FLOW SWITCH, FILTER DRYER, SINGLE POINT POWER CONNECTION, SOLID STATE MOTOR STARTERS, CONTROL TRANSFORMER, MICRO PROCESSOR CONTROL PANEL, WEATHER-PROOF DISCONNECT, FILTER DRYER, REFRIGERATION SERVICE VALVE PACKAGE, ELECTRIC HEATERS FOR EVAPORATOR TUBE BUNDLE, FACTORY START-UP, VIBRATION ISOLATORS. CHILLER PERFORMANCE IS BASED ON A 35% PROPYLENE GLYCOL SOLUTION AND 95 DEG. F AMBIENT AIR TEMPERATURE. | | | | | | | | | | | | | | | | |

| CIRCULATING PUMP SCHEDULE | | | | | | | | | | | | | | | | |
|---------------------------|--|--------------|------------|-----------------------|---------------------|------------|-----|------------------|---------------------|----------------------|-------------|-------------------|--------------|-------------|----------|---------------|
| TAG | SERVES | MANUFACTURER | SERIES | MODEL | PIPING CONN SIZE | EFFICIENCY | GPM | HEAD FT. W.C. | SUCTION DIFFUSER | TRIPLE DUTY VALVE | PUMP RPM | VAR FREQ DRIVE | MOTOR BHP | MOTOR HP | VOLTS | WEIGHT LBS |
| P-1 | BOILER B-1 | B & G | 80 | 2-1/2 x 2-1/2 x 7 | 2-1/2" FLNG | 68.72 | 115 | 40 | -- | 3DS-2-1/2G | 1750 | NO | 1.69 | 3 | 460/60/3 | 215 |
| P-2 | BOILER B-2 | B & G | 80 | 2-1/2 x 2-1/2 x 7 | 2-1/2" FLNG | 68.72 | 115 | 40 | -- | 3DS-2-1/2G | 1750 | NO | 1.69 | 3 | 460/60/3 | 215 |
| P-3 | BOILER B-3 | B & G | 80 | 2-1/2 x 2-1/2 x 7 | 2-1/2" FLNG | 68.72 | 115 | 40 | -- | 3DS-2-1/2G | 1750 | NO | 1.69 | 3 | 460/60/3 | 215 |
| P-4 | HW SYSTEM | B & G | 80 | 3 x 3 x 11 | 3" FLNG | 66.08 | 230 | 100 | -- | 3DS-4G | 1750 | YES | 8.94 | 15 | 460/60/3 | 325 |
| P-5 | HW SYSTEM | B & G | 80 | 3 x 3 x 11 | 3" FLNG | 66.08 | 230 | 100 | -- | 3DS-4G | 1750 | YES | 8.94 | 15 | 460/60/3 | 325 |
| P-6 | CW SYSTEM | B & G | 80 | 5 x 5 x 9-1/2 | 5" FLNG | 72 | 470 | 60 | -- | 3DS-5G | 1750 | YES | 9.91 | 15 | 460/60/3 | 405 |
| P-6A | CW ALT BID | B & G | 80 | 5 x 5 x 9-1/2 | 5" FLNG | 72 | 470 | 60 | -- | 3DS-5G | 1750 | YES | 9.91 | 15 | 460/60/3 | 405 |
| P-7 | CHILLER ACWC-1 | B & G | 80 | 4 x 4 x 7 | 4" FLNG | 65.31 | 235 | 35 | -- | 3DS-4G | 1750 | NO | 3.2 | 5 | 460/60/3 | 270 |
| P-8 | CHILLER ACWC-2 | B & G | 80 | 4 x 4 x 7 | 4" FLNG | 65.31 | 235 | 35 | -- | 3DS-4G | 1750 | NO | 3.2 | 5 | 460/60/3 | 270 |
| P-9 | RADIANT 1E | B & G | CIRCULATOR | PL-30 | 3/4" FLNG | -- | 2.2 | 15 | -- | 3/4" check v. | 2650 | NO | -- | 1/12 | 120/60/1 | 12 |
| P-10 | RADIANT 2E & 3E | B & G | CIRCULATOR | PL-30 | 3/4" FLNG | -- | 3.4 | 15 | -- | 3/4" check v. | 2650 | NO | -- | 1/12 | 120/60/1 | 12 |
| P-11 | RADIANT 1F & 2F | B & G | CIRCULATOR | PL-30 | 3/4" FLNG | -- | 4 | 15 | -- | 3/4" check v. | 2650 | NO | -- | 1/12 | 120/60/1 | 12 |
| P-12 | RADIANT 3F | B & G | CIRCULATOR | PL-30 | 3/4" FLNG | -- | 2 | 15 | -- | 3/4" check v. | 2650 | NO | -- | 1/12 | 120/60/1 | 12 |
| P-13 | RADIANT 1G & 2G | B & G | CIRCULATOR | PL-30 | 3/4" FLNG | -- | 4 | 15 | -- | 3/4" check v. | 2650 | NO | -- | 1/12 | 120/60/1 | 12 |
| P-14 | RADIANT 3G | B & G | CIRCULATOR | PL-30 | 3/4" FLNG | -- | 1.5 | 14 | -- | 3/4" check v. | 2650 | NO | -- | 1/12 | 120/60/1 | 12 |
| P-15 | RADIANT 1H | B & G | CIRCULATOR | PL-30 | 3/4" FLNG | -- | 1.5 | 14 | -- | 3/4" check v. | 2650 | NO | -- | 1/12 | 120/60/1 | 12 |
| P-16 | RADIANT 2H & 3H | B & G | CIRCULATOR | PL-30 | 3/4" FLNG | -- | 4.6 | 15 | -- | 3/4" check v. | 2650 | NO | -- | 1/12 | 120/60/1 | 12 |
| P-17 | RADIANT 1J & 2J | B & G | CIRCULATOR | PL-30 | 3/4" FLNG | -- | 3.4 | 15 | -- | 3/4" check v. | 2650 | NO | -- | 1/12 | 120/60/1 | 12 |
| P-18 | RADIANT 3J & 1K | B & G | CIRCULATOR | PL-30 | 3/4" FLNG | -- | 3.2 | 15 | -- | 3/4" check v. | 2650 | NO | -- | 1/12 | 120/60/1 | 12 |
| P-19 | BOILER B-4 | B & G | 60 | 1-1/2 x 1-1/2 x 6-1/4 | 1-1/2" FLNG | 61.98 | 48 | 30 | -- | 3DS-2S | 1750 | NO | 0.61 | 1 | 460/3 | 85 |
| NOTES: | | | | | | | | | | | | | | | | |
| 1 | PROVIDE PREMIUM EFFICIENT PUMP MOTORS. | | | | | | | | | | | | | | | |
| 2 | PROVIDE MOTORS ON PUMPS P-4, P-5 & P-6 WITH AEGIS BEARING PROTECTION RING. MOTOR SHALL BE SUITABLE FOR VARIABLE FREQUENCY DRIVE PERFORMANCE. | | | | | | | | | | | | | | | |
| 3 | ELECTRICAL CONTRACTOR TO PROVIDE MAGNETIC HOA MOTOR STARTER WITH 24 VOLT CONTROL TRANSFORMER FOR PUMPS P-1 THRU P-3 AND PUMPS P-7 & P-8. | | | | | | | | | | | | | | | |
| 4 | ELECTRICAL CONTRACTOR TO PROVIDE MANUAL HOA STARTERS WITH 24 VOLT CONTROL TRANSFORMER FOR PUMPS P-9 THRU P-18. | | | | | | | | | | | | | | | |

7/19/23 HVAC DRAFTING PROJECT FOR ONEIDA RESIDENT CARE CENTERED CARE COMMUNITY. NO USE, REPRODUCTION OR DISTRIBUTION OF THIS DRAWING, IN PART OR IN WHOLE, MAY BE MADE WITHOUT THE WRITTEN PERMISSION OF THE DESIGNER. REVISIONAL

| GENERAL NOTES: | |
|----------------|---|
| 1. | CONTRACTOR SHALL PROVIDE COMPLETE CONTRACTING SERVICES INCLUDING HEATING, VENTILATION AND AIR-CONDITIONING WORK, AND CONTROL WORK. |
| 2. | HVAC CONTRACTOR SHALL COORDINATE HIS WORK WITH OTHER TRADES TO MINIMIZE ANY CONFLICTS. |
| 3. | SEE DRAWINGS FOR SCHEDULES. |
| 4. | DO NOT FABRICATE DUCTWORK WITHOUT FIELD VERIFYING CLEARANCES. |
| 5. | DUCT SIZES SHOWN ARE INSIDE DIMENSIONS. |
| 6. | MEDIUM PRESSURE DUCTWORK TO HAVE TDC OR DUCT-MATE CONNECTIONS SYSTEM. |
| 7. | BETWEEN ALL DAMPER FRAMES AND DUCTWORK WILL BE SEALED AIR TIGHT. |
| 8. | ALL SUPPLY DUCT TAKE-OFFS SHALL BE INCREASED AREA OR CONICAL TAP. |
| 9. | PROVIDE MANUAL VOLUME DAMPER AT EACH SUPPLY, EXHAUST, AND RETURN DUCT BRANCH. |
| 10. | COORDINATE GRILLE AND DIFFUSERS LOCATIONS AND TYPES WITH LIGHTING LAYOUT AND CEILINGS TILES. |
| 11. | THE HEATING CONTRACTOR SHALL PROVIDE SHIELDS FOR EACH PIPE HANGER. |
| 12. | HEATING CONTRACTOR SHALL INSTALL CONTROL VALVES AND SENSING WELLS PROVIDED BY THE TEMPERATURE CONTROL CONTRACTOR. SEE TEMPERATURE CONTROL SPECIFICATIONS AND VERIFY WITH T.C.C. |
| 13. | VERIFY LOCATIONS OF ALL THERMOSTATS. |
| 14. | ALL MOTORS CONTROLLED WITH VFD'S MUST HAVE GROUNDING RINGS. |
| 15. | ALL WORK SHALL BE GUARANTEED FOR ONE YEAR FROM DATE OF ACCEPTANCE. |
| 16. | THESE NOTES COMPLEMENT THE SPECIFICATIONS; READ THE SPECIFICATIONS FOR COMPLETE REQUIREMENTS. |

| Air Handling Unit AHU-4 Air Balance | | | | | | | | |
|--|---------|------------|----------|---------|--------|-------|-----------|--------|
| Occupied Mode Kitchen Hood Fans ON | | | | | | | | |
| | Kitchen | Kit Office | Corridor | Servery | Dining | Recep | Space Sum | AHU-4 |
| Supply | 8560 | 260 | 460 | 1440 | 3760 | 2520 | 17000 | 17000 |
| Hood Exh | 9200 | | | | | | 9200 | |
| Tlt Exhaust | | | | | | 680 | 680 | |
| Return | 0 | 260 | 460 | 800 | 3760 | 1840 | 7120 | 7200 |
| Transfer Air | +640 | | | -640 | | | - - | |
| Outside Air | | | | | | | | 9800 |
| Relief Air | | | | | | | | -80 |
| Occupied Mode Kitchen Hood Fans OFF | | | | | | | | |
| | Kitchen | Kit Office | Corridor | Servery | Dining | Recep | Space Sum | AHU-4 |
| Supply | 4400 | 260 | 460 | 1440 | 3760 | 2520 | 12840 | 12840 |
| Hood Exh | 0 | | | | | | 0 | |
| Tlt Exhaust | | | | | | 680 | 680 | |
| Return | 4400 | 260 | 460 | 1440 | 3760 | 1840 | 12160 | 10840 |
| Outside Air | | | | | | | | 2000 |
| Relief Air | | | | | | | | +1320 |
| Economizer Occupied Mode Kitchen Hood Fans ON | | | | | | | | |
| | Kitchen | Kit Office | Corridor | Servery | Dining | Recep | Space Sum | AHU-4 |
| Supply | 8560 | 260 | 460 | 1440 | 3760 | 2520 | 17000 | 17000 |
| Hood Exh | 9200 | | | | | | 9200 | |
| Tlt Exhaust | | | | | | 680 | 680 | |
| Return | 0 | 260 | 460 | 800 | 3760 | 1840 | 7120 | 0 |
| Transfer Air | +640 | | | -640 | | | | |
| Outside Air | | | | | | | | 17000 |
| Relief Air | | | | | | | | +7120 |
| Economizer Occupied Mode Kitchen Hood Fans OFF | | | | | | | | |
| | Kitchen | Kit Office | Corridor | Servery | Dining | Recep | Space Sum | AHU-4 |
| Supply | 4400 | 260 | 460 | 1440 | 3760 | 2520 | 12840 | 12840 |
| Hood Exh | 0 | | | | | | | |
| Tlt Exhaust | | | | | | 680 | 680 | |
| Return | 4400 | 260 | 460 | 1440 | 3760 | 1840 | 12160 | 0 |
| Outside Air | | | | | | | | 12840 |
| Relief Air | | | | | | | | +12160 |
| Unoccupied Mode Kitchen Hood Fans OFF | | | | | | | | |
| | Kitchen | Kit Office | Corridor | Servery | Dining | Recep | Space Sum | AHU-4 |
| Supply | 4280 | 130 | 300 | 800 | 2430 | 1900 | 9840 | 9840 |
| Hood Exh | 0 | | | | | | | |
| Tlt Exhaust | | | | | | 0 | 0 | |
| Return | 4280 | 130 | 300 | 800 | 2430 | 1900 | 9840 | 9640 |
| Outside Air | | | | | | | | 200 |
| Relief Air | | | | | | | | +200 |

| AIR HANDLING UNIT SCHEDULE | | | | | | | | | | | | | | | | | | |
|---|--------------------------|--------|------------|-------|---------------|------------|------------------|------------|------------|---------|-----------------|----------------|-----------------|--------------|------------------|-------------|--------|----------|
| UNIT TAG | SERVES | MFR | MODEL | CFM | MIN. O.A. CFM | TOTAL S.P. | FAN TYPE | BRAKE H.P. | MOTOR H.P. | FAN RPM | OUTLET VELOCITY | VAR. FRQ DRIVE | INTERNAL F & BP | INLET FILTER | DISCHARGE FILTER | | WEIGHT | VOLTS |
| | | | | | | | | | | | | | | | PRE | FINAL | | |
| AHU-1 | RESIDENT WINGS E, F, G | McQUAY | CAH038GDDM | 17250 | NOTE 1. | 5.5 | 33" AF PLENUM | 20.8 | 25 | 1345 | 384 | YES | NO | 2" MERV 7 | 2" MERV 8 | 12" MERV 13 | 5385 | 460/60/3 |
| AHU-2 | RESIDENT WINGS H, J | McQUAY | CAH026GDDC | 12250 | NOTE 2. | 5 | 27" AF PLENUM | 13.4 | 20 | 1640 | 384 | YES | NO | 2" MERV 7 | 2" MERV 8 | 12" MERV 13 | 4055 | 460/60/3 |
| AHU-3 | INTER ACTIVITY & SERVICE | McQUAY | CAH024GDDM | 10000 | 3000 | 5 | 22.25" AF PLENUM | 12.4 | 15 | 2276 | 343 | YES | YES | 2" MERV 7 | 2" MERV 8 | 12" MERV 13 | 3750 | 460/60/3 |
| AHU-4 | KITCHEN & DINING | McQUAY | CAH039GDDC | 17000 | 9800 | 5 | 33" AF PLENUM | 18.7 | 25 | 1297 | 403 | YES | YES | 2" MERV 7 | 2" MERV 8 | 12" MERV 13 | 6025 | 460/60/3 |
| NOTE 1: 5370 CFM OF OUTSIDE AIR IS PROVIDED THRU ENERGY RECOVERY UNITS ERU-1, 2, 3. HW & CW COILS ARE SIZED TO CONDITION 2750 CFM OF OUTSIDE AIR. | | | | | | | | | | | | | | | | | | |
| NOTE 2: 3570 CFM OF OUTSIDE AIR IS PROVIDED THRU ENERGY RECOVERY UNITS ERU-4 & 5. HW & CW COILS ARE SIZED TO CONDITION 2000 CFM OF OUTSIDE AIR. | | | | | | | | | | | | | | | | | | |
| NOTE 3: ELECTRICAL CONTRACTOR TO PROVIDE DISCONNECT SWITCH. | | | | | | | | | | | | | | | | | | |
| NOTE: PROVIDE HORIZONTAL DOUBLE WALL INSULATED CABINET CONSTRUCTION, INTERNAL VIBRATION ISOLATORS, PREMIUM EFFICIENT MOTOR WITH GROUNDING RINGS SUITABLE FOR VFD'S, FINAL FILTER SECTION, CHILLED WATER COOLING COIL, 24" MIN BLANK ACCESS SECTION, HOT WATER HEATING COIL, PANEL INLET FILTER SECTION WITH 2" THICK MERV 7 FILTERS, FAN MOTORS WITH AEGIS BEARING PROTECTION RING. | | | | | | | | | | | | | | | | | | |

| HEATING COIL SCHEDULE | | | | | | | | | | | | | | | | | | |
|-----------------------|----------|--------|----------|-------|---------|------------|---------------------|-------------|------------------|---------|------|--------------|-----|------------------|----------------|----------------|--------------|--------------|
| UNIT TAG | LOCATION | MFR | MODEL | CFM | VEL FPM | AREA SQ FT | SIZE height x width | NO OF COILS | PIPING CONN SIZE | FINS/IN | ROWS | CAPACITY MBH | GPM | ENT WATER DEG. F | ENT AIR DEG. F | LVG AIR DEG. F | APD IN. w.c. | WPD FT. w.c. |
| | | | | | | | | | | | | | | | | | | |
| HC-1 | AHU-1 | McQUAY | 5WB0601B | 17250 | 527 | 32.25 | 27" x 86" | 2 | 1-1/2" | 6 | 1 | 238.7 | 18 | 190 | 52 | 65 | 0.08 | 0.3 |
| HC-2 | AHU-2 | McQUAY | 5WB0601B | 12250 | 514 | 23.33 | 24" x 70" | 2 | 1-1/2" | 6 | 1 | 168.5 | 13 | 190 | 52 | 65 | 0.07 | 0.5 |
| HC-3 | AHU-3 | McQUAY | 5WB1101B | 10000 | 606 | 16.5 | 33" x 72" | 1 | 1-1/2" | 11 | 1 | 259.2 | 20 | 190 | 41 | 65 | 0.15 | 2.7 |
| HC-4 | AHU-4 | McQUAY | 5WB0902B | 17000 | 678 | 25.08 | 42" x 86" | 1 | 2-1/2" | 9 | 2 | 789.5 | 60 | 190 | 19 | 65 | 0.29 | 4.8 |

| CHILLED WATER COOLING COIL SCHEDULE | | | | | | | | | | | | | | | | | | |
|--|----------|--------|----------|-------|---------|------------|---------------------|--------------|------------------|---------|------|--------------|-----|------------------|----------------|----------------|--------------|--------------|
| UNIT TAG | LOCATION | MFR | MODEL | CFM | VEL FPM | AREA SQ FT | SIZE height x width | NO. OF COILS | PIPING CONN SIZE | FINS/IN | ROWS | CAPACITY MBH | GPM | ENT WATER DEG. F | ENT AIR DEG. F | LVG AIR DEG. F | APD IN. w.c. | WPD FT. w.c. |
| | | | | | | | | | | | | | | | | | | |
| CC-1 | AHU-1 | McQUAY | 5WM1106B | 17250 | 509 | 33.38 | 27" x 89" | 2 | 2-1/2" | 11 | 6 | 533.7 | 118 | 44 | 77.8 / 64.7 | 55 / 54.2 | .73 | 9.1 |
| CC-2 | AHU-2 | McQUAY | 5WS1106B | 12250 | 493 | 24.33 | 24" x 73" | 2 | 2" | 11 | 6 | 384.3 | 84 | 44 | 77.9 / 64.8 | 55 / 54.2 | .74 | 14.5 |
| CC-3 | AHU-3 | McQUAY | 5WM0808B | 10000 | 457 | 21.88 | 42" x 75" | 1 | 2-1/2" | 8 | 8 | 384.8 | 84 | 44 | 80.0 / 66.6 | 55 / 54.2 | .71 | 10.6 |
| CC-4 | AHU-4 | McQUAY | 5WD1008B | 17000 | 509 | 33.38 | 27" x 89" | 2 | 2-1/2" | 10 | 8 | 831.6 | 184 | 44 | 85.2 / 70.0 | 55 / 54.2 | 1.02 | 13.8 |
| NOTE: COOLING COIL PERFORMANCE IS BASED ON A 35% PROPYLENE GLYCOL SOLUTION | | | | | | | | | | | | | | | | | | |

| RETURN EXHAUST FAN SCHEDULE | | | | | | | | | | | |
|---|--------|--------------|--------|------------|-------------------|-------|------------------|-----|-------|---------|-------|
| UNIT NUMBER | SERVES | MANUFACTURER | MODEL | TYPE | FAN | CFM | T. S. P. (IN WC) | RPM | HP | VOLTAGE | NOTES |
| REF-1 | AHU-1 | GREENHECK | QEI-33 | MIXED FLOW | AXIAL/CENTRIFUGAL | 17000 | 1.75 | 880 | 10 | 460/3 | 1, 2 |
| REF-2 | AHU-2 | GREENHECK | QEI-30 | MIXED FLOW | AXIAL/CENTRIFUGAL | 12000 | 1.5 | 865 | 7-1/2 | 460/3 | 1, 2 |
| REF-3 | AHU-3 | GREENHECK | QEI-27 | MIXED FLOW | AXIAL/CENTRIFUGAL | 9500 | 1.5 | 930 | 7-1/2 | 460/3 | 1, 2 |
| REF-4 | AHU-4 | GREENHECK | QEI-30 | MIXED FLOW | AXIAL/CENTRIFUGAL | 12000 | 1.5 | 990 | 7-1/2 | 460/3 | 1, 2 |
| NOTES: 1. MANUFACTURER TO FURNISH FAN WITH PREMIUM EFFICIENT MOTOR WITH AEGIS BEARING PROTECTION RING FOR FREQ DRIVE CONTROL, VIBRATION ISOLATORS, BELT GUARD, COMPANION FLANGES 2. ELECTRICAL CONTRACTOR TO PROVIDE DISCONNECT SWITCH. | | | | | | | | | | | |

| ENERGY RECOVERY UNIT SCHEDULE | | | | | | | | | | | | | | | | | | | | | | | | | | | |
|--|-----------|-----------|--------|------------|----------|-------------------|-----------|----------|------------|-------------|-------------|-------------|-------------------|-----------|----------|------------|-------------|------|----|-----------------|---------------------|----------------|----------------------|---------|-------------------|--------------|-------------|
| UNIT TAG | MFR | MODEL | SERVES | SUPPLY FAN | | | | | | | | EXHAUST FAN | | | | | | | | OA PLATE EFFECT | ELECTRIC PREHEAT KW | STAGES OF HEAT | ELECTRIC PREHEAT MBH | VOLTAGE | MIN. CIRCUIT AMPS | BREAKER AMPS | WEIGHT LBS. |
| | | | | SUPPLY CFM | MOTOR HP | EXTER SP in. w.g. | WINTER | | SUMMER | | EXHAUST CFM | MOTOR HP | EXTER SP in. w.g. | WINTER | | SUMMER | | | | | | | | | | | |
| | | | | | | | ENT. D.B. | LV. D.B. | ENT. DB/WB | LV. DB/WB | | | | ENT. D.B. | LV. D.B. | ENT. DB/WB | LV. DB/WB | | | | | | | | | | |
| ERU-1 | GREENHECK | Pve-35-SC | AHU-1 | 2270 | 1 | 0.6 | 5 | 45.7 | 90 / 75 | 80.6 / 72.4 | 2270 | 1-1/2 | 1 | 70 | 27.8 | 75 / 63 | 84.7 / 65.8 | 62.6 | 15 | 2 | 51.2 | 460/60/3 | 24.9 | 30 | 1200 | | |
| ERU-2 | GREENHECK | Pve-20-SC | AHU-1 | 1480 | 3/4 | 0.5 | 5 | 45.4 | 90 / 75 | 80.7 / 72.4 | 1480 | 1 | 1 | 70 | 28.1 | 75 / 63 | 84.7 / 65.8 | 64.4 | 10 | 2 | 34.1 | 460/60/3 | 17 | 25 | 925 | | |
| ERU-3 | GREENHECK | Pve-20-SC | AHU-1 | 1620 | 3/4 | 0.5 | 5 | 45.1 | 90 / 75 | 80.7 / 72.4 | 1620 | 1 | 1 | 70 | 28.5 | 75 / 63 | 84.6 / 65.8 | 61.7 | 10 | 2 | 34.1 | 460/60/3 | 17 | 25 | 925 | | |
| ERU-4 | GREENHECK | Pve-20-SC | AHU-2 | 1360 | 3/4 | 0.4 | 5 | 45.6 | 90 / 75 | 80.6 / 72.4 | 1360 | 1 | 1 | 70 | 27.9 | 75 / 63 | 84.7 / 65.8 | 62.5 | 10 | 2 | 34.1 | 460/60/3 | 17 | 25 | 925 | | |
| ERU-5 | GREENHECK | Pve-35-SC | AHU-2 | 2210 | 1 | 0.4 | 5 | 45.8 | 90 / 75 | 80.6 / 72.4 | 2210 | 1-1/2 | 1 | 70 | 27.8 | 75 / 63 | 84.8 / 65.8 | 73.8 | 15 | 2 | 51.2 | 460/60/3 | 24.9 | 30 | 1200 | | |
| NOTES: | | | | | | | | | | | | | | | | | | | | | | | | | | | |
| 1. DESIGN WINTER LEAVING SUPPLY TEMPERATURE CONDITION IS BASED ON THE ELECTRIC HEATER BEING ACTIVATED. | | | | | | | | | | | | | | | | | | | | | | | | | | | |
| 2. ACTIVATE THE ELECTRIC PREHEATER (2 STAGE) TO MAINTAIN A WINTER EXHAUST LEAVING AIR TEMPERATURE OF 35 DEG. F FOR FROST PROTECTION. | | | | | | | | | | | | | | | | | | | | | | | | | | | |
| 3. PROVIDE 2" THICK MERV 8 SUPPLY AND EXHAUST FILTERS, 24" HIGH ROOF CURB, INTAKE AIR MOTORIZED DAMPER AND HOOD WITH BIRD SCREEN. | | | | | | | | | | | | | | | | | | | | | | | | | | | |
| 4. PROVIDE HIGH EFFICIENCY FAN MOTORS. | | | | | | | | | | | | | | | | | | | | | | | | | | | |

ONEIDA RESIDENT -
CENTERED CARE COMMUNITY
2907 SOUTH OVERLAND ROAD
ONEIDA, WI 54155-8959

| REVISION HISTORY | |
|------------------|-----------------|
| | RECORD DRAWINGS |
| | |
| | |
| | |
| | |
| TITLE | |
| HVAC SCHEDULES | |
| | |
| | |
GENERAL NOTES:

- A. LIGHTING COMPLIES WITH 2006 IECC SECTION 505 AS AMENDED BY WI COMM 65.505.
- B. EXIT SIGNS AND EGRESS LIGHTING SHALL BE WIRED TO PANELBOARD LSHPA1, CIRCUIT NUMBER AS INDICATED.
- C. REFER TO SHEET E-803 FOR LIGHTING FIXTURE AND SWITCH SCHEDULES.
- D. FIXTURE TYPE 'VS' IS FOR RESIDENT SAFETY AND IS THUS EXEMPT FROM AUTOMATIC SHUTOFF OR SWITCH REQUIREMENTS OF ENERGY CONSERVATION OR DAYLIGHTING REQUIREMENTS.

PLAN NOTES:

1. PROVIDE 20A SINGLE-POLE SWITCH FOR RECEPTACLE. REFER TO POWER PLAN FOR LOCATION OF RECEPTACLE. TYPICAL FOR ALL RESIDENT ROOMS.
2. PROVIDE TIMER SWITCH FOR HEAT LAMP. REFER TO POWER PLAN FOR LOCATION OF HEAT LAMP. TYPICAL FOR ALL RESIDENT ROOMS.
3. PROVIDE WATTSTOPPER ELCU-200 UL-924 DEVICE FOR SWITCHED EMERGENCY FIXTURES IN THIS AREA. REFER TO DETAILS SHEET E-702 FOR WIRING DIAGRAM. EMERGENCY FIXTURES SHALL FOLLOW SWITCHING OF NORMAL FIXTURES IN THE AREA AND SWITCH ON BYPASSING CONTROL DEVICE WHEN SENSING NORMAL POWER LOSS.
4. DAYLIGHTING AREA.
5. THE LIGHTING POWER DENSITY IN THIS AREA IS BELOW 0.8W/SQFT AND IS THUS EXEMPT FROM DAYLIGHTING CONTROL REQUIREMENTS AND BELOW 0.6W/SQFT REQUIREMENT FOR LIGHTING LEVEL REDUCTION.
6. PROVIDE VERTICALLY MOUNTED DISPLAY CASE LIGHTING IN CORNERS OF (4) DISPLAY CASES. USE (2) 12" AND (1) 3" LED STRIPLIGHT IN EACH CORNER FOR A TOTAL OF (16) PART # AND-LC-W29-12 AND (8) PART # AND-LC-W29-3 OF ANDROMEDA LC SERIES LIGHTING. PROVIDE CORNER CHANNEL FOR MOUNTING. PROVIDE POWER SUPPLY AND WIRE TO PANELBOARD NLPD1 CIRCUIT 37.

RESIDENT ROOM NORMAL POWER 120V CIRCUITS: NLPD1
RESIDENT ROOM CRITICAL POWER 120V CIRCUITS: CRHPA1
CORRIDOR NORMAL POWER 277V CIRCUITS: NHP1
CORRIDOR CRITICAL POWER 277V CIRCUITS: CRHP1
CORRIDOR LIFE SAFETY POWER 277V CIRCUITS: LSHPA1

CORE NORMAL POWER 277V CIRCUITS: NHP1
CORE NORMAL POWER 120V CIRCUITS: NLPD1
CORE CRITICAL POWER 277V CIRCUITS: CRHP1
CORE LIFE SAFETY POWER 277V CIRCUITS: LSHPA1

MATCHLINE E-101-1

AREA 1
(E-101-1)

AREA 2
(E-101-2)

AREA 3
(E-101-3)

GEN-1

CORE NORMAL POWER 277V CIRCUITS: NHP1
CORE NORMAL POWER 120V CIRCUITS: NLPD1
CORE CRITICAL POWER 277V CIRCUITS: CRHP1
CORE LIFE SAFETY POWER 277V CIRCUITS: LSHPA1

KITCHEN AND DINING ROOM NORMAL POWER 277V CIRCUITS: NHP1
KITCHEN AND DINING ROOM LIFE SAFETY POWER 277V CIRCUITS: LSHPA1

Oneida Resident-Centered Care Community
2907 SOUTH OVERLAND ROAD
Oneida, WI

Partial Lighting Plan - Area 3

| NO. | REVISIONS: |
|-----|-------------------------|
| 0 | ISSUED FOR PLAN REVIEW |
| 1 | ISSUED FOR CONSTRUCTION |
| 2 | AS-BUILT |
| 3 | AS-BUILT |

| DATE: | NO. | REVISIONS: |
|------------|-----|-------------------------|
| 09/27/2011 | 0 | ISSUED FOR PLAN REVIEW |
| 04/04/2012 | 1 | ISSUED FOR CONSTRUCTION |
| 06/12/2012 | 2 | AS-BUILT |
| 02/06/2013 | 3 | AS-BUILT |

PROJECT NUMBER
233588

DRAWN BY: JAM
CHECKED BY: RWK
APPROVED BY: ED
DATE: 09/27/2011
SCALE: 1/8" = 1'-0"

SHEET
E-101-3

FAITH
TECHNOLOGIES
ELECTRICAL CONTRACTOR

2662 American Drive, P.O. Box 627
Oneida, WI 54987
(920) 725-5500
www.faithtechnologies.com

Copyright © Faith Technologies, Inc. 2011. All Rights Reserved. No use, reproduction, or distribution of this document is permitted without the written authorization from Faith Technologies, Inc. The content of this document is subject to individual property rights and all such rights are expressly reserved and are not waived. Under no circumstances, including but not limited to negligence, shall Faith Technologies, Inc. be liable for any direct, indirect, incidental, special, or consequential damages of any kind or for any loss of profits or business interruption.

GENERAL NOTES:

- A. ALL RECEPTACLES IN RESIDENT ROOMS SHALL BE MOUNTED AT 24" AFF UNLESS NOTED OTHERWISE.

PLAN NOTES: XX

1. PROVIDE CEILING MOUNTED RECEPTACLE AND DATA CONNECTION FOR PROJECTOR.
2. PROVIDE CONNECTION IN ACCESSIBLE CEILING SPACE TO MOTORIZED PROJECTION SCREEN.
3. ALL EQUIPMENT AND RECEPTACLES IN THE KITCHEN AND DINING ROOM SHALL BE WIRED TO PANELBOARD NLPK1 AND NLPK2.
4. PROVIDE A SHUNT TRIP BREAKER IN PANELBOARD NLPK1 TO FEED NLPK1A. WIRE ALL HEAT-PRODUCING ELECTRICAL EQUIPMENT BENEATH THE KITCHEN HOODS TO PANELBOARD NLPK1A. PROVIDE 120V CIRCUIT FROM PANELBOARD NLPK1 FOR CIRCUIT BREAKER.
5. PROVIDE 1" CONDUIT FROM POWER UNIT TO DOCK LIFT PIT.
6. IN ADDITION TO GENERATOR FEEDER CONDUIT PROVIDE (3) 1" CONDUITS FROM GENERATOR TO ATS ROOM FOR REMOTE STOP, ENGINE START SIGNAL, FUTURE REMOTE START, AND ANNUNCIATOR PANEL. PROVIDE 3/4" CONDUIT TO PANELBOARD LSLPA1 IN ELECTRICAL ROOM 2029 FOR GENERATOR LOAD CENTER.
7. PROVIDE (1) 1" CONDUIT FROM MECHANICAL ROOM 1034 TO TELECOM ROOM 3001.
8. REFER TO FOOD SERVICE PLANS FOR EXACT LOCATIONS OF ALL EQUIPMENT CONNECTIONS PRIOR TO ROUGH-IN IN KITCHEN AND SERVARY AREAS.
9. PROVIDE FLOOR BOXES FOR EQUIPMENT ALONG SERVARY LINE.
10. PROVIDE EQUIPMENT CONNECTION FROM CEILING.

RESIDENT ROOM NORMAL POWER CIRCUITS: NLPK1
RESIDENT ROOM CRITICAL POWER CIRCUITS: CRLPK1

NORMAL POWER CIRCUITS: NLPK1
CRITICAL POWER CIRCUITS: CRLPK1

MATCHLINE E-201-1

AREA 1
(E-201-1)

AREA 2
(E-201-2)

AREA 3
(E-201-3)

GEN LOAD CENTER-2
GEN LOAD CENTER-6

GEN-1
GEN-2
GEN-3
GEN-1000

T-UTILITY

METER

CT CABINET

ACWC-1
DSC-ACWC-1

ACWC-2
DSC-ACWC-2

SES-1

FSD

LSPK1-6

ATS-EQ1

ATS-EQ2

ATS-EQ3

ATS-EQ102


ATS-EQ103

ATS-EQ104

ATS-EQ105

ATS-EQ106

ATS-EQ107

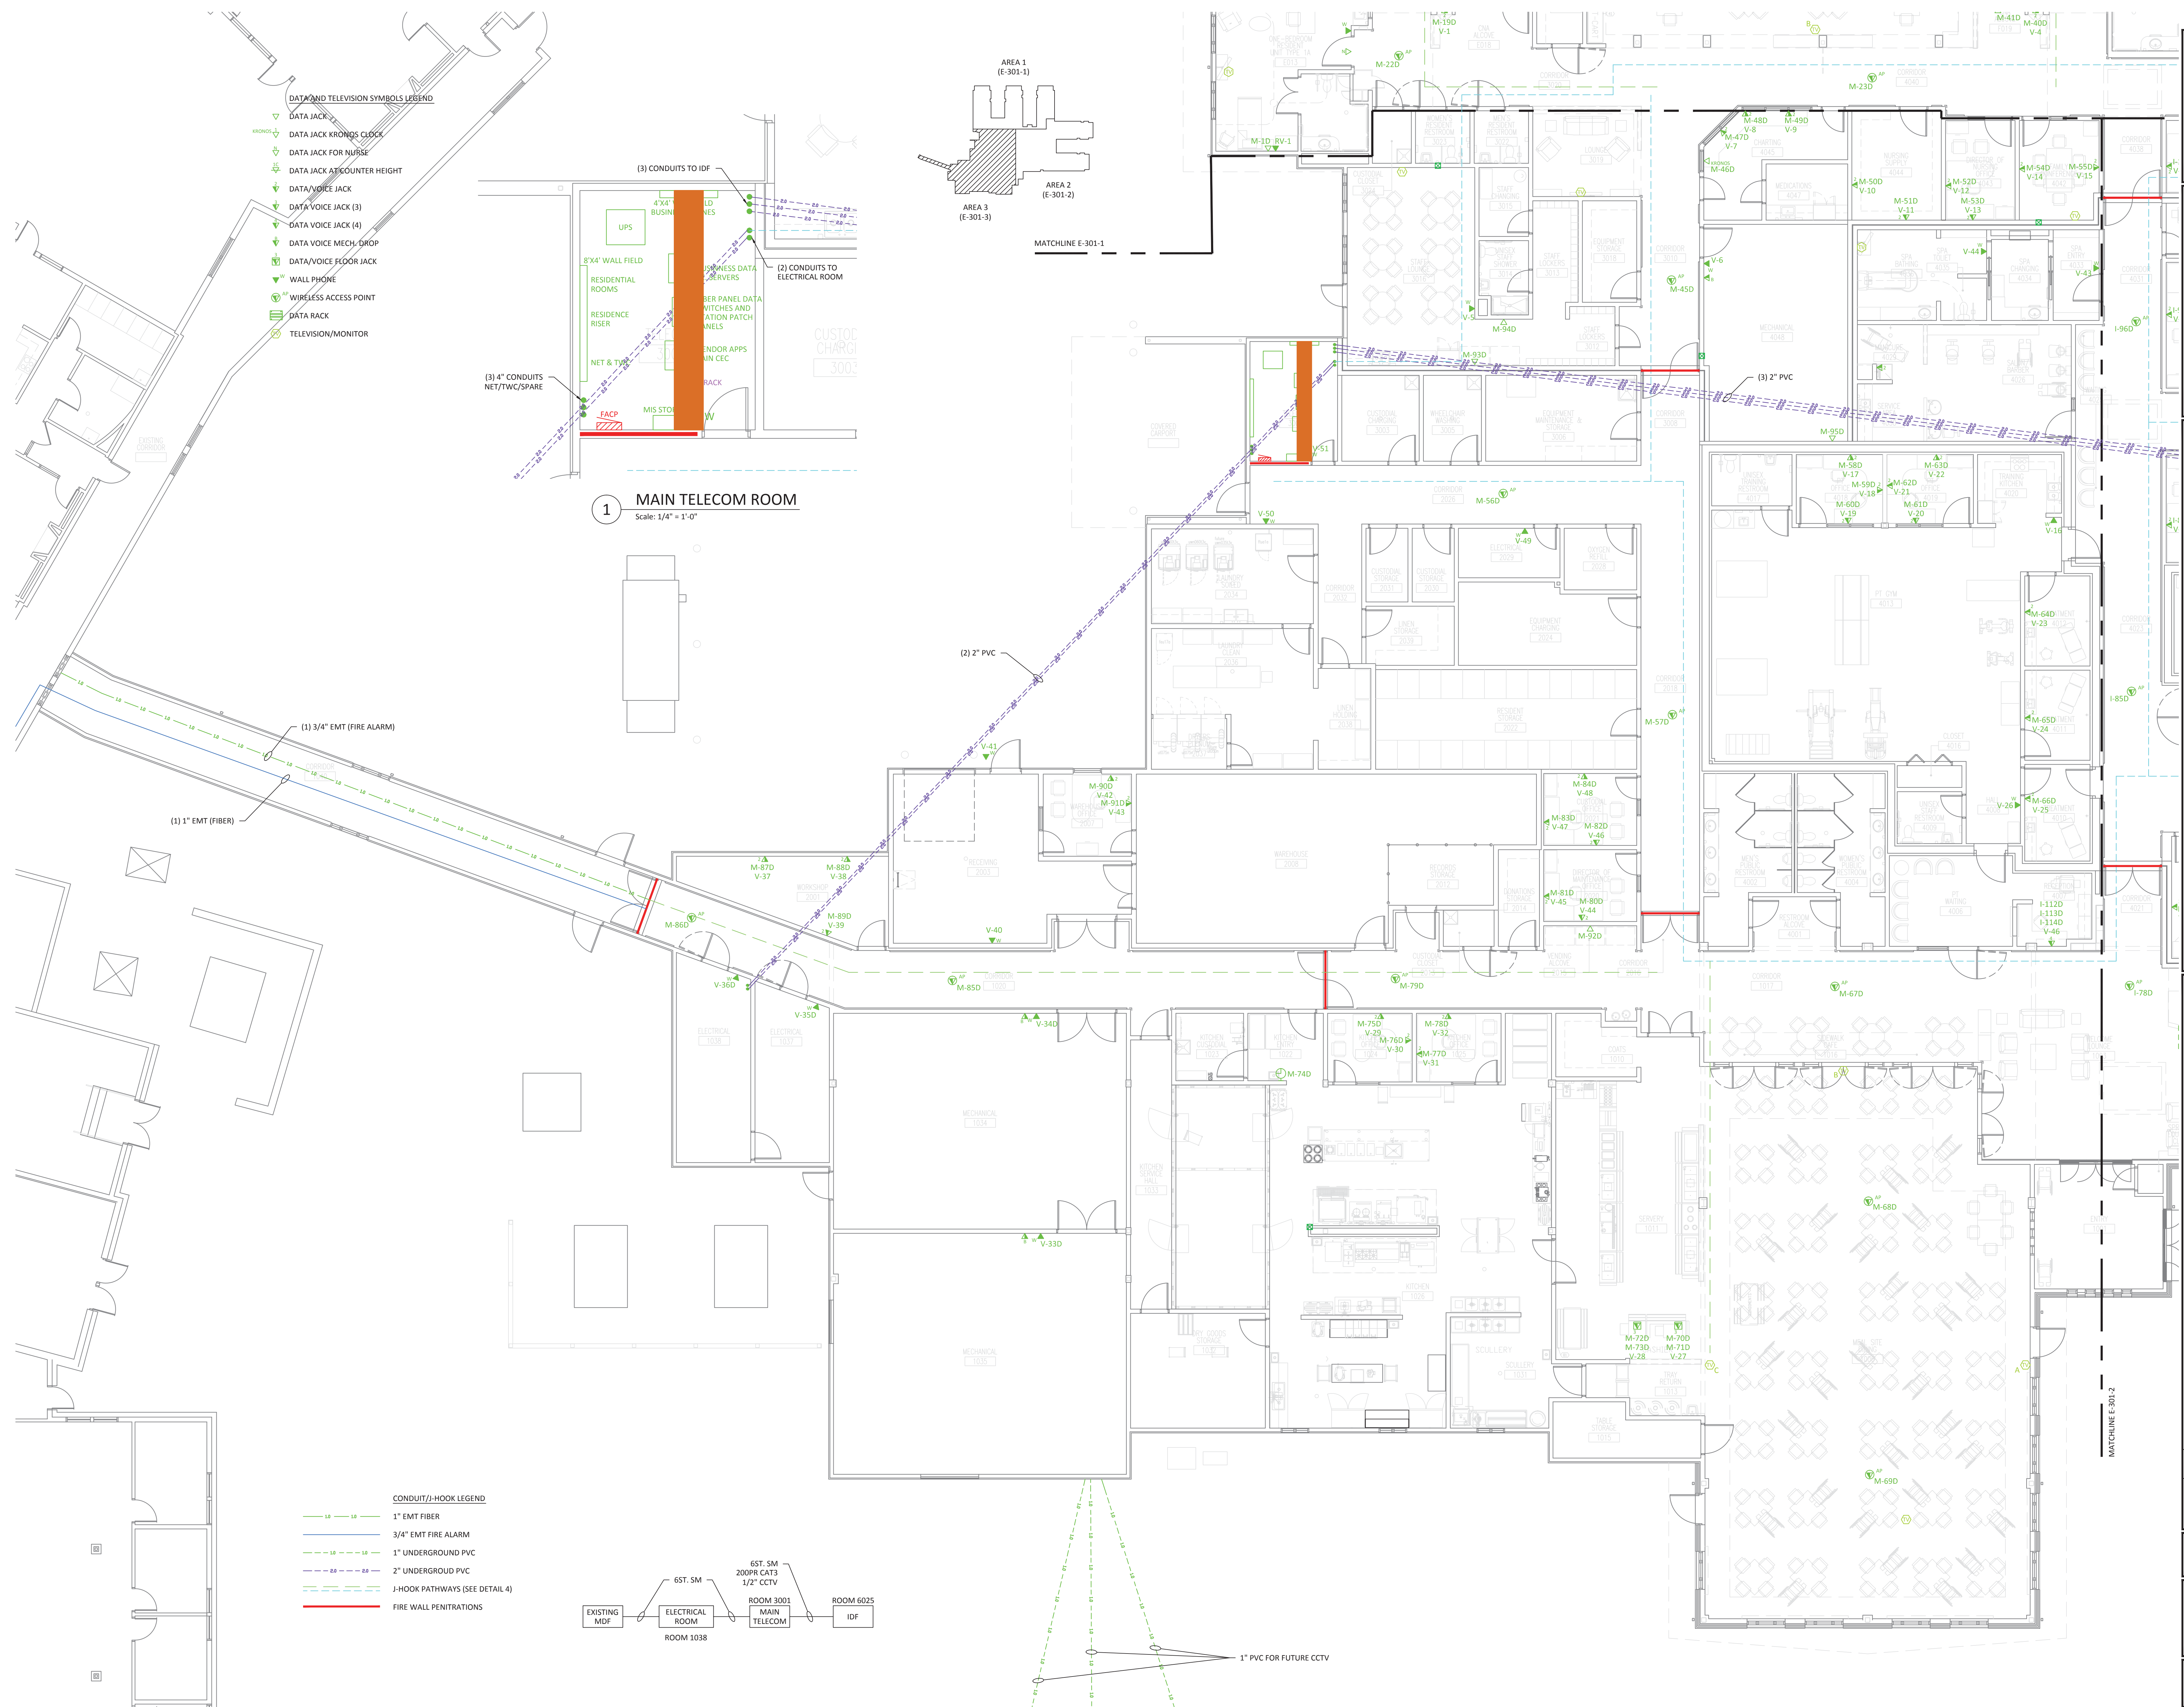

FATH
TECHNOLOGIES
ELECTRICAL CONTRACTOR

552 American Drive, P.O. Box 627
Appleton, WI 54912-0627
(920) 225-6500 office
www.faithtechologies.com

Oneida Resident-Centered Care Community

2907 SOUTH OVERLAND ROAD

Oneida, WI

Partial Data and Television Plan - Area 3

Copyright © Sath Technologies, Inc. 2011. All Rights Reserved. No use, reproduction, or duplication of this document in part or whole may be made without prior written authorization from Sath Technologies, Inc. The contents of this document are subject to intellectual property rights and all such rights are expressly claimed and are not waived. Under no circumstances, including but not limited to negligence, shall Sath Technologies, Inc. be liable for any direct, indirect, incidental, punitive, or consequential damages or other claims that result from the unauthorized duplication or use of this document or any part of this document.

| | | |
|-----|------------|-------------------------|
| NO: | DATE: | REVISIONS: |
| 0 | 09/27/2011 | ISSUED FOR PLAN REVIEW |
| 1 | 11/15/2011 | UPDATED PLAN |
| 2 | 11/30/2011 | REMOVED SECURITY |
| 3 | 12/15/2011 | UPDATED PLAN |
| 4 | 04/04/2012 | ISSUED FOR CONSTRUCTION |
| 5 | 01/03/2013 | AS-BUILT |

PROJECT NUMBER

233588

DRAWN BY: JAM

CHECKED BY: KS

APPROVED BY: EB

DATE: 09/27/2011

SCALE: 1/8" = 1'-0"

SHEET

E-301-3

| NLPD1 | | | | | | | | | | | |
|-------------------------------|---------|---|-----------|-----------------------|-------|-----------|-----------------|--|----------|------|-------------|
| ROOM ELECTRICAL ROOM 2029 | | | | VOLTS 208Y/120V 3P 4W | | | | AIC 14k | | | |
| MOUNTING SURFACE | | | | BUS AMPS 400 | | | | MAIN BKR 400 | | | |
| FED FROM T-NLPD1 | | | | NEUTRAL 100% | | | | LUGS STANDARD | | | |
| NOTE SQUARE D NQ | | | | | | | | | | | |
| CKT # | CKT BKR | CIRCUIT DESCRIPTION | KVA LOAD | | | CKT # | CKT BKR | CIRCUIT DESCRIPTION | KVA LOAD | | |
| | | | A | B | C | | | | A | B | C |
| 1 | 20/1 | RECP, PT GYM #4013 | 0.72 | | | 2 | 20/1 | RECP, CUST. STOR. #2030, CUST. STOR. #2031 | 0.72 | | |
| 3 | 20/1 | RECP, PT GYM #4013 | | 0.54 | | 4 | 20/1 | RECP, CENT CORR WEST | | 0.72 | |
| 5 | 20/1 | RECP, PT GYM #4013 | | | 0.18 | 6 | 20/1 | RECP, CENT CORR WEST | | | 0.72 |
| 7 | 20/1 | RECP, PT GYM #4013 | 0.18 | | | 8 | 20/1 | RECP, CUST. CHARGING #3003 | 0.36 | | |
| 9 | 20/1 | RECP, PT GYM #4013 | | 0.18 | | 10 | 20/1 | RECP, CUST. CHARGING #3003 | | 0.36 | |
| 11 | 20/1 | RECP, PT GYM #4013 | | | 0.18 | 12 | 20/1 | RECP, CUST. CHARGING #3003 | | | 0.18 |
| 13 | 20/1 | RECP, PT GYM #4013 | 0.18 | | | 14 | 20/1 | RECP, #3005, OXYGEN #2028, STOR. #3006 | 1.44 | | |
| 15 | 20/1 | RECP, PT GYM #4013 | | 0.18 | | 16 | 20/1 | RECP, EQUIP. CHARGING #2024 | | 0.18 | |
| 17 | 20/1 | RECP, HALL #4008, PT GYM #4013 | | | 0.54 | 18 | 20/1 | RECP, EQUIP. CHARGING #2024 | | | 0.18 |
| 19 | 20/1 | RECP, PT OFFICE | 0.72 | | | 20 | 20/1 | RECP, EQUIP. CHARGING #2024 | 0.18 | | |
| 21 | 20/1 | RECP, PT OFFICE #4019 | | 0.72 | | 22 | 20/1 | RECP, EQUIP. CHARGING #2024 | | 0.18 | |
| 23 | 20/1 | RECP, KITCHEN #4020 | | | 0.36 | 24 | 20/1 | RECP, EQUIP. CHARGING #2024 | | | 0.18 |
| 25 | 20/1 | RECP, LTG, KITCHEN #4020 | 0.582 | | | 26 | 20/1 | RECP, EQUIP. CHARGING #2024 | 0.18 | | |
| 27 | 20/1 | RECP, LTG, TREATMENT #4012 | | 0.741 | | 28 | 20/1 | RECP, EQUIP. CHARGING #2024 | | 0.18 | |
| 29 | 20/1 | RECP, LTG, TREATMENT #4011 | | | 0.741 | 30 | 20/1 | RECP, EQUIP. CHARGING #2024 | | | 0.18 |
| 31 | 20/1 | RECP, LTG, TREATMENT #4010 | 0.741 | | | 32 | 20/1 | RECP, EQUIP. CHARGING #2024 | 0.18 | | |
| 33 | 20/1 | RECP, MEN #4002, UNISEX #4009, WOMEN #4004 | | 0.9 | | 34 | 20/1 | RECP, EQUIP. CHARGING #2024 | | | 0.18 |
| 35 | 20/1 | RECP, PT WAITING #4006 | | | 0.72 | 36 | 20/1 | RECP, #2034, LAUNDRY #2036, LINEN #2038, STOR. #2022 | | | 1.26 |
| 37 | 20/1 | RECP, PT RECEPTION #4007 | 0.9 | | | 38 | 20/1 | RECP, LTG, LOUNGE #3016 | 0.423 | | |
| 39 | 20/1 | RECP, MAN. #4029, SALON #4026, SERVICE #4030 | | 1.08 | | 40 | 20/1 | RECP, LTG, LOUNGE #3016 | | 1.2 | |
| 41 | 20/1 | RECP, SALON #4026 | | | 0.36 | 42 | 20/1 | GFCI BKR VEND-4, LOUNGE #3016 | | | 1.2 |
| 43 | 20/1 | RECP, SALON #4026 | 0.36 | | | 44 | 20/1 | GFCI BKR VEND-5, STAFF #3013 | 1.2 | | |
| 45 | 20/1 | RECP, SALON #4026 | | 0.36 | | 46 | 20/1 | RECP, LOUNGE #3016, STAFF #3013 | | 0.72 | |
| 47 | 20/1 | RECP, SALON #4026 | | | 0.5 | 48 | 20/1 | RECP, STAFF #3015, UNISEX STAFF SHOWER #3014 | | | 0.72 |
| 49 | 20/1 | RECP, SALON #4026 | 0.5 | | | 50 | 20/1 | RECP, #3022, CUST. #3024, LOUNGE #3015, WOMEN #3023 | 1.08 | | |
| 51 | 20/1 | RECP, SALON #4026 | | 0.5 | | 52 | 20/1 | RECP, LOUNGE #3019 | | 0.36 | |
| 53 | 20/1 | RECP, SPA CHANGING #4034, SPA ENTRY #4033 | | | 0.54 | 54 | 20/1 | RECP, CENT CORR WEST, RES. CORR. NORTH, STOR. #3018 | | | 0.9 |
| 55 | 20/1 | RECP, SPA BATHING #4036 | 0.72 | | | 56 | 20/1 | RECP | 0.54 | | |
| 57 | 20/1 | FP-1, SPA CHANGING #4034 | | 1.9 | | 58 | 20/1 | RECP, WORKSHOP #2001 | | 0.54 | |
| 59 | 20/1 | RECP, MECH #4048 | | | 0.54 | 60 | 20/1 | RECP, LOADING DOCK, RECEIVING #2003 | | | 0.72 |
| 61 | 20/1 | RECP, CHARTING #4045 | 0.54 | | | 62 | 20/1 | RECP, WAREHOUSE OFFICE #2007 | 0.72 | | |
| 63 | 20/1 | RECP, CHARTING #4045, MED. #4047 | | 0.36 | | 64 | 20/1 | RECP, STOR. #2008 | | 0.9 | |
| 65 | 20/1 | RECP, NURSING SUPPLY #4044 | | | 0.54 | 66 | 20/1 | RECP, CUST. CLOSET #2013, DONATION STOR. #2014 | | | 0.72 |
| 67 | 20/1 | RECP, DIR. OF NURSING OFFICE #4043 | 0.54 | | | 68 | 20/1 | RECP, CUST. OFFICE #2021 | 0.54 | | |
| 69 | 20/1 | RECP, FAMILY CONF. #4042 | | 0.54 | | 70 | 20/1 | RECP, DIR. OF MAINT. OFFICE #2020 | | 0.54 | |
| 71 | 20/1 | RECP, CENT CORR WEST | | | 0.72 | 72 | 20/1 | GFCI BKR VEND-1, ALCOVE #2015 | | | 1.2 |
| 73 | 20/1 | RECP, CENT CORR WEST | 0.36 | | | 74 | 20/1 | GFCI BKR VEND-2, ALCOVE #2015 | 1.2 | | |
| 75 | 20/1 | RECP, CENT CORR WEST | | 0.18 | | 76 | 20/1 | GFCI BKR VEND-3, ALCOVE #2015 | | 1.2 | |
| 77 | 20/1 | RECP, CENT CORR WEST | | | 0.18 | 78 | 20/1 | EW-1, CENT CORR WEST | | | 0.48 |
| 79 | 20/1 | RECP, CAFE #1016, CENT CORR WEST, ENTRY #1001 | 0.9 | | | 80 | 20/1 | RECP, CENT CORR WEST, CORR. #1040 | 1.26 | | |
| 81 | 20/1 | CP-1, PT RECEPTION #4007 | | 1.66 | | 82 | 20/1 | RECP, CENT CORR WEST, CORR. #1040 | | | 0.9 |
| 83 | 20/1 | RECP, CENT CORR WEST | | | 0.36 | 84 | 20/1 | RECP, MECH #1034, MECH 1035 | | | 0.72 |
| 85 | 20/1 | LTG, CENT CORR WEST | 0.048 | | | 86 | 20/1 | LTG, ALCOVE #2015 | 0.024 | | |
| 87 | /1 | SPACE | | 0 | | 88 | 20/1 | SPARE | | 0 | |
| 89 | 20/1 | LTG, RES. CORR. NORTH, RESIDENT WING F CORR. | | | 0.721 | 90 | 20/1 | RECP, EXTERIOR | | | 0.36 |
| 91 | 20/1 | LTG, LOUNGE #3019, RES. CORR. NORTH | 0.096 | | | 92 | 20/1 | SPARE | 0 | | |
| 93 | 20/1 | SPARE SPA BATH, SPA BATHING #4036 | | 0.1 | | 94 | 20/1 | SPARE | | 0 | 0 |
| 95 | 20/1 | RECP, MED. #4047 | | | 0.36 | 96 | 20/1 | SPARE | | | 0 |
| 97 | 20/1 | RECP, KITCHEN #4020 | 0.18 | | | 98 | 20/1 | SPARE | 0 | | |
| 99 | 20/1 | SPARE | | 0 | | 100 | 20/1 | SPARE | | 0 | 0 |
| 101 | 20/1 | SPARE | | | 0 | 102 | /1 | SPACE | | | 0 |
| 103 | 20/2 | RANGE, KITCHEN #4020 | 0.05 | | | 104 | /1 | SPACE | 0 | | |
| 105 | | | | 0.05 | | 106 | /1 | SPACE | | 0 | |
| 107 | /1 | SPACE | | | 0 | 108 | /1 | SPACE | | | 0 |
| 109 | /1 | SPACE | | | 0 | 110 | /1 | SPACE | | | 0 |
| 111 | /1 | SPACE | | | 0 | 112 | /1 | SPACE | | | 0 |
| 113 | /1 | SPACE | | | 0 | 114 | /1 | SPACE | | | 0 |
| 115 | /1 | SPACE | | | 0 | 116 | /1 | SPACE | 0 | | |
| 117 | /1 | SPACE | | | 0 | 118 | /1 | SPACE | | | 0 |
| 119 | /1 | SPACE | | | 0 | 120 | /1 | SPACE | | | 0 |
| 121 | 125/3 | NLPD2 | 15.2 | | | 122 | /1 | SPACE | | 0 | |
| 123 | | | | 12.8 | | 124 | /1 | SPACE | | | 0 |
| 125 | | | | | 11.9 | 126 | /1 | SPACE | | | 0 |
| TOTAL CONNECTED KVA BY PHASE | | | | | | | | | | | |
| | | | CONN. KVA | | | CALC. KVA | | | | | |
| LIGHTING | | | 1.52 | | 1.9 | (125%) | CONTINUOUS | | | 8.38 | 10.5 (125%) |
| LARGEST MOTOR | | | 1 | | 1.25 | (125%) | HEATING | | | 0 | 0 (100%) |
| OTHER MOTORS | | | 1.2 | | 1.2 | (100%) | NONCONTINUOUS | | | 7.92 | 7.92 (100%) |
| RECEPTACLES | | | 72 | | 41 | (50%-10) | KITCHEN EQUIP | | | 0 | 0 (N/A) |
| CONTINUOUS | | | 1.66 | | 0 | (0%) | NONCOIN/DIVERSE | | | 0 | 0 (N/A) |
| CONTINUOUS | | | 0 | | 0 | (0%) | TOTAL KVA | | | 93.7 | 63.7 |
| NORMAL BRANCH | | | | | | | | | | | |
| BALANCED THREE PHASE AMPS 177 | | | | | | | | | | | |

| NLPD2 | | | | | | | | | | | | | | |
|---------------------------|---------|--|-----------|---------------------------|------|-----------|-----------------|--|------------------------------|-------|-------------|------|------|------|
| ROOM ELECTRICAL ROOM H017 | | | | VOLTS 208Y/120V 3P 4W | | | | AIC 10k | | | | | | |
| MOUNTING SURFACE | | | | BUS AMPS 125 | | | | MAIN BKR 125 | | | | | | |
| FED FROM NLPD1 | | | | NEUTRAL 100% | | | | LUGS STANDARD | | | | | | |
| NOTE SQUARE D NQ | | | | | | | | | | | | | | |
| CKT # | CKT BKR | CIRCUIT DESCRIPTION | KVA LOAD | | | CKT # | CKT BKR | CIRCUIT DESCRIPTION | KVA LOAD | | | | | |
| | | | A | B | C | | | | A | B | C | | | |
| 1 | 20/1 | RECP, LOUNGE #5024 | 0.54 | | | 2 | 20/1 | RECP, ADMIN OFFICE #6018 | 0.54 | | | | | |
| 3 | 20/1 | RECP, RES. CORR. NORTH, RESIDENT WING G CORR. | | 1.26 | | 4 | 20/1 | RECP, ADMIN OFFICE #6019 | | 0.54 | | | | |
| 5 | 20/1 | RECP, RES. CORR. NORTH, RESIDENT WING G CORR. | | | 1.08 | 6 | 20/1 | RECP, UNISEX #6014, UNISEX #6015 | | | 0.36 | | | |
| 7 | 20/1 | RECP, LOUNGE #6014 | 0.9 | | | 8 | 20/1 | RECP, ACT. OFFICE #6009, ACT. STOR. #6010 | 0.72 | | | | | |
| 9 | 20/1 | RECP, LOUNGE #6014 | | 0.36 | | 10 | 20/1 | RECP, ACT. OFFICE #6009 | | 0.36 | | | | |
| 11 | 20/1 | LR-2, LOUNGE #6014 | | | 1.2 | 12 | 20/1 | RECP, ACT. OFFICE #6002 | | | 0.72 | | | |
| 13 | 20/1 | RECP, CUST. CLOSET #5016 | 0.36 | | | 14 | 20/1 | RECP, LTG, CENTRAL ACT. #6004 | 0.582 | | | | | |
| 15 | 20/1 | RECP, NURSING OFFICE #5027 | | 0.54 | | 16 | 20/1 | RECP, LTG, CENTRAL ACT. #6004 | | 0.603 | | | | |
| 17 | 20/1 | RECP, ED/MRS OFFICE #5026 | | | 0.54 | 18 | 20/1 | RECP, CENTRAL ACT. #6004, HALL #6001 | | | 0.9 | | | |
| 19 | 20/1 | RECP, UNIT CLERK #5025 | 0.54 | | | 20 | 20/1 | PS-1, PR-1, CENTRAL ACT. #6004 | 1 | | | | | |
| 21 | 20/1 | RECP, EQUIP. STOR. #5022, LINEN, SOILED LINEN #5021 | | 0.9 | | 22 | 20/1 | RECP, SMUDGING #6022 | | 0.72 | | | | |
| 23 | 20/1 | RECP, EQUIP. CHARGING #5019 | | | 0.18 | 24 | 20/1 | RECP, #6028, CUST. #6029, LAUNDRY #6026, LINEN #6027 | | | 1.26 | | | |
| 25 | 20/1 | RECP, EQUIP. CHARGING #5019 | 0.18 | | | 26 | 20/1 | RECP, ACT. STOR. #H019, RESIDENT WING H CORR. | 1.08 | | | | | |
| 27 | 20/1 | RECP, EQUIP. CHARGING #5019 | | 0.18 | | 28 | 20/1 | RECP, EQUIP. STOR. #H008, RESIDENT WING H CORR. | | 0.72 | | | | |
| 29 | 20/1 | RECP, EQUIP. CHARGING #5019 | | | 0.18 | 30 | 20/1 | RECP, MECH #H014 | | | 0.72 | | | |
| 31 | 20/1 | RECP, EQUIP. CHARGING #5019 | 0.18 | | | 32 | 20/1 | RECP, CONF. #K003 | 0.72 | | | | | |
| 33 | 20/1 | RECP, EQUIP. CHARGING #5019 | | 0.18 | | 34 | 20/1 | PR-2, PS-2, CONF. #K003 | | 1 | | | | |
| 35 | 20/1 | RECP, EQUIP. CHARGING #5019 | | | 0.18 | 36 | 20/1 | SPARE | | | 0 | | | |
| 37 | 20/1 | RECP, EQUIP. CHARGING #5019 | 0.18 | | | 38 | 30/2 | DR-S, LAUNDRY #6026 | 1.8 | 1.8 | | | | |
| 39 | 20/1 | RECP, EQUIP. CHARGING #5019 | | 0.18 | | 40 | 1 | SPARE | | | 0 | | | |
| 41 | 20/1 | RECP, EQUIP. CHARGING #5019 | | | 0.18 | 42 | 20/1 | SPARE | | | 0 | | | |
| 43 | 20/1 | RECP, EQUIP. CHARGING #5019 | 0.18 | | | 44 | 20/1 | WM-S, LAUNDRY #6026 | 1.92 | | | | | |
| 45 | 20/1 | RECP, EQUIP. CHARGING #5019 | | 0.18 | | 46 | 20/1 | SPARE | | 0 | | | | |
| 47 | 20/1 | RECP, EQUIP. CHARGING #5019 | | | 0.18 | 48 | 20/1 | SPARE | | | 0 | | | |
| 49 | 20/1 | RECP, EQUIP. CHARGING #5019 | 0.18 | | | 50 | 20/1 | SPARE | | 0 | | | | |
| 51 | 20/1 | RECP, MEN #5013, WOMEN #5014 | | 0.36 | | 52 | 20/1 | RECP, MED. #5010 | | | 0.36 | 0 | | |
| 53 | 20/1 | RECP, CHARTING #5008 | | | 0.54 | 54 | 20/1 | CEILING FANS, RM 6004 | | | | 0 | | |
| 55 | 20/1 | RECP, CHARTING #5008, MED. #5010 | 0.36 | | | 56 | 20/1 | RECP, ROOF | 0.54 | | | 0 | | |
| 57 | 20/1 | RECP, OXYGEN REFILL #5007 | | 0.36 | | 58 | 20/1 | SPARE | | | | 0 | | |
| 59 | 20/1 | RECP, MECH #5004 | | | 0.54 | 60 | 20/1 | SPARE | | | | 0 | | |
| 61 | 20/1 | RECP, SOCIAL WORK OFFICE #5002 | 0.54 | | | 62 | 20/1 | SPARE | | | | 0 | | |
| 63 | 20/1 | RECP, FIN. OFFICE #5003 | | 0.54 | | 64 | 20/1 | SPARE | | | | 0 | | |
| 65 | 20/1 | CP-2, COPY #5001 | | | 1.2 | 66 | 20/1 | SPARE | | | | 0 | | |
| 67 | 20/1 | RECP, COPY #5001 | | | 0.54 | 68 | 20/1 | SPARE | | | | 0 | | |
| 69 | 20/1 | RECP, COPY #5001 | 0.54 | | | 70 | 20/1 | SPARE | | | | 0 | | |
| 71 | 20/1 | RECP, CLINT. CORR. EAST, EQUIP. STOR. #H011, RESIDENT WING J CORR. | | | 1.44 | 72 | 20/1 | SPARE | | | | 0 | | |
| 73 | 20/1 | RECP, CLINT. CORR. WEST, CENT. CORR. EAST | 0.54 | | | 74 | 20/1 | SPARE | | | | 0 | | |
| 75 | 20/1 | RECP, CENT. CORR. EAST | | 0.72 | | 76 | 20/1 | SPARE | | | | 0 | | |
| 77 | 20/1 | RECP, CENT. CORR. WEST, CENT. CORR. EAST | | | 0.54 | 78 | 20/1 | SPARE | | | | 0 | | |
| 79 | 20/1 | RECP, CENT. CORR. EAST, RESIDENT WING I CORR. | 1.08 | | | 80 | 20/1 | SPARE | | | | 0 | | |
| 81 | 20/1 | LTG, CENT. CORR. EAST, CENTRAL ACT. #6004, CONF. #H001, #H020, RESIDENT WING I CORR., SANITARY #6003, SMUDGING #6022 | | 0.36 | | 82 | 20/1 | SPARE | | | | 0 | | |
| 83 | 20/1 | SPARE | | | 0 | 84 | 20/1 | SPARE | | | | 0 | | |
| | | | | | | | | | TOTAL CONNECTED KVA BY PHASE | | | 15.2 | 12.8 | 11.9 |
| CONN. KVA | | | CAIC. KVA | | | CONN. KVA | | | CAIC. KVA | | | | | |
| LIGHTING | | | 0.465 | 0.581 (125%) | | | CONTINUOUS | | | 0 | 0 (125%) | | | |
| LARGEST MOTOR | | | 1 | 1.25 (125%) | | | HEATING | | | 0 | 0 (100%) | | | |
| OTHER MOTORS | | | 1 | 1.1 (100%) | | | NONCONTINUOUS | | | 6.72 | 6.72 (100%) | | | |
| RECFACILES | | | 30.7 | 10.4 (50%) | | | KITCHEN EQUIP | | | 0 | 0 (N/A) | | | |
| CONTINUOUS | | | 0 | 0 (0%) | | | NONCONC/DIVERSE | | | 0 | 0 (N/A) | | | |
| CONTINUOUS | | | 0 | 0 (0%) | | | TOTAL KVA | | | 39.9 | 29.9 | | | |
| NORMAL BRANCH | | | | BALANCED THREE PHASE APPX | | | | 83 | | | | | | |

| CRLPA1 | | | | | | | | | | | | | | |
|--------------------------------|---------|--|---------------|-----------------------|------------------|-------|---------|--|------------------------------|---|-------------|------|------|------|
| ROOM ELECTRICAL ROOM E032 | | | | VOLTS 208Y/120V 3P 4W | | | | AIC 10k | | | | | | |
| MOUNTING SURFACE | | | | BUS AMPS 225 | | | | MAIN BKR 225 | | | | | | |
| FED FROM T-CRLPA1 | | | | NEUTRAL 100% | | | | LUGS STANDARD | | | | | | |
| NOTE SQUARE D NQ | | | | | | | | | | | | | | |
| CKT # | CKT BKR | CIRCUIT DESCRIPTION | KVA LOAD | | | CKT # | CKT BKR | CIRCUIT DESCRIPTION | KVA LOAD | | | | | |
| | | | A | B | C | | | | A | B | C | | | |
| 1 | 125/3 | SPARE | 0 | | | 2 | 20/1 | RECP | 0.18 | | | | | |
| 3 | I | | | 0 | | 4 | 20/1 | RECP, RES. CORR. NORTH | 0.36 | | | | | |
| 5 | I | | | | 0 | 6 | 20/1 | TC-1, RES. CORR. NORTH | | | 0.2 | | | |
| 7 | 125/3 | SPARE | 0 | | | 8 | 20/1 | RECP, RES. CORR. NORTH | 0.18 | | | | | |
| 9 | I | | | 0 | | 10 | /1 | SPACE | 0 | | | | | |
| 11 | I | | | | | 12 | /1 | SPACE | | | 0 | | | |
| 13 | 20/1 | RECP, RESIDENT RM. #E013 | 0.36 | | | 14 | 20/1 | RECP, RESIDENT RM. #E005 | 0.36 | | | | | |
| 15 | 20/1 | LC, RESIDENT RM. #E013 | 0.12 | | | 16 | 20/1 | LC, RESIDENT RM. #E005 | 0.12 | | | | | |
| 17 | 20/1 | LTG, RES. CORR. NORTH, RESIDENT RM. #E013 | | | 0.165 | 18 | 20/1 | LTG, RESIDENT RM. #E005 | | | 0.153 | | | |
| 19 | 20/1 | RECP, RESIDENT RM. #E011 | 0.36 | | | 20 | 20/1 | RECP, RESIDENT RM. #E006 | 0.36 | | | | | |
| 21 | 20/1 | LC, RESIDENT RM. #E011 | | | 0.12 | 22 | 20/1 | LC, RESIDENT RM. #E006 | 0.12 | | | | | |
| 23 | 20/1 | LTG, RESIDENT RM. #E011, RESIDENT WING E CORR. | | | 0.165 | 24 | 20/1 | LTG, RESIDENT RM. #E006 | | | 0.148 | | | |
| 25 | 20/1 | RECP, RESIDENT RM. #E009 | 0.36 | | | 26 | 20/1 | RECP, RESIDENT RM. #E006 | 0.36 | | | | | |
| 27 | 20/1 | LC, RESIDENT RM. #E009 | | | 0.12 | 28 | 20/1 | LC, RESIDENT RM. #E006 | 0.12 | | | | | |
| 29 | 20/1 | LTG, RESIDENT RM. #E009, RESIDENT WING E CORR. | | | 0.165 | 30 | 20/1 | LTG, RESIDENT RM. #E006, RESIDENT WING E CORR. | | | 0.126 | | | |
| 31 | 20/1 | RECP, RESIDENT RM. #E007 | 0.36 | | | 32 | 20/1 | RECP, RESIDENT RM. #E008 | 0.36 | | | | | |
| 33 | 20/1 | LC, RESIDENT RM. #E007 | | | 0.12 | 34 | 20/1 | LC, RESIDENT RM. #E008 | 0.12 | | | | | |
| 35 | 20/1 | LTG, RESIDENT RM. #E007, RESIDENT WING E CORR. | | | 0.165 | 36 | 20/1 | LTG, RESIDENT RM. #E008, RESIDENT WING E CORR. | | | 0.165 | | | |
| 37 | 20/1 | RECP, RESIDENT RM. #E005 | 0.36 | | | 38 | 20/1 | RECP, RESIDENT RM. #E010 | 0.36 | | | | | |
| 39 | 20/1 | LC, RESIDENT RM. #E005 | | | 0.12 | 40 | 20/1 | LC, RESIDENT RM. #E010 | 0.12 | | | | | |
| 41 | 20/1 | LTG, RESIDENT RM. #E005, RESIDENT WING E CORR. | | | 0.121 | 42 | 20/1 | LTG, RESIDENT RM. #E010, RESIDENT WING E CORR. | | | 0.165 | | | |
| 43 | 20/1 | RECP, RESIDENT RM. #F013 | 0.36 | | | 44 | 20/1 | RECP, RESIDENT RM. #F014 | 0.36 | | | | | |
| 45 | 20/1 | LC, RESIDENT RM. #F013 | | | 0.12 | 46 | 20/1 | LC, RESIDENT RM. #F014 | 0.12 | | | | | |
| 47 | 20/1 | LTG, RESIDENT RM. #F013, RESIDENT WING F CORR. | | | 0.165 | 48 | 20/1 | LTG, RESIDENT RM. #F014 | | | 0.114 | | | |
| 49 | 20/1 | RECP, RESIDENT RM. #F011 | 0.36 | | | 50 | 20/1 | RECP, RESIDENT RM. #F014 | 0.36 | | | | | |
| 51 | 20/1 | LC, RESIDENT RM. #F011 | | | 0.12 | 52 | 20/1 | LC, RESIDENT RM. #F014 | 0.12 | | | | | |
| 53 | 20/1 | LTG, RESIDENT RM. #F011, RESIDENT WING F CORR. | | | 0.165 | 54 | 20/1 | LTG, RESIDENT RM. #F014, RESIDENT WING F CORR. | | | 0.16 | | | |
| 55 | 20/1 | RECP, RESIDENT RM. #F007 | 0.36 | | | 56 | 20/1 | RECP, CNA ALCOVE #F019 | 0.36 | | | | | |
| 57 | 20/1 | LC, RESIDENT RM. #F007 | | | 0.12 | 58 | 20/1 | TC-2, CNA ALCOVE #F019 | 0.2 | | | | | |
| 59 | 20/1 | LTG, RESIDENT RM. #F007 | 0.148 | | | 60 | 20/1 | RECP, CNA ALCOVE #F019 | | | 0.18 | | | |
| 61 | 20/1 | RECP, RESIDENT RM. #F007 | 0.36 | | | 62 | 20/1 | NCC-1, CHARTING #4045 | 0.2 | | | | | |
| 63 | 20/1 | LC, RESIDENT RM. #F007 | | | 0.12 | 64 | 20/1 | RECP, CHARTING #4045 | 0.54 | | | | | |
| 65 | 20/1 | LTG, RESIDENT RM. #F007, RESIDENT WING F CORR. | | | 0.126 | 66 | 20/1 | RECP, CHARTING #4045, MED. #4047 | | | 0.36 | | | |
| 67 | 20/1 | RECP, RESIDENT RM. #F006 | 0.36 | | | 68 | 20/1 | RECP, CHARTING #4045 | 0.18 | | | | | |
| 69 | 20/1 | LC, RESIDENT RM. #F006 | | | 0.12 | 70 | 20/1 | SPARE | 0 | | | | | |
| 71 | 20/1 | LTG, RESIDENT RM. #F006, RESIDENT WING F CORR. | | | 0.165 | 72 | 20/1 | MD-1, MED. #4047 | | | 0.8 | | | |
| 73 | 20/1 | RECP, RESIDENT RM. #F010 | 0.36 | | | 74 | 20/1 | RECP, NURSING SUPPLY #4044 | 0.54 | | | | | |
| 75 | 20/1 | LC, RESIDENT RM. #F010 | | | 0.12 | 76 | 20/1 | RECP, DIR. OF NURSING OFFICE #4043 | 0.18 | | | | | |
| 77 | 20/1 | LTG, RESIDENT RM. #F010, RESIDENT WING F CORR. | | | 0.165 | 78 | 20/1 | RECP, MECH #4048 | 0.18 | | 0.18 | | | |
| 79 | 20/1 | RECP, RESIDENT RM. #F012 | 0.36 | | | 80 | 20/1 | RECP, CENT CORR WEST | 0.18 | | | | | |
| 81 | 20/1 | LC, RESIDENT RM. #F012 | | | 0.12 | 82 | 20/1 | RECP, CENT CORR WEST | 0.18 | | | | | |
| 83 | 20/1 | LTG, RESIDENT RM. #F012, RESIDENT WING F CORR. | | | 0.165 | 84 | 20/1 | RECP, DIR. OF MAINT. OFFICE #2020 | | | 0.18 | | | |
| 85 | 20/1 | RECP, MECH #1034, MECH 1035 | 0.36 | | | 86 | 20/1 | RECP, CUST. OFFICE #2021 | 0.18 | | | | | |
| 87 | 20/1 | RECP, ELEC. #1037 | | | 0.36 | 88 | 20/1 | RECP, ELEC. #2029 | 0.18 | | | | | |
| 89 | 20/1 | RECP, ELEC. #1038 | | | 0.36 | 90 | 20/1 | UV LGT, MECH #4048 | | | 0.1 | | | |
| 91 | 20/1 | RECP, TREATMENT #4012 | 0.18 | | | 92 | 20/1 | TCC, MECH #4048 | 0.1 | | | | | |
| 93 | 20/1 | RECP, TREATMENT #4011 | | | 0.18 | 94 | 20/2 | TC AC-1, TELECOM #3001 | 0.05 | | | | | |
| 95 | 20/1 | RECP, TREATMENT #4010 | | | 0.18 | 96 | I | | 0.05 | | 0.05 | | | |
| 97 | 20/1 | RECP, HALL #4008 | 0.18 | | | 98 | 20/1 | TIME CLOCK, STAFF #3013 | 0.2 | | | | | |
| 99 | 20/1 | RECP, PT OFFICE | | | 0.18 | 100 | 20/1 | SPARE | 0 | | | | | |
| 101 | 20/1 | RECP, PT OFFICE #4019 | | | 0.18 | 102 | 20/1 | SPARE | 0 | | | | | |
| 103 | 20/1 | LC, SPA TOILET #4035 | | | 0.12 | 104 | 20/1 | QC LIGHTS DRIVER E WING | 0.1 | | | | | |
| 105 | 20/1 | SPARE | 0 | | | 106 | 20/1 | QC LIGHTS DRIVER F WING | 0.1 | | | | | |
| 107 | 20/1 | SPARE | 0 | | | 108 | /1 | SPACE | | | 0 | | | |
| 109 | 20/1 | SPARE | 0 | | | 110 | /1 | SPACE | 0 | | | | | |
| 111 | 20/1 | SPARE | 0 | | | 112 | /1 | SPACE | 0 | | | | | |
| 113 | 20/1 | SPARE | 0 | | | 114 | /1 | SPACE | 0 | | | | | |
| 115 | 20/1 | SPARE | 0 | | | 116 | /1 | SPACE | 0 | | | | | |
| 117 | /1 | SPACE | 0 | | | 118 | /1 | SPACE | 0 | | | | | |
| 119 | /1 | SPACE | 0 | | | 120 | /1 | SPACE | 0 | | | | | |
| 121 | /1 | SPACE | 0 | | | 122 | /1 | SPACE | 0 | | | | | |
| 123 | /1 | SPACE | 0 | | | 124 | /1 | SPACE | 0 | | | | | |
| 125 | /1 | SPACE | 0 | | | 126 | /1 | SPACE | 0 | | | | | |
| | | | | | | | | | TOTAL CONNECTED KVA BY PHASE | | | 10.1 | 4.79 | 5.68 |
| | | | CONN. KVA | | CALC. KVA | | | | CONN. KVA | | CALC. KVA | | | |
| | | | 2.91 | | 3.64 (125%) | | | | 2.6 | | 3.25 (125%) | | | |
| | | | LARGEST MOTOR | | 0.2 0.25 (125%) | | | | HEATING | | 0 0 (100%) | | | |
| | | | OTHER MOTORS | | 0.9 0.9 (100%) | | | | NONCONTINUOUS | | 0 0 (100%) | | | |
| | | | RECEPTACLES | | 12 13.9 (50%>10) | | | | KITCHEN EQUIP | | 0 0 (N/A) | | | |
| | | | CONTINUOUS | | 0 0 (0%) | | | | NONCON/DIVERSE | | 0 0 (N/A) | | | |
| | | | CONTINUOUS | | 0 0 (0%) | | | | TOTAL KVA | | 20.6 20 | | | |
| BALANCED THREE PHASE AMPS 55.5 | | | | | | | | | | | | | | |
| CRITICAL BRANCH | | | | | | | | | | | | | | |

| CRLPB1 | | | | | | | | | | | |
|------------------------------|---------|--|---------------------------|-----------------------|------|-----------------|---------|--|------------|-------|------|
| ROOM ELECTRICAL ROOM H017 | | | | VOLTS 208Y/120V 3P 4W | | | | AIC 10K | | | |
| MOUNTING SURFACE | | | | BUS AMPS 225 | | | | MAIN BKR 225 | | | |
| FED FROM T-CRLPB1 | | | | NEUTRAL 100% | | | | LUGS STANDARD | | | |
| NOTE SQUARE D NQ | | | | | | | | | | | |
| CKT # | CKT BKR | CIRCUIT DESCRIPTION | KVA LOAD | | | CKT # | CKT BKR | CIRCUIT DESCRIPTION | KVA LOAD | | |
| | | | A | B | C | | | | A | B | C |
| 1 | 20/1 | RECP, RESIDENT RM. #G013 | 0.36 | | | 2 | 20/1 | RECP, RESIDENT RM. #G010 | 0.36 | | |
| 3 | 20/1 | LC, RESIDENT RM. #G013 | 0.12 | | | 4 | 20/1 | LC, RESIDENT RM. #G010 | 0.12 | | |
| 5 | 20/1 | LTG, RESIDENT RM. #G013 | | 0.114 | | 6 | 20/1 | LTG, RESIDENT RM. #G010, RESIDENT WING G CORR. | | 0.165 | |
| 7 | 20/1 | RECP, RESIDENT RM. #G013 | 0.36 | | | 8 | 20/1 | RECP, RESIDENT RM. #G012 | 0.36 | | |
| 9 | 20/1 | LC, RESIDENT RM. #G013 | | 0.12 | | 10 | 20/1 | LC, RESIDENT RM. #G012 | 0.12 | | |
| 11 | 20/1 | LTG, RESIDENT RM. #G013, RESIDENT WING G CORR. | | 0.16 | | 12 | 20/1 | LTG, RESIDENT RM. #G012, RESIDENT WING G CORR. | | 0.165 | |
| 13 | 20/1 | RECP, RESIDENT RM. #G011 | 0.36 | | | 14 | 20/1 | RECP, RESIDENT RM. #H013 | 0.36 | | |
| 15 | 20/1 | LC, RESIDENT RM. #G011 | | 0.12 | | 16 | 20/1 | LC, RESIDENT RM. #H013 | 0.12 | | |
| 17 | 20/1 | LTG, RESIDENT RM. #G011, RESIDENT WING G CORR. | | 0.165 | | 18 | 20/1 | LTG, RESIDENT RM. #H013, RESIDENT WING H CORR. | | 0.165 | |
| 19 | 20/1 | RECP, RESIDENT RM. #G009 | 0.36 | | | 20 | 20/1 | RECP, RESIDENT RM. #H011 | 0.36 | | |
| 21 | 20/1 | LC, RESIDENT RM. #G009 | | 0.12 | | 22 | 20/1 | LC, RESIDENT RM. #H011 | 0.12 | | |
| 23 | 20/1 | LTG, RESIDENT RM. #G009, RESIDENT WING G CORR. | | 0.165 | | 24 | 20/1 | LTG, RESIDENT RM. #H011, RESIDENT WING H CORR. | | 0.165 | |
| 25 | 20/1 | RECP, RESIDENT RM. #G005 | 0.36 | | | 26 | 20/1 | RECP, RESIDENT RM. #H009 | 0.36 | | |
| 27 | 20/1 | LC, RESIDENT RM. #G005 | | 0.12 | | 28 | 20/1 | LC, RESIDENT RM. #H009 | 0.12 | | |
| 29 | 20/1 | LTG, RESIDENT RM. #G005, RESIDENT WING G CORR. | | 0.165 | | 30 | 20/1 | LTG, RESIDENT RM. #H009, RESIDENT WING H CORR. | | 0.165 | |
| 31 | 20/1 | RECP, RESIDENT RM. #G006 | 0.36 | | | 32 | 20/1 | RECP, RESIDENT RM. #H005 | 0.36 | | |
| 33 | 20/1 | LC, RESIDENT RM. #G006 | | 0.12 | | 34 | 20/1 | LC, RESIDENT RM. #H005 | 0.12 | | |
| 35 | 20/1 | LTG, RESIDENT RM. #G006, RESIDENT WING G CORR. | | 0.165 | | 36 | 20/1 | LTG, RESIDENT RM. #H005, RESIDENT WING H CORR. | | 0.165 | |
| 37 | 20/1 | RECP, RESIDENT RM. #G008 | 0.36 | | | 38 | 20/1 | RECP, RESIDENT RM. #H006 | 0.36 | | |
| 39 | 20/1 | LC, RESIDENT RM. #G008 | | 0.12 | | 40 | 20/1 | LC, RESIDENT RM. #H006 | 0.12 | | |
| 41 | 20/1 | LTG, RESIDENT RM. #G008, RESIDENT WING G CORR. | | 0.165 | | 42 | 20/1 | LTG, RESIDENT RM. #H006 | | 0.109 | |
| 43 | 20/1 | RECP, NURSING OFFICE #5027 | 0.18 | | | 44 | 20/1 | RECP, RESIDENT RM. #H006 | 0.36 | | |
| 45 | 20/1 | RECP, EDWARDS OFFICE #5026 | | 0.18 | | 46 | 20/1 | LC, RESIDENT RM. #H006 | 0.12 | | |
| 47 | 20/1 | RECP, UNIT CLERK #5025 | | 0.18 | | 48 | 20/1 | LTG, RESIDENT RM. #H006, RESIDENT WING H CORR. | | 0.165 | |
| 49 | 20/1 | RECP, SOCIAL WORK OFFICE #5002 | 0.18 | | | 50 | 20/1 | RECP, RESIDENT RM. #H010 | 0.36 | | |
| 51 | 20/1 | RECP, FIN. OFFICE #5003 | | 0.18 | | 52 | 20/1 | LC, RESIDENT RM. #H010 | 0.12 | | |
| 53 | 20/1 | RECP, MECH #5004 | | 0.18 | | 54 | 20/1 | LTG, RESIDENT RM. #H010, RESIDENT WING H CORR. | | 0.165 | |
| 55 | 20/1 | RECP, CHARTING #5008 | 0.54 | | | 56 | 20/1 | RECP, RESIDENT RM. #H012 | 0.36 | | |
| 57 | 20/1 | RECP, CHARTING #5008 | | 0.18 | | 58 | 20/1 | LC, RESIDENT RM. #H012 | 0.12 | | |
| 59 | 20/1 | RECP, CHARTING #5008, MED. #5010 | | 0.36 | 0.60 | 60 | 20/1 | LTG, RESIDENT RM. #H012, RESIDENT WING H CORR. | | 0.165 | |
| 61 | 20/1 | SPARE | | 0 | 0 | 62 | 20/1 | SPARE | | 0 | 0 |
| 63 | 20/1 | MD-2, MED. #5010 | | 0.8 | 0.64 | 64 | 20/1 | RECP, CNA ALCOVE #H021 | 0 | 0.36 | 0.56 |
| 65 | 20/1 | RECP, MECH #H014 | | 0.18 | 0.66 | 66 | 20/1 | RECP, TC-4, CNA ALCOVE #H021 | | | |
| 67 | 20/1 | NCC-2, CHARTING #5008 | 0.2 | | | 68 | 20/1 | RECP, RES. CORR. NORTH | 0.36 | | |
| 69 | 20/1 | LV LITS, MECH #H014 | | 0.1 | | 70 | 20/1 | RECP, RES. CORR. NORTH | | 0.2 | |
| 71 | 20/1 | TCC, MECH #H014 | | 0.1 | 0.1 | 72 | 20/1 | RECP, RES. CORR. NORTH | | 0.36 | |
| 73 | 20/1 | QC LIGHTS DRIVER F WING | | 0.1 | | 74 | 20/1 | RECP, ELEC. #H017 | 0.18 | | |
| 75 | 20/1 | QC LIGHTS DRIVER H WING | | 0.1 | | 76 | 20/1 | LTG, CNA ALCOVE #H021 | | 0.024 | |
| 77 | 20/1 | SPARE | | 0 | 0 | 78 | 20/1 | SPARE | | 0 | 0 |
| 79 | 20/1 | SPARE | | 0 | 0 | 80 | 20/1 | SPARE | 0 | | |
| 81 | 20/1 | SPARE | | 0 | 0 | 82 | 20/1 | SPARE | | 0 | 0 |
| 83 | 20/1 | SPARE | | 0 | 0 | 84 | 20/1 | SPARE | | 0 | 0 |
| TOTAL CONNECTED KVA BY PHASE | | | | | | | | | 7.86 | 4.16 | 4.61 |
| CONN. KVA | | | CALC. KVA | | | CONN. KVA | | | CALC. KVA | | |
| LIGHTING | | | 2.72 | | | 2.24 | | | 2.8 (125%) | | |
| LARGEST MOTOR | | | 0.2 | | | HEATING | | | 0 (100%) | | |
| OTHER MOTORS | | | 0.6 | | | NONCONTINUOUS | | | 0 (100%) | | |
| RECFEACES | | | 10.4 (506%-10) | | | KITCHEN EQUIP | | | 0 (N/A) | | |
| CONTINUOUS | | | 0 (0%) | | | NONCONC/DIVERSE | | | 0 (N/A) | | |
| CONTINUOUS | | | 0 (0%) | | | TOTAL KVA | | | 16.6 17.5 | | |
| CRITICAL BRANCH | | | BALANCED THREE PHASE AMPS | | | 48.5 | | | | | |

Oneida Nation - Engineering Department
Proposal Form

OCHC Satellite Pharmacy #16-013

Proposal Submission Date: **Before 3:30 PM on July 21, 2017**

Email the completed Proposal Form (as a PDF File) to:

To: Paul Witek, Senior Tribal Architect
pwitek@oneidanation.org

Fawn Cottrell, Contract Processor
fcottrel@oneidanation.org

Submitted by:

Company Name:

Full Address:

Telephone:

E-Mail Address:

Oneida Nation - Engineering Department

Proposal Form

OCHC Satellite Pharmacy #16-013

| | | |
|--|---|-------------------------------------|
| 1. | Identify the makeup of the firms on the team that will be utilized on this project, including any consultants or subcontractors that will be included as part of the team (<i>attach additional sheets if necessary</i>). | |
| Firm Name: | | Description of services provided: |
| | | Architectural Design |
| | | General Construction/Design-Builder |
| | | Fire Protection Design-Build |
| | | Plumbing Design-Build |
| | | HVAC Design-Build |
| | | Electrical Design-Build |
| | | |
| | | |
| 2. | Has your firm previously completed a construction contract for the Oneida Nation? (Yes or No). | |
| If Yes, List projects and year completed (<i>attach additional sheets if necessary</i>). | | |
| | | |

Oneida Nation - Engineering Department

Proposal Form

OCHC Satellite Pharmacy #16-013

| | |
|----|---|
| 3. | Denote examples of past commissions of the type and scale to the present project. (<i>attach additional sheets if necessary</i>). |
| | Completed by the Design-Build Team. |

Specifically identify pharmacy projects.

Oneida Nation - Engineering Department

Proposal Form

OCHC Satellite Pharmacy #16-013

| | | |
|-------------------------------|---|---|
| 4. | Identify the following relative to the Oneida Indian Preference Law (<i>attach additional sheets if necessary</i>): | |
| a. | <ol style="list-style-type: none"> 1. Denote the total numbers of management and design employees that will be assigned to this project under the contract (including consultant employees) and identify their title. Under Tribal affiliation indicate employees proposed to be assigned to the contract that are: enrolled members of the Oneida Nation, First generation descendants of an enrolled member of the Oneida Nation, or enrolled members of other federally-recognized Indian tribes. 2. IDENTIFY ALL MEMBERS OF THE MANGEMENT AND DESIGN STAFF WHETHER TRIBAL OR NON-TRIBAL. Do not include construction field personnel, other than Project Manager and Superintendent. 3. Attach a copy of Tribal Id's for any individuals denoted below with a tribal affiliation. | |
| Number of Positions assigned: | Firm Name & Position Title: | Tribal Affiliation (include person name if tribal): |
| <i>Examples:</i> | <i>Examples:</i> | <i>Examples:</i> |
| 1 | ABC Architects - Project Architect | Joe Native – Oneida |
| 2 | ABC Architects - Architectural Drafter | Non-tribal |
| 1 | DEF Engineers – Structural Engineer | Sue American – Menominee |
| 1 | GHI Contractors – Project Manager | Non-tribal |
| 1 | GHI Contractors – Superintendent | Fred Sun - Oneida |
| | | |
| | | |
| ? | TOTAL number of employees assigned under this contract (as noted above). | |

Oneida Nation - Engineering Department

Proposal Form

OCHC Satellite Pharmacy #16-013

| | | | |
|----|---|--|--|
| b. | 1. All firms proposed to be utilized on the contract that is: certified as an Indian-owned Business by the Oneida Indian Preference Department. Fill in the table below to include: all firms included in your proposal, general title of their scope of work, and what percentage of the total scope that firm will be responsible for completing. | | |
| | Firm Name: | Certified Indian-Owned (yes or no): | Scope of Work |
| | <i>Examples:</i> ABC Architects DEF Company GHI Contractors | <i>Examples:</i> No Yes No | <i>Examples:</i> Architectural Design HVAC Design & Construction General Construction |
| | | | <i>Examples:</i> 5% 10% 85% |
| | | | |
| | | | |
| | | |
|----|---|--|
| 5. | Identify professional references (name, address, phone number). | |
| | | |
| | | |

Oneida Nation - Engineering Department
Proposal Form

OCHC Satellite Pharmacy #16-013

| | | | |
|-------------|---|---|----|
| 6. | Identify the firm's Guaranteed Maximum Price (GMP) value: | | |
| Division 01 | General Requirements | | \$ |
| Division 02 | Existing Conditions | | \$ |
| Division 03 | Concrete | | \$ |
| Division 04 | Masonry | | \$ |
| Division 05 | Metals | | \$ |
| Division 06 | Wood, Plastics, and Composites | | \$ |
| Division 07 | Thermal and Moisture Protection | | \$ |
| Division 08 | Openings | | \$ |
| Division 09 | Finishes | | \$ |
| Division 10 | Specialties | | \$ |
| Division 11 | Equipment | | \$ |
| Division 12 | Furnishings | | \$ |
| Division 21 | Fire Suppression | | \$ |
| Division 22 | Plumbing | | \$ |
| Division 23 | Heating, Ventilating, and Air Conditioning | | \$ |
| Division 25 | Integrated Automation | | \$ |
| Division 26 | Electrical | | \$ |
| Division 27 | Communications | | \$ |
| Division 28 | Electronic Safety and Security | | \$ |
| | GMP Contingency | | \$ |
| | Design-Builder Fee | % | \$ |
| | | | |
| | Total GMP: | | \$ |

(Signature - Authorized signing officer)

 Date

(Printed Name and Title)